
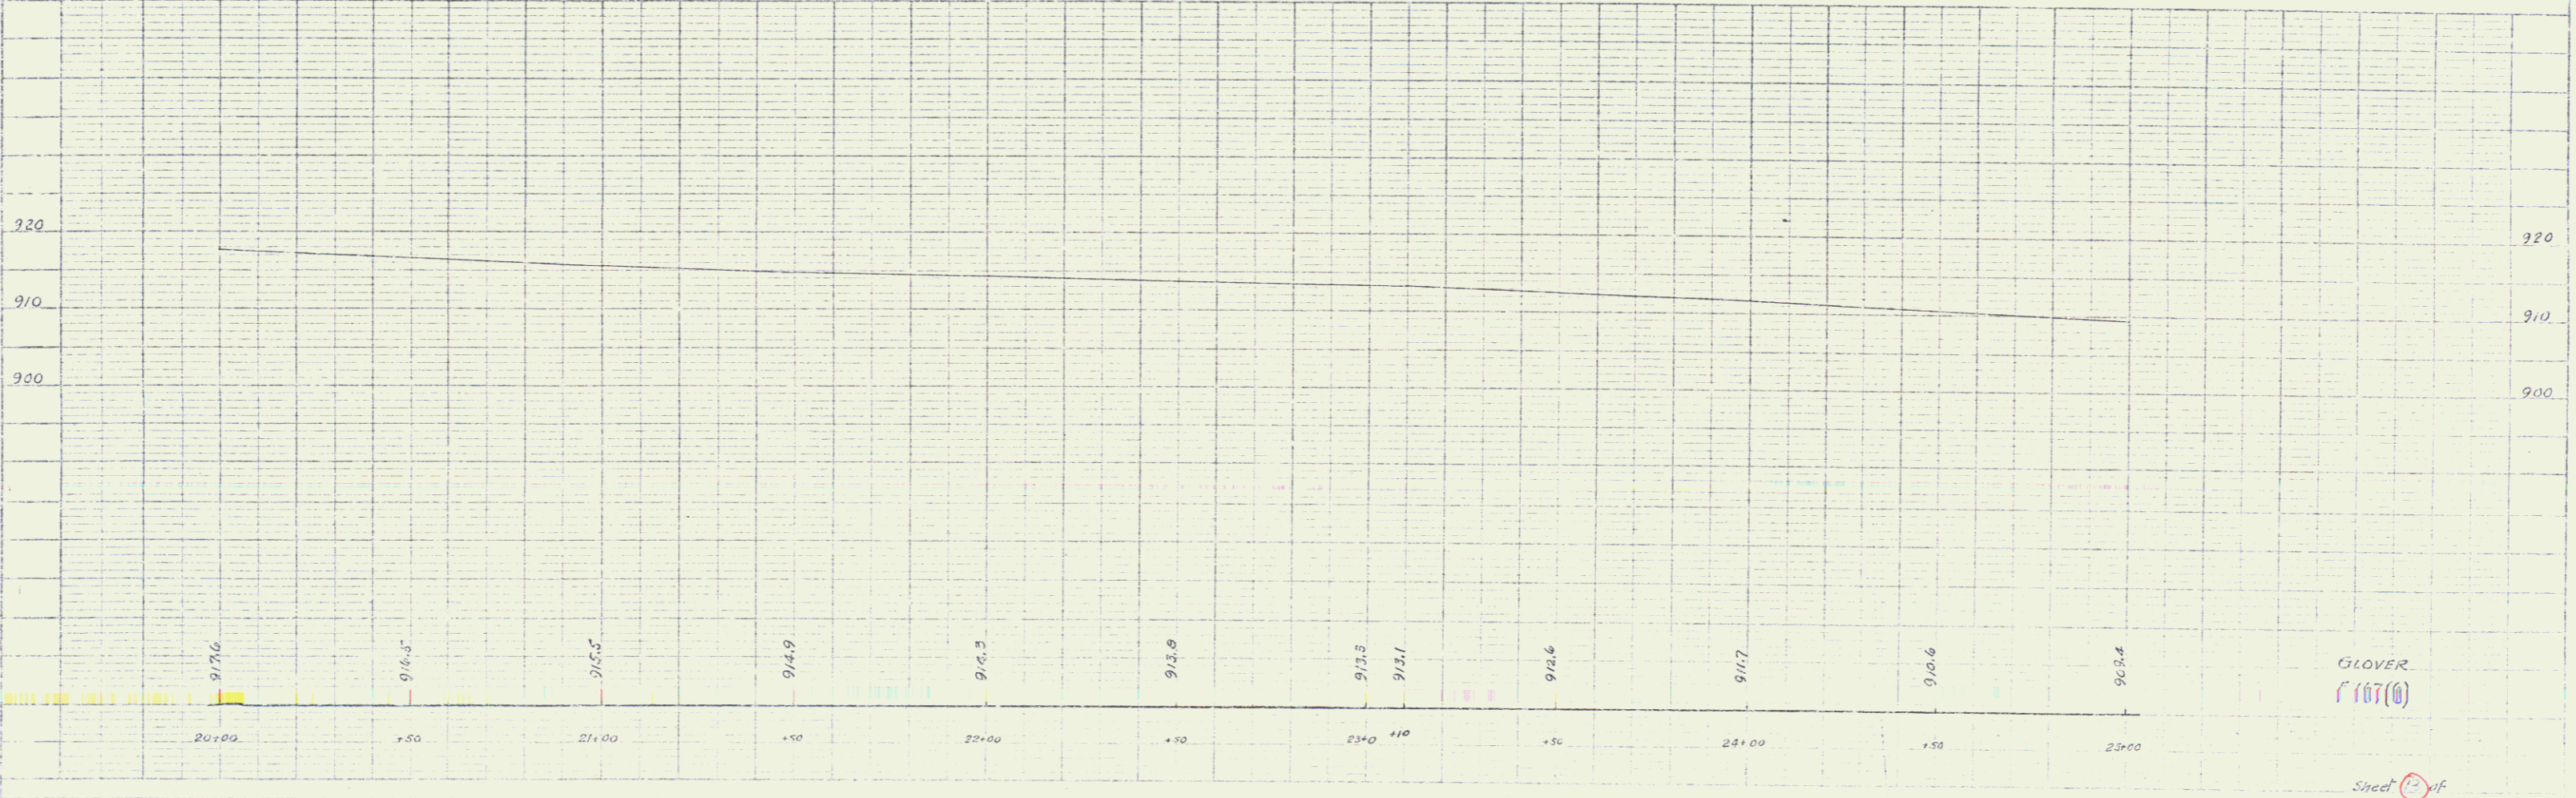


PLAN  
 DATE 10/18/79  
 DRAWN BY J. D. GLOVER  
 CHECKED BY J. D. GLOVER  
 SCALE 1" = 50'

PLAN  
 DATE 10/18/79  
 DRAWN BY J. D. GLOVER  
 CHECKED BY J. D. GLOVER  
 SCALE 1" = 50'

CURVE  
 $\Delta = 13^{\circ} - 22' - 22''$  LT.  
 $D = 3^{\circ}$   
 $R = 1910.1'$   
 $T = 223.8'$   
 $L = 445.6'$   
 $E = 13.1'$   
 $2T-L = 2.0'$

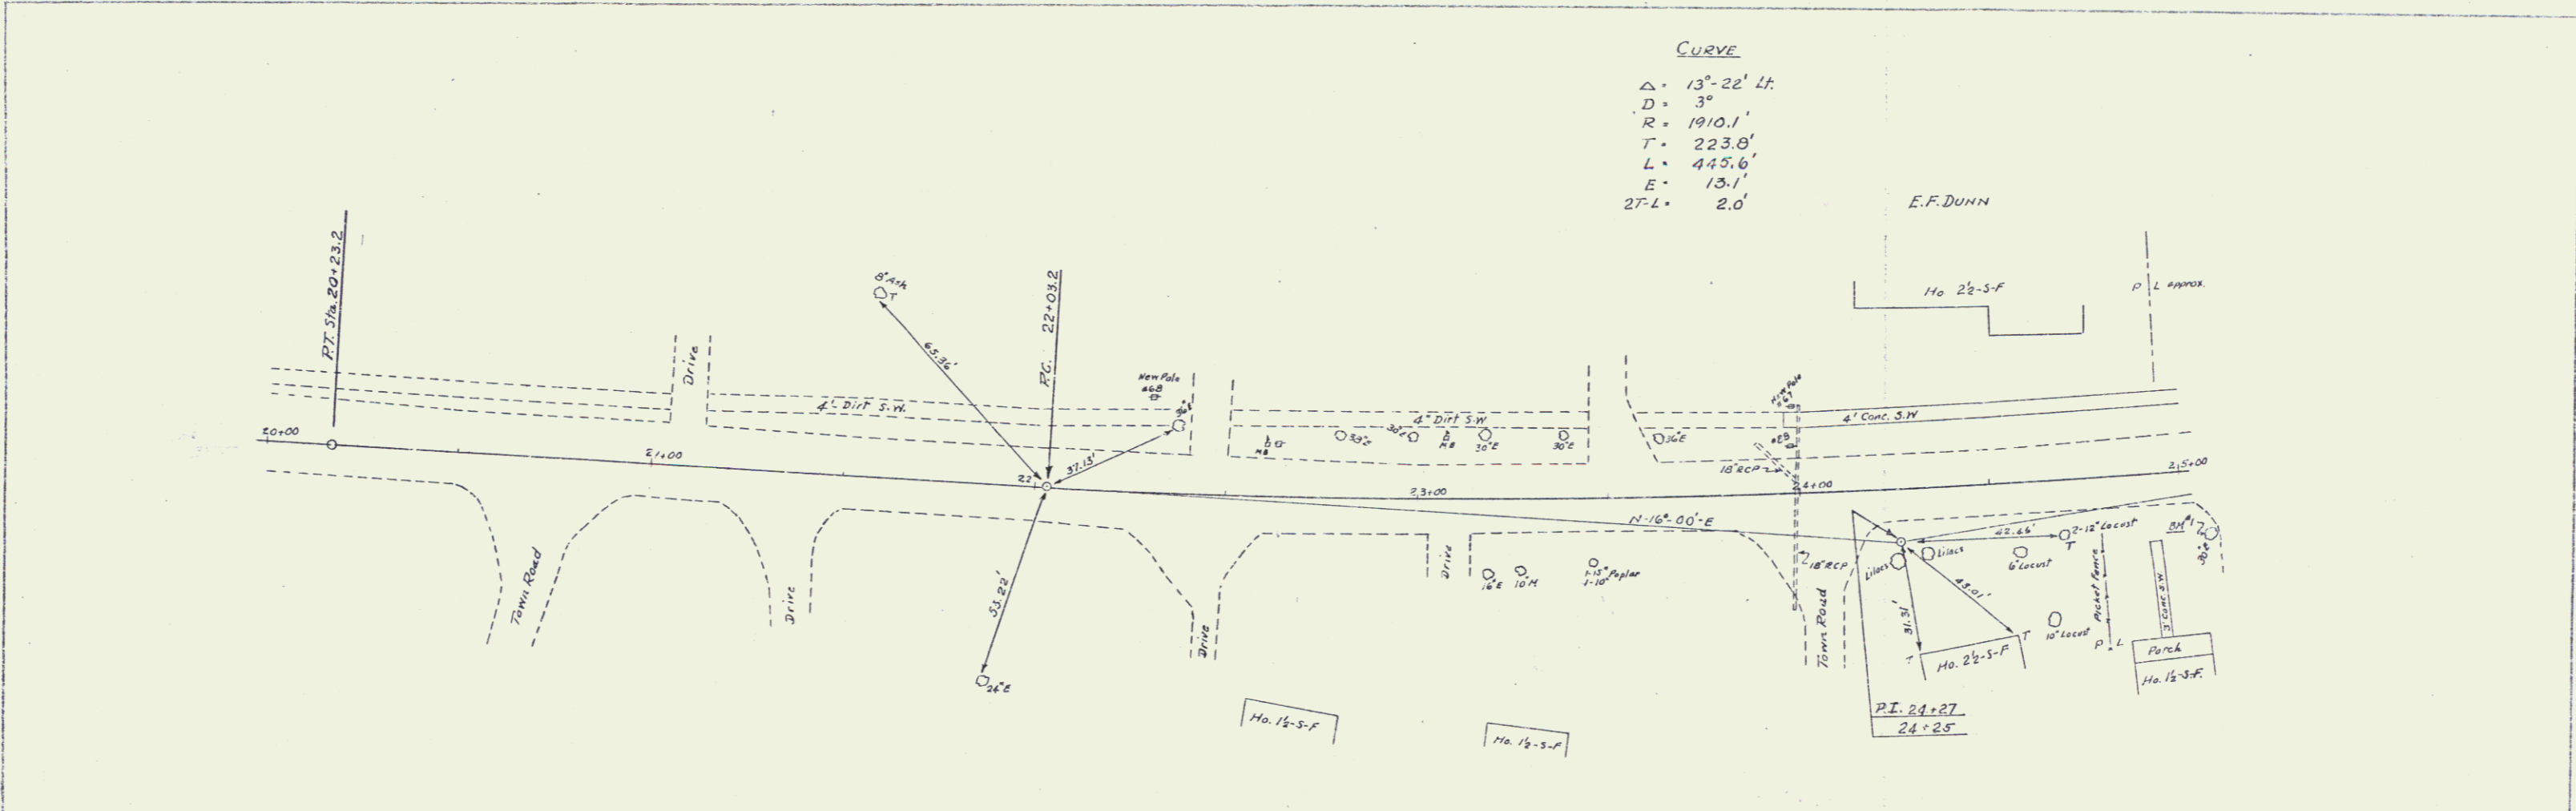

GLOVER  
 10/18/79  
 Sheet 6 of 6  
 AUG 18 1980 6