

WOOD GUIDE POSTS REQUIRED

COLL. STA.	LT.	RT.
53+70	1	1
52+00	1	1



(To Be Returned To R.O.W. Division)
 DOWN FILE
 PERMIT
 RIGHT-OF-WAY DIVISION
 4422-A

NEW REINF. CONC. PIPE CULVERTS REQUIRED

STATION	DIAM.	LENG.	GR/S
93+70	15"	36'	27.74
92+00	15"	36'	27.74

RESETTING GUARD RAIL REQUIRED

STATIONS	LT. OF ET.	LENG.
90+00-97+96	ET.	796'

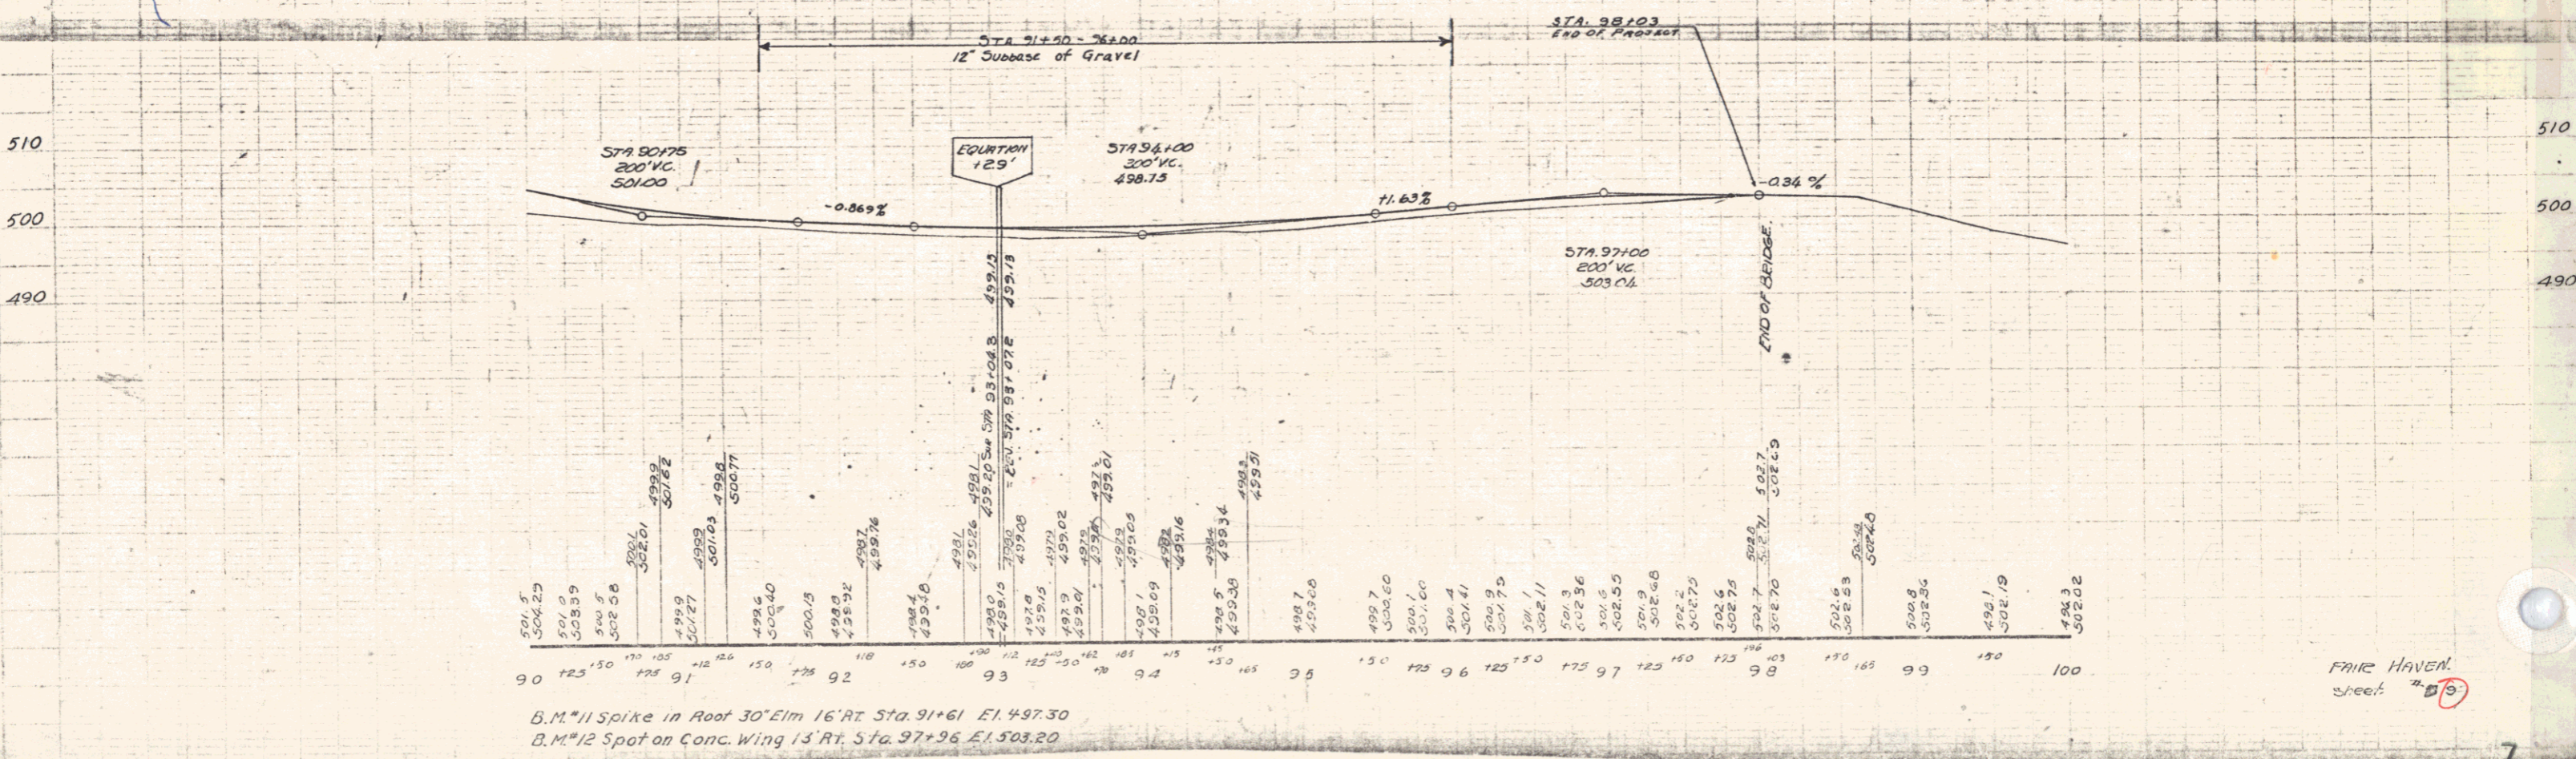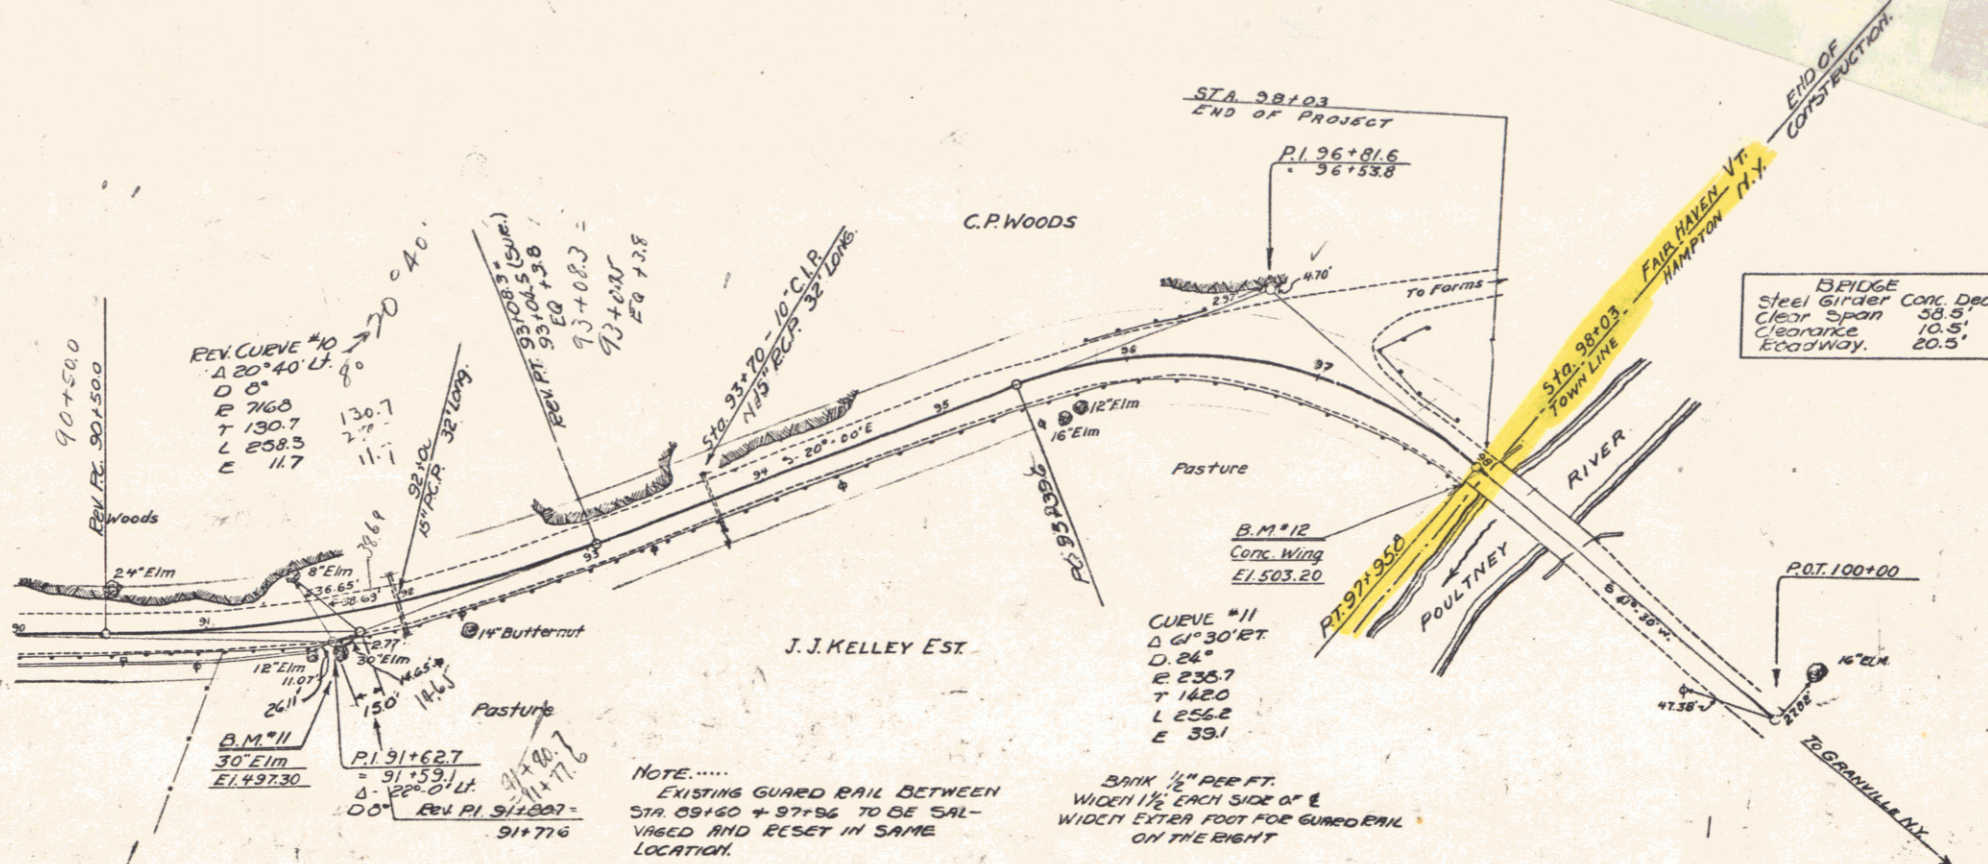

B.M. #11 Spike in Root 30' Elm 16' RT Sta. 91+61 E1.497.30
 B.M. #12 Spot on Conc. Wing 15' RT Sta. 97+96 E1.503.20

FAIR HAVEN
 4422-A

FAIR HAVEN
 sheet 4 of 5