

VERTICAL GRANITE CURB ITEM 556-B		
STATION	STATION	POS
48+86	48+95	RT
(INCLUDE RADIUS)		
49+13	50+26	RT
50+64	51+79	RT
51+00	53+22	LT
51+97	52+54	RT
53+72	53+30	RT
53+59	53+27	RT
54+24	57+30	LT
53+87	55+31	RT
53+77	56+26	RT
55+88	57+32	RT
57+68	58+00	LT
57+22	58+00	RT
4 <sup>TH</sup> STREET		
0+30	1+13	LT
(INCLUDE RADIUS)		

CONSTRUCT DRIVES		
STATION	POS	
45+00	LT	
45+35	RT	
48+90	LT	
49+04	RT	
50+55	RT	
51+28	RT	
52+63	RT	
53+39	RT	
53+56	LT	
54+21	RT	
55+54	RT	
57+59	LT	

GRANITE SLOPE EDGING ITEM 556-A		
STATION	STATION	POS
45+73	45+95	RT
(INCLUDE RADIUS)		
49+04	49+04	RT
50+55	50+55	RT
51+28	51+28	RT
52+63	52+63	RT
53+39	53+39	RT
53+56	53+56	LT
54+21	54+21	RT
55+54	55+54	RT
57+59	57+59	LT

5" ONE COURSE CEMENT CONCRETE SIDEWALK, ITEM 560		
STATION	STATION	POS
48+97	54+21	RT
55+77	57+32	RT
57+77	58+00	RT



8" ONE COURSE CEMENT CONCRETE SIDEWALK, ITEM 560		
STATION	STATION	POS
54+21	55+77	RT
57+32	57+77	RT

CONCRETE CURB ITEM 401-B		
STATION	STATION	POS
54+21	54+21	RT
55+77	55+77	RT
57+32	57+32	RT
57+77	57+77	RT

TOPSOIL ITEM 621		
STATION	STATION	POS
45+79	46+45	RT
46+95	47+27	RT
4 <sup>TH</sup> STREET		
0+30	1+13	LT

CONSTRUCT 4 <sup>TH</sup> STREET APPROACH		
STATION	STATION	POS
0+30	1+13	LT

EXCAVATION AND REMOVAL OF ROAD SURFACES AND/OR PAVEMENTS ITEM 119		
STATION	STATION	POS
45+79	46+45	RT
46+95	47+27	RT
4 <sup>TH</sup> STREET		
0+30	0+90	LT
0+30	0+89	RT

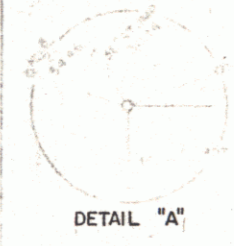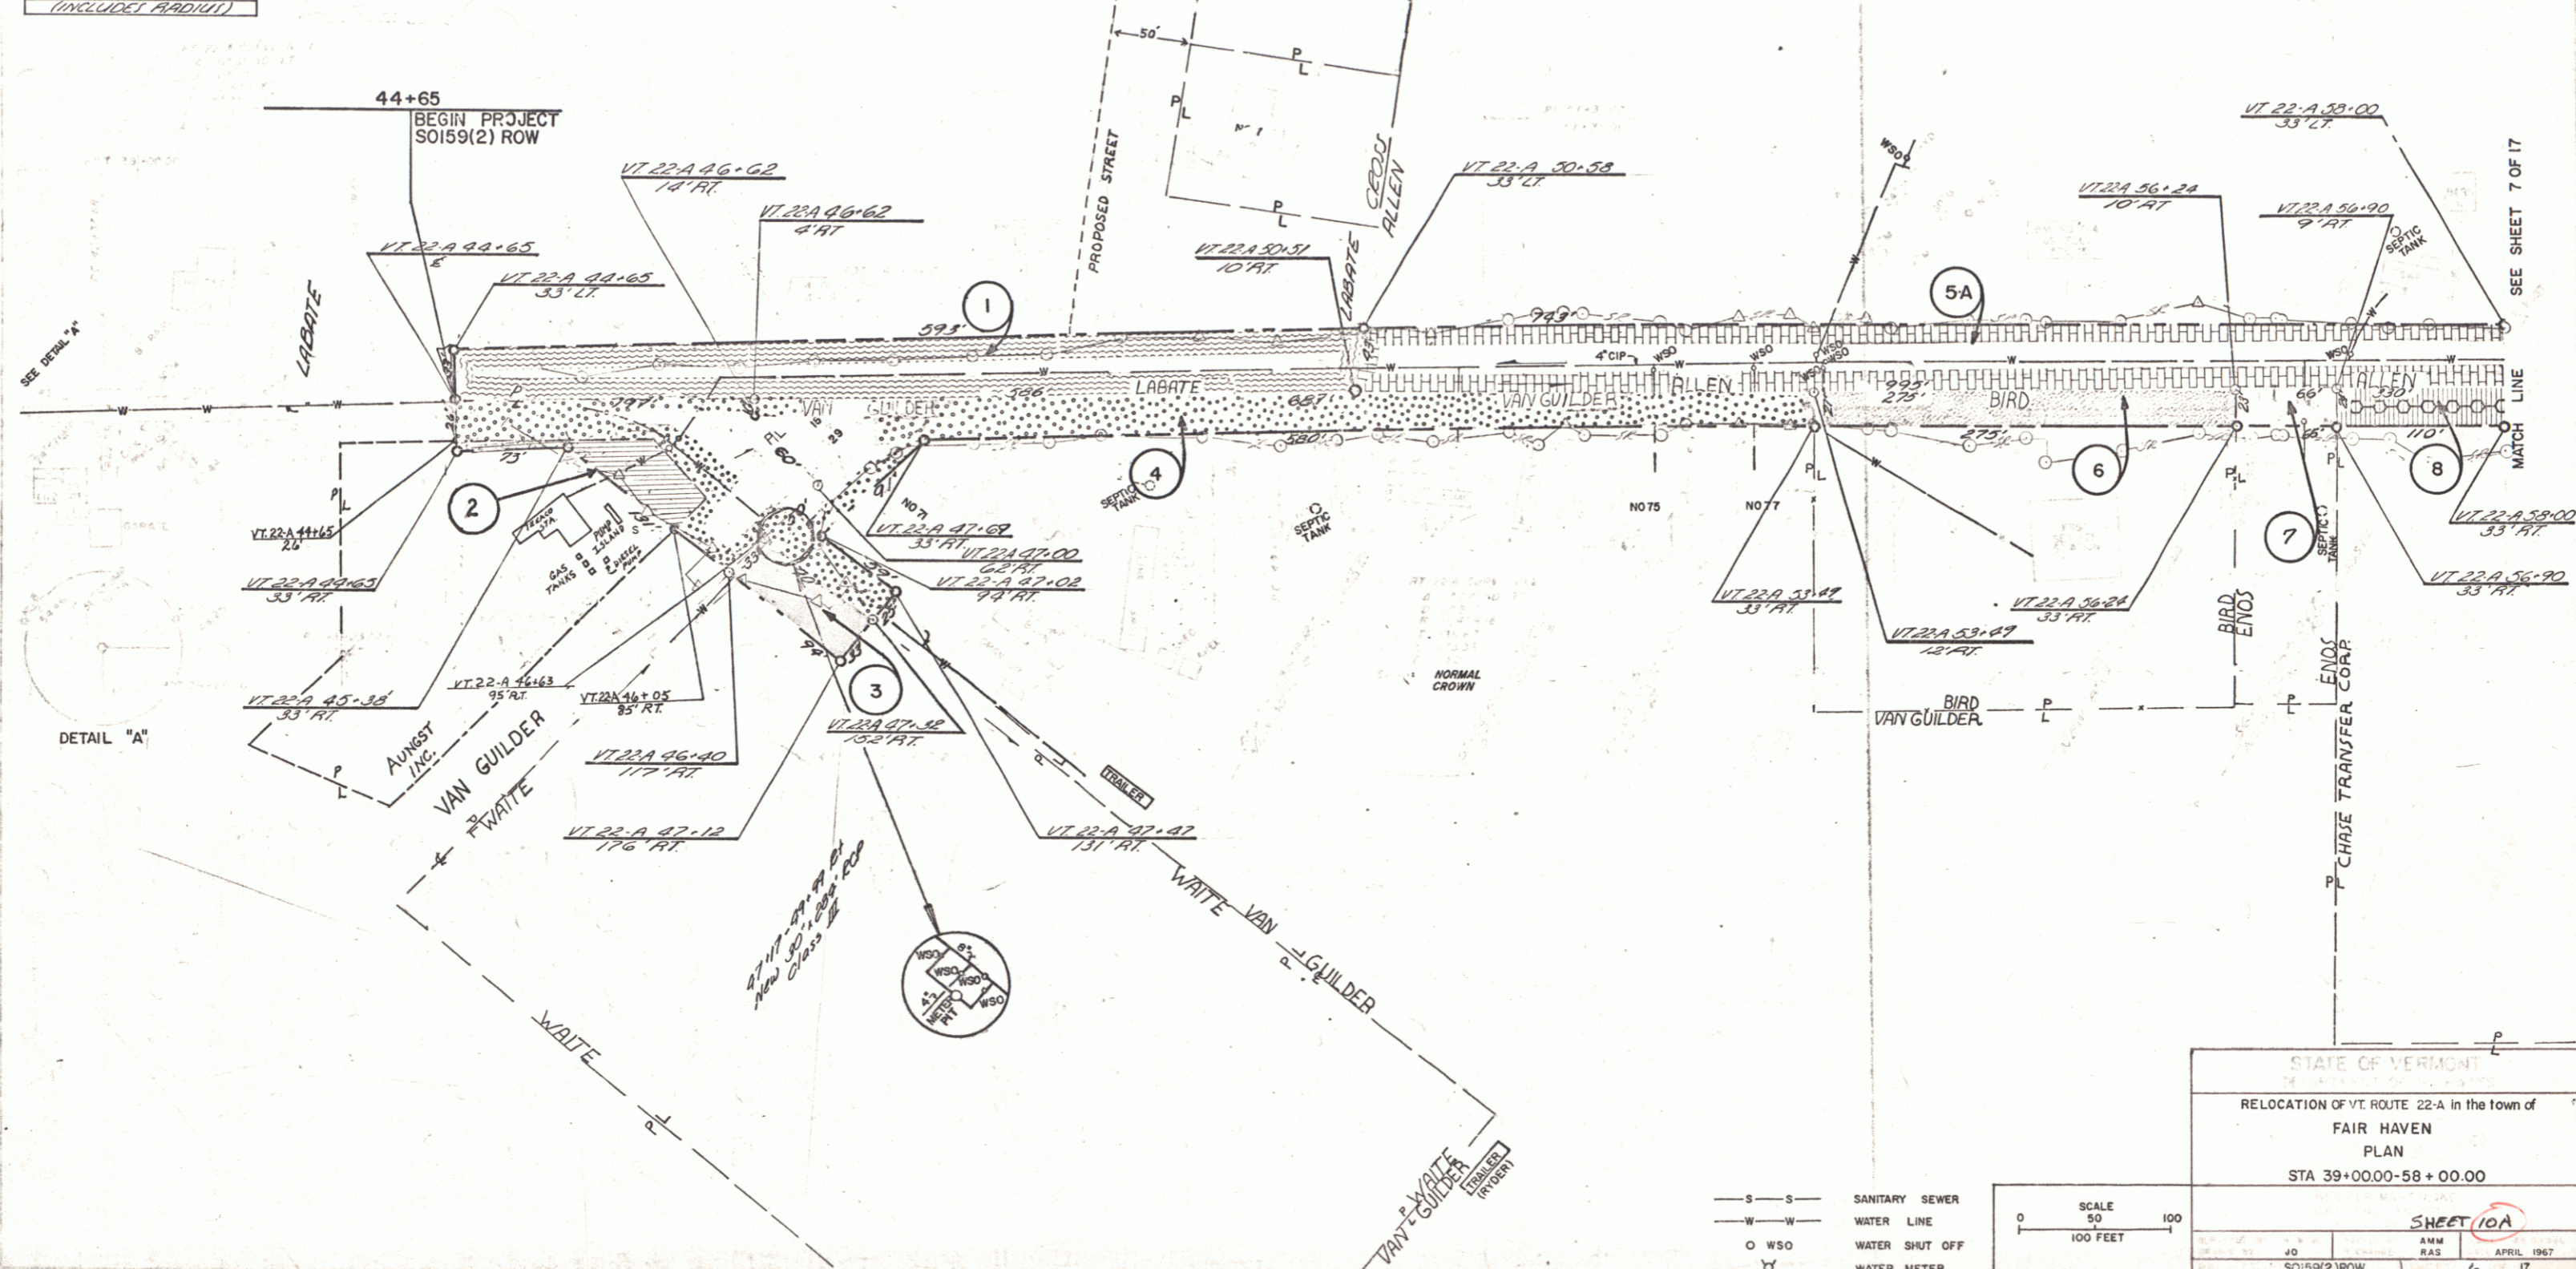

STATE OF VERMONT  
RELOCATION OF VT ROUTE 22-A in the town of  
FAIR HAVEN  
PLAN  
STA 39+00.00-58+00.00

SCALE  
0 50 100  
100 FEET

SHEET 10A  
APRIL 1967

6 17