


PLAN  
 DATE 8/20/58  
 DRAWN BY J.R. POHAR  
 CHECKED BY J.R. POHAR  
 SCALE 1" = 40'

PROFILE  
 DATE 8/20/58  
 DRAWN BY J.R. POHAR  
 CHECKED BY J.R. POHAR  
 SCALE 1" = 40'

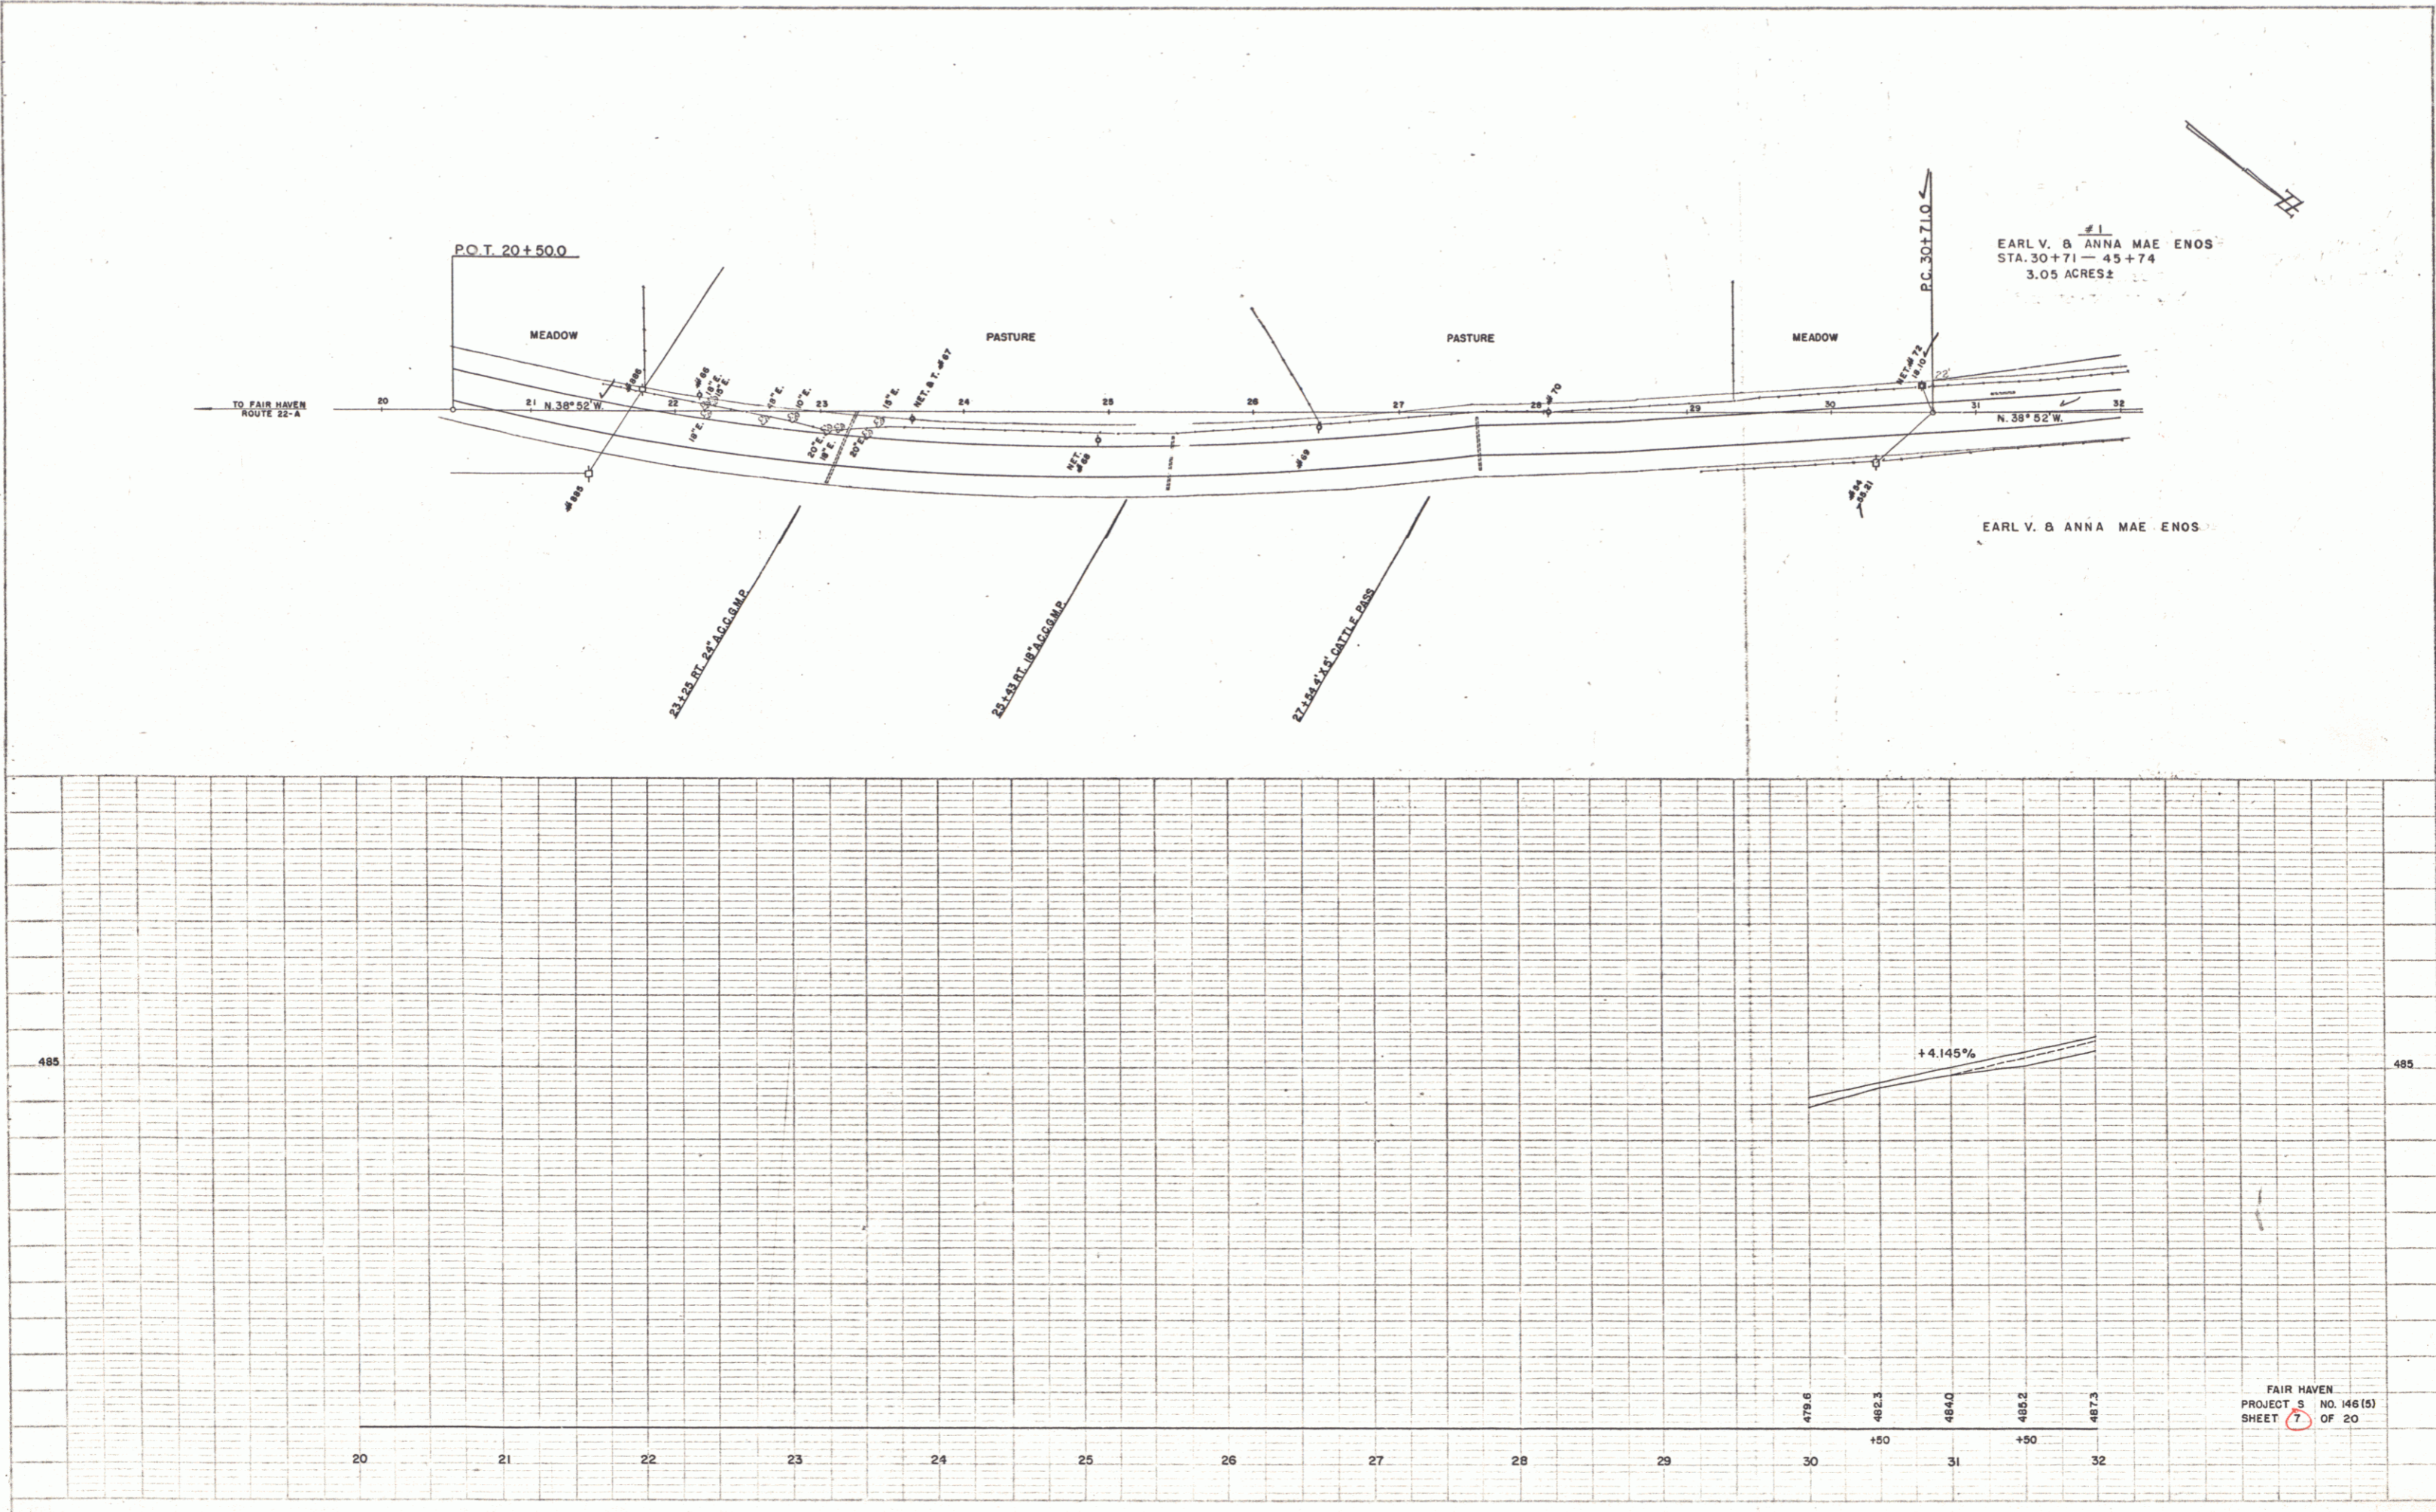

FAIR HAVEN  
 PROJECT 5 NO. 146 (S)  
 SHEET 7 OF 20