


APPROACH RT. 33+25  
GUIDE POSTS RT. 33+25-2  
37+50-1

DRIVES  
LT. 33+60  
RT. 37+25  
37+25 44+35


THREE CABLE GUARD RAIL  
LT. 40+30-43+14  
RT. 38+20-43+00  
45+35-48+00 46+16-47+60

PLANK GUARD RAIL RT.  
40+26  
43+15

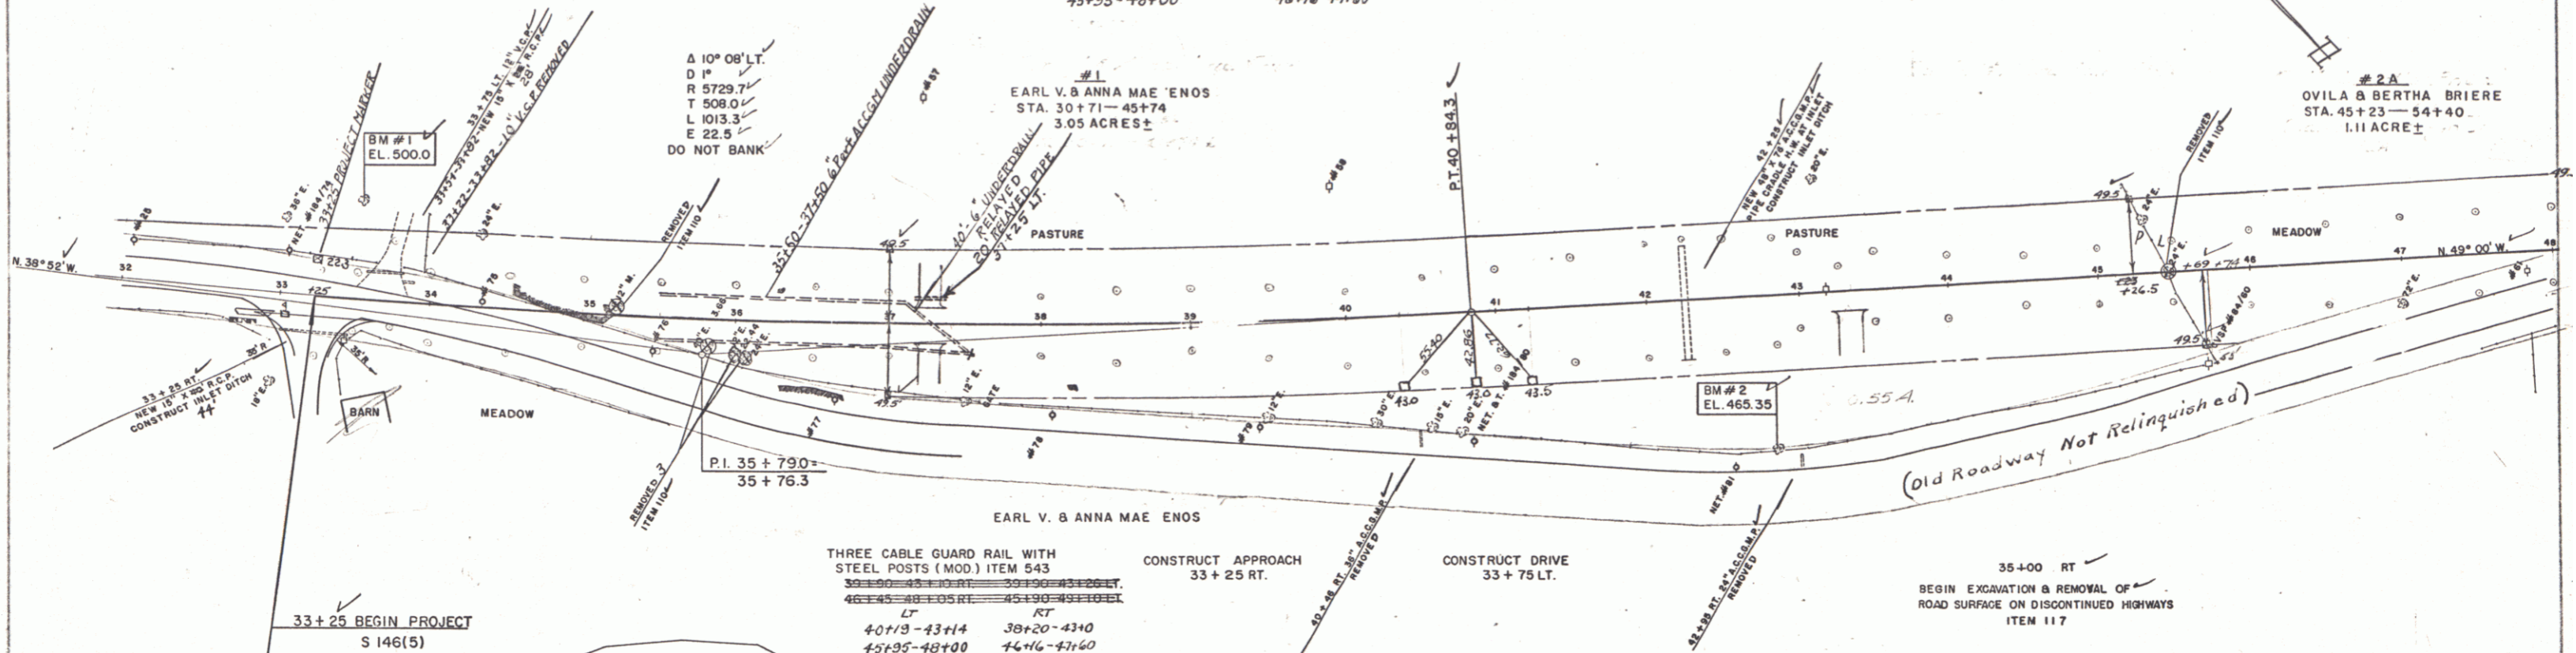

THREE CABLE GUARD RAIL WITH STEEL POSTS (MOD) ITEM 543  
CONSTRUCT APPROACH 33+25 RT.  
LT. 40+30-43+14  
RT. 38+20-43+00  
45+35-48+00 46+16-47+60

PARCEL	GRANTOR	NATURE OF TITLE	DATE	TOWN	VOL	PAGE	DATE
# 1	EARL V. & ANNA MAE ENOS	W. D. O. E.	6-29-56	FAIR HAVEN	30	289	7-25-56 SEE ALSO SHEET 7
# 2 A	OVILA & BERTHA BRIERE	W. D. O. E.	6-29-56	FAIR HAVEN	30	287-288	7-25-56 SEE ALSO SHEET 9

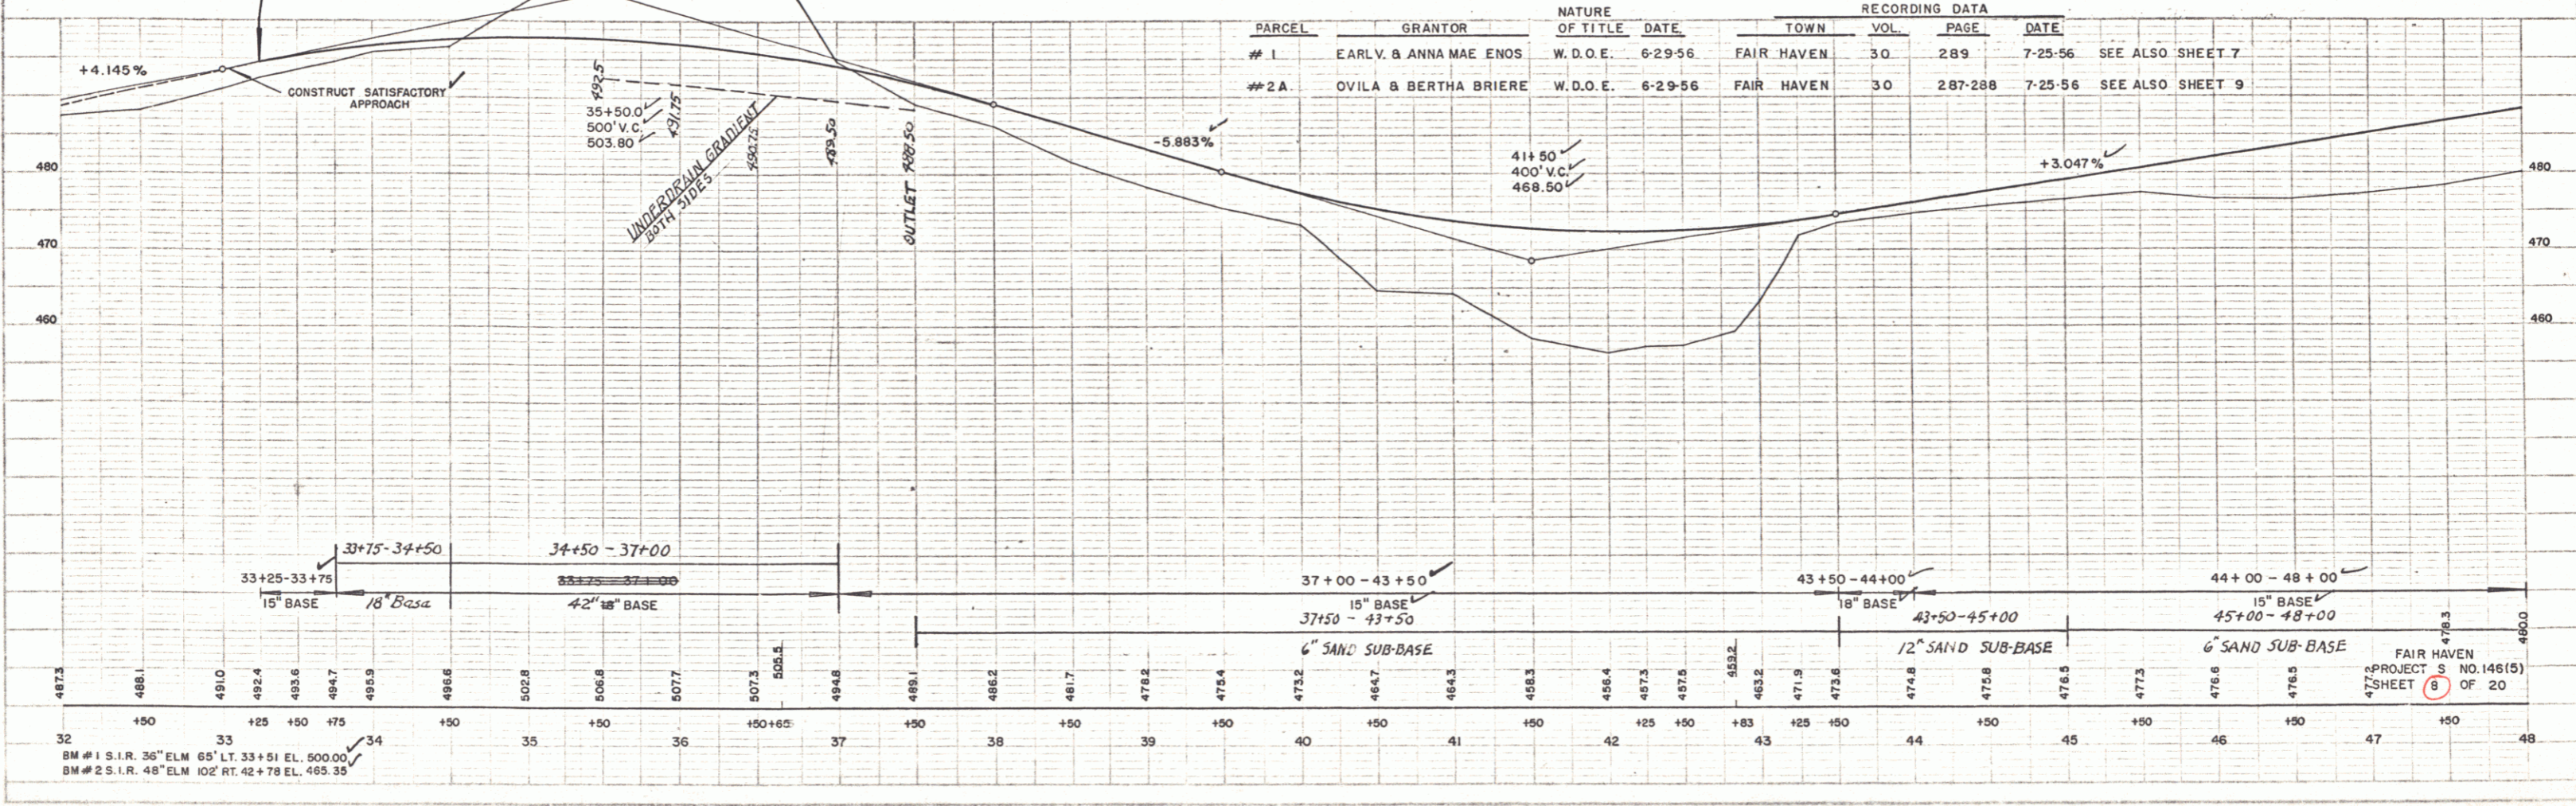

7/55  
7/55  
BM #1 S.I.R. 36" ELM 65' LT. 33+51 EL. 500.00  
BM #2 S.I.R. 48" ELM 102' RT. 42+78 EL. 465.35

FAIR HAVEN  
PROJECT NO. 146(5)  
SHEET 8 OF 20