


**DRIVES**

LT.	RT.
48+90	43+00
49+05	49+90
49+90	51+15
58+80	
61+90	

PARCEL	GRANTOR	NATURE OF TITLE	DATE	TOWN	VOL.	PAGE	DATE
3A,B	LAURA W. HAMILTON	W.D.O.E.	6-29-56	FAIR HAVEN	30	288	7-25-56
2B	OVILA & BERTHA BRIERE	W.D.O.E.	6-29-56	FAIR HAVEN	30	287-288	7-25-56

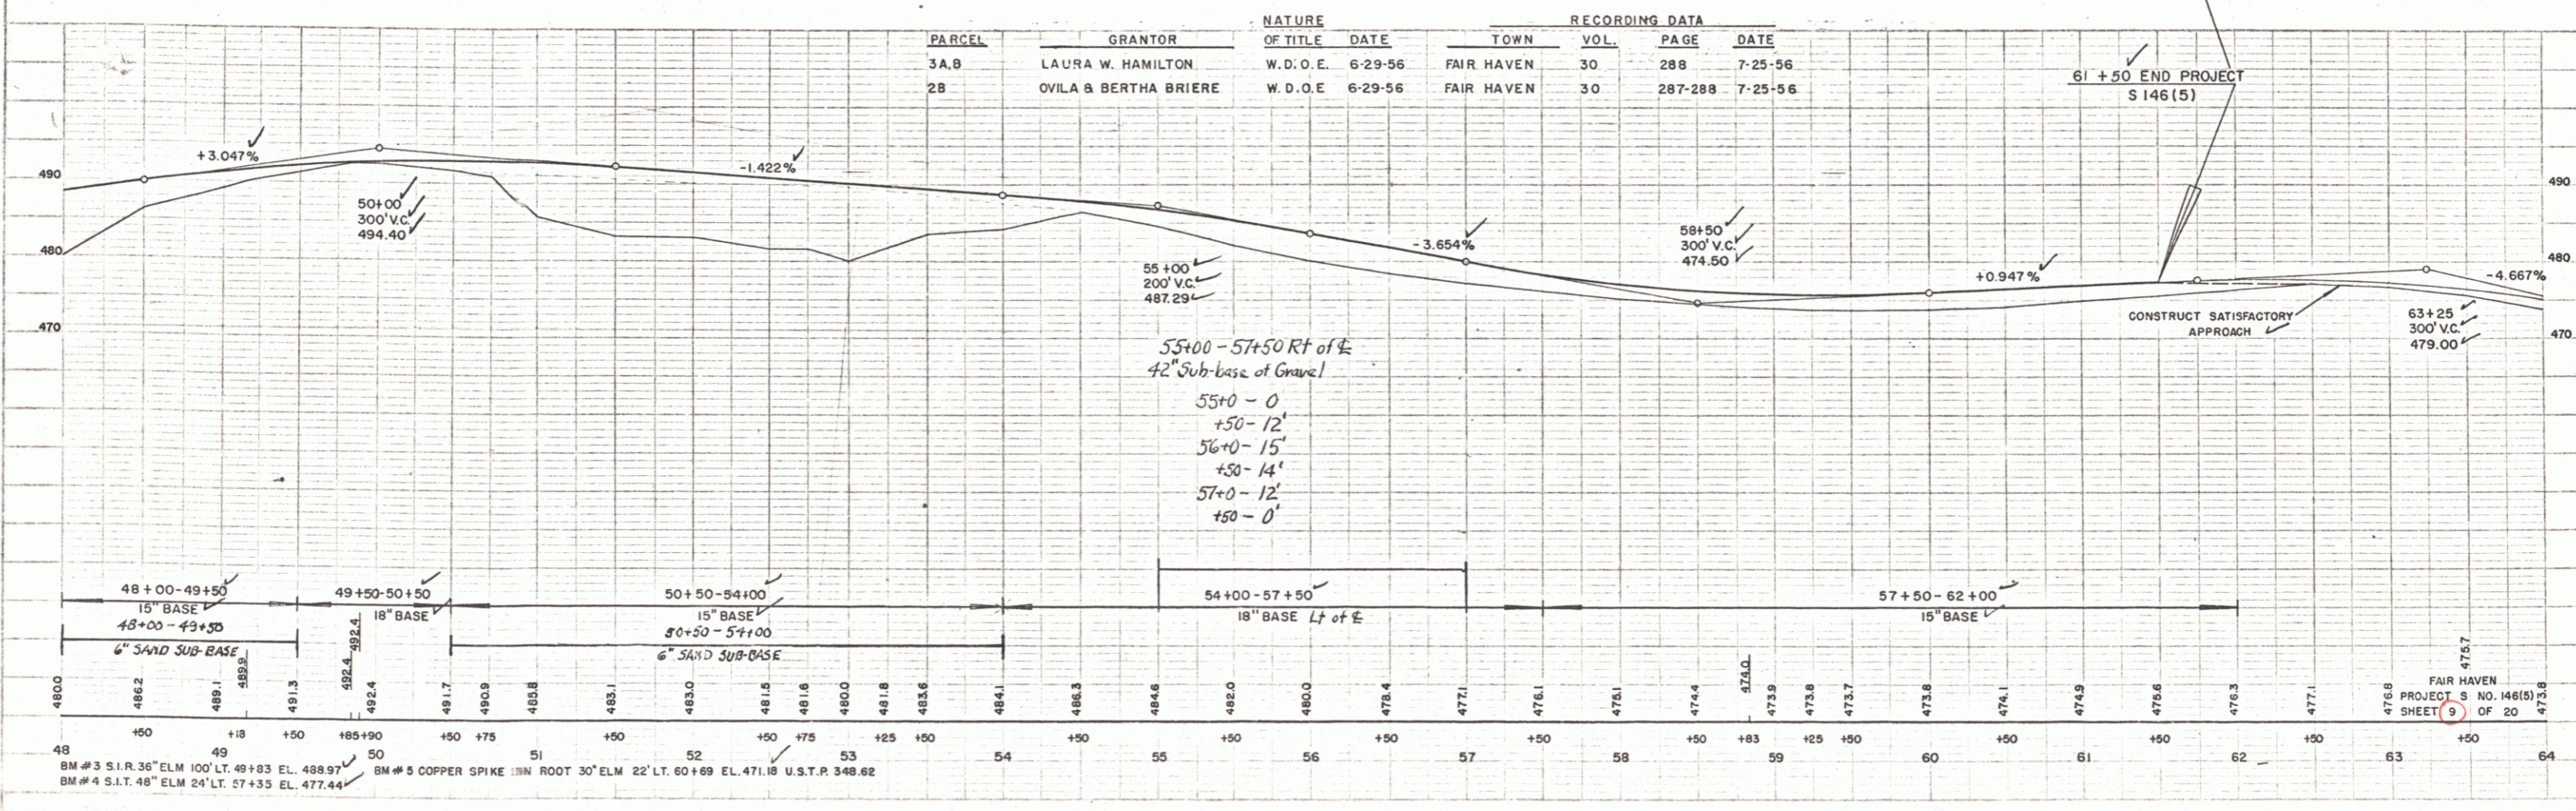

PLAN  
DATE LOCATED  
NO. THICKED

PLAN  
DATE LOCATED  
NO. THICKED

FAIR HAVEN  
PROJECT S NO. 146(5)  
SHEET 9 OF 20