






PLAN  
 DATE 5/20/58  
 DRAWN BY J.R. POHAR  
 CHECKED BY J.R. POHAR  
 SCALE 1" = 40'

PROFILE  
 DATE 5/20/58  
 DRAWN BY J.R. POHAR  
 CHECKED BY J.R. POHAR  
 SCALE 1" = 40'

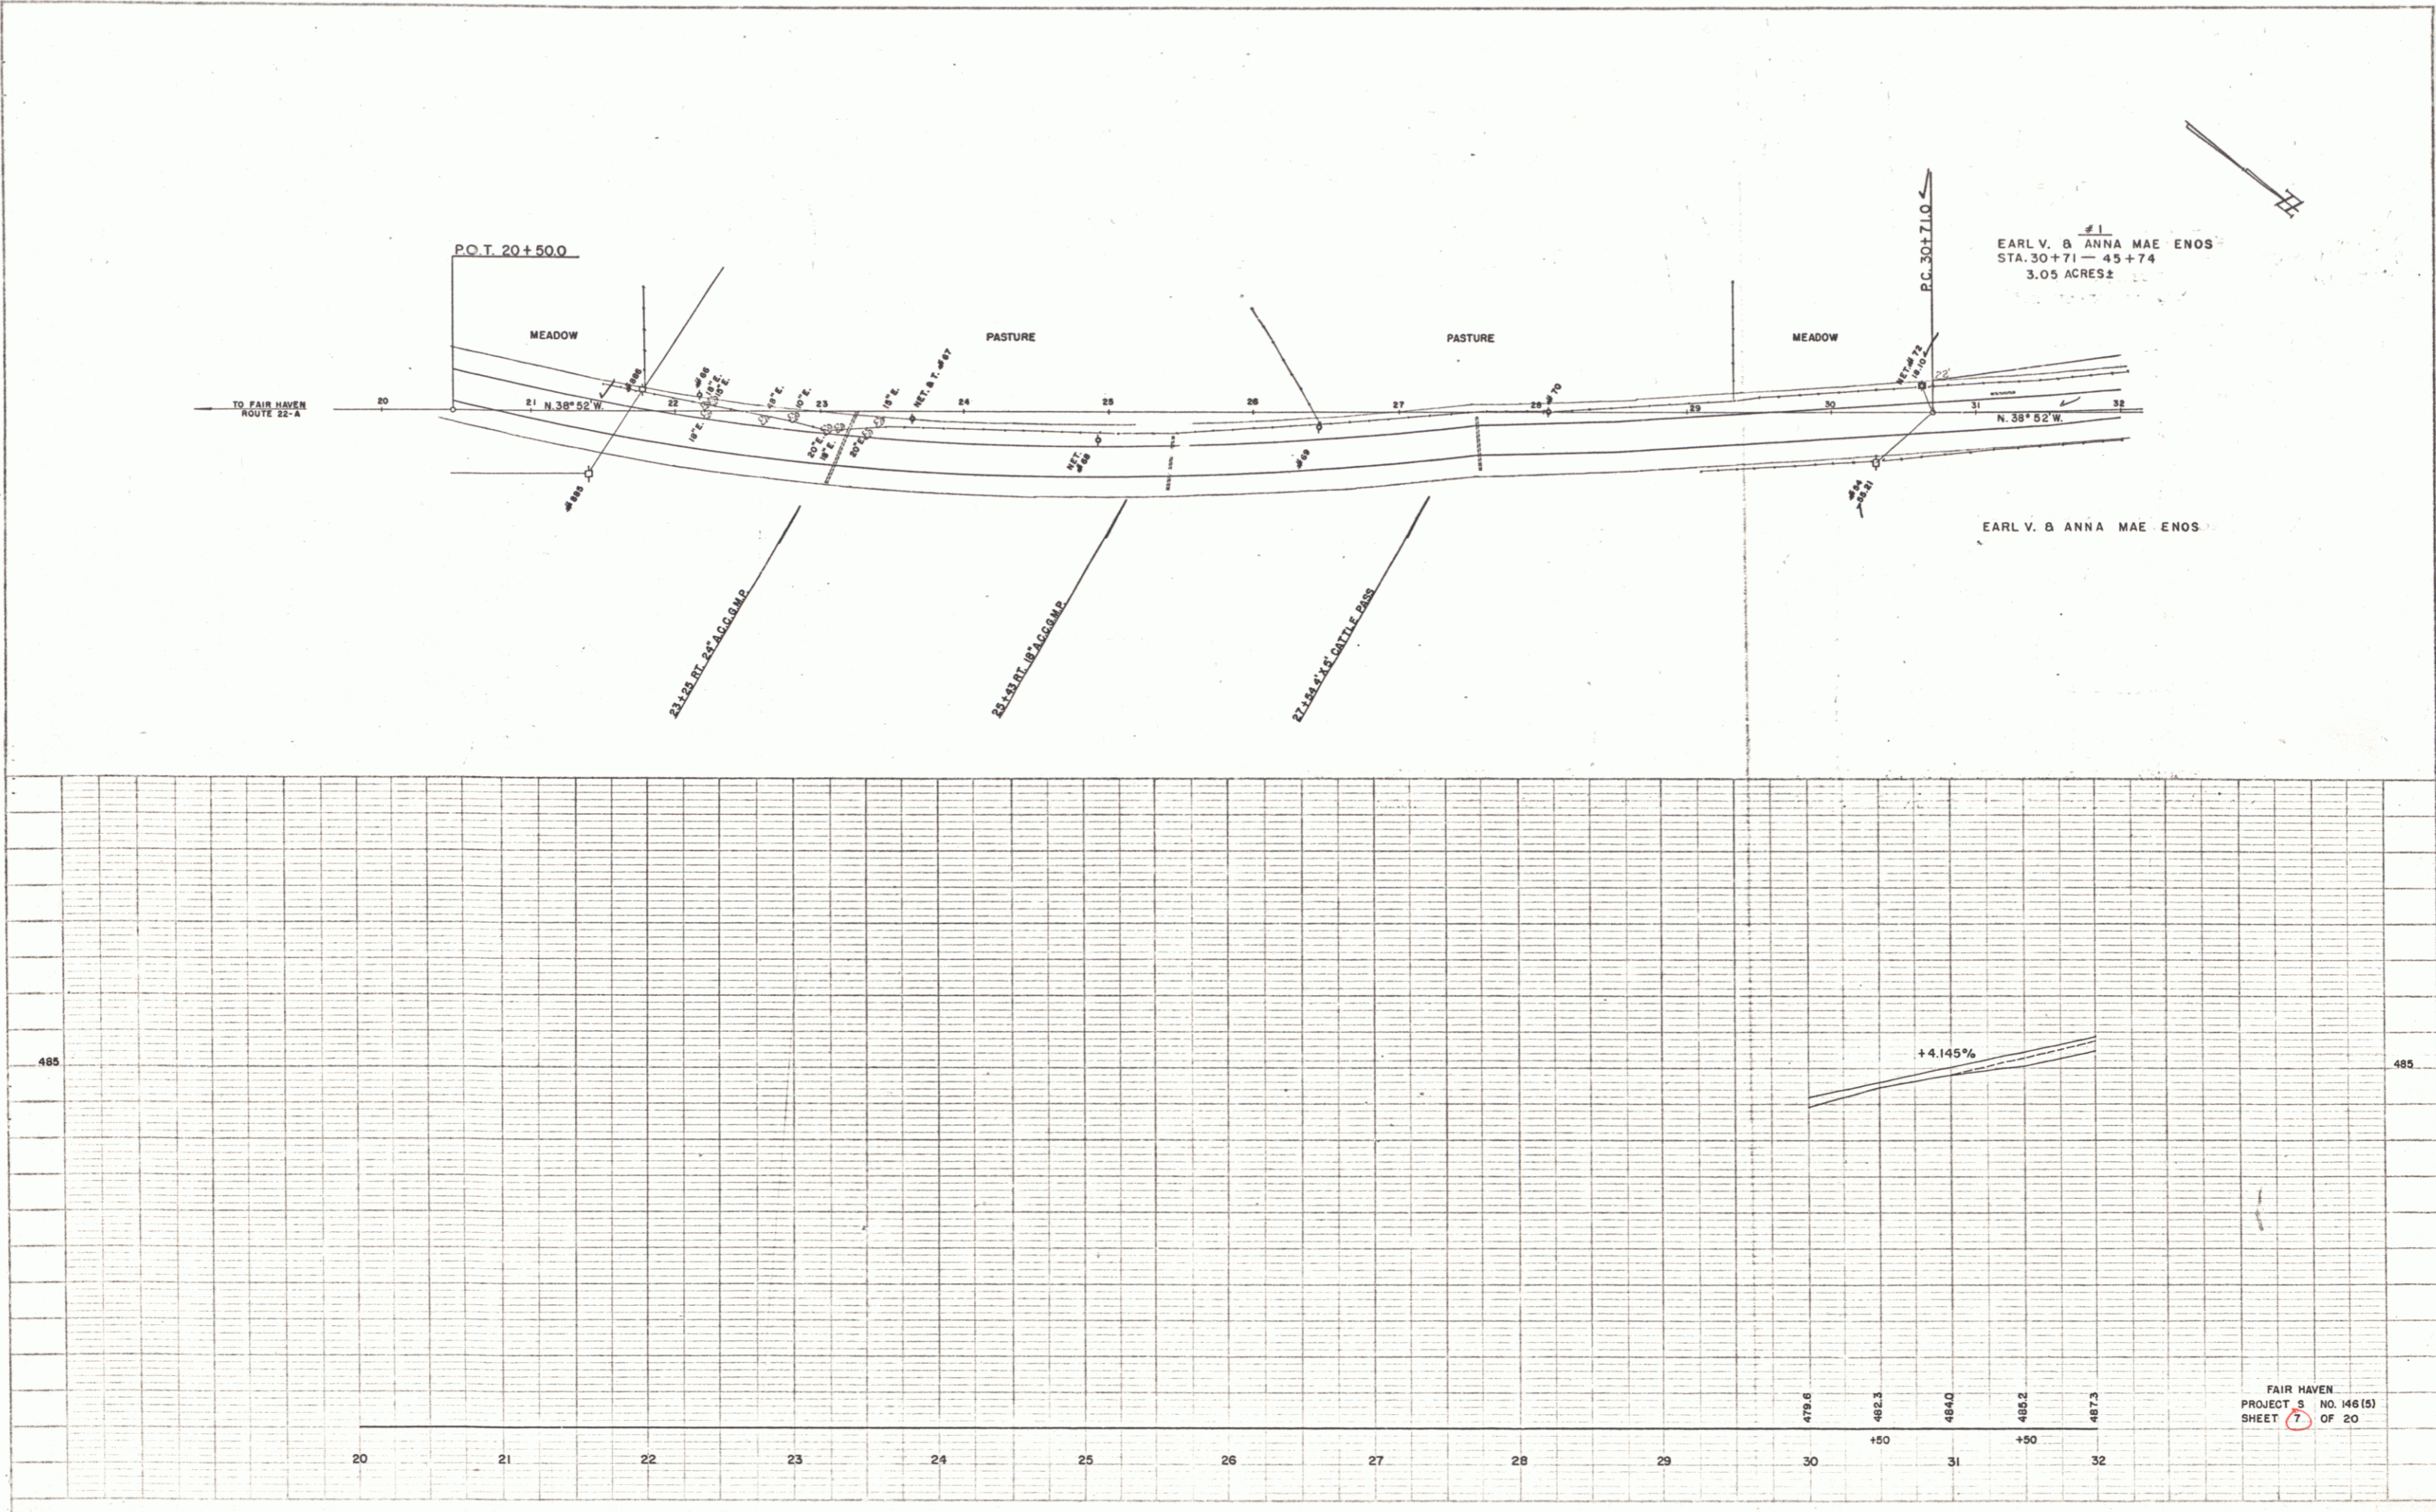

FAIR HAVEN  
 PROJECT 5 NO. 146 (S)  
 SHEET 7 OF 20



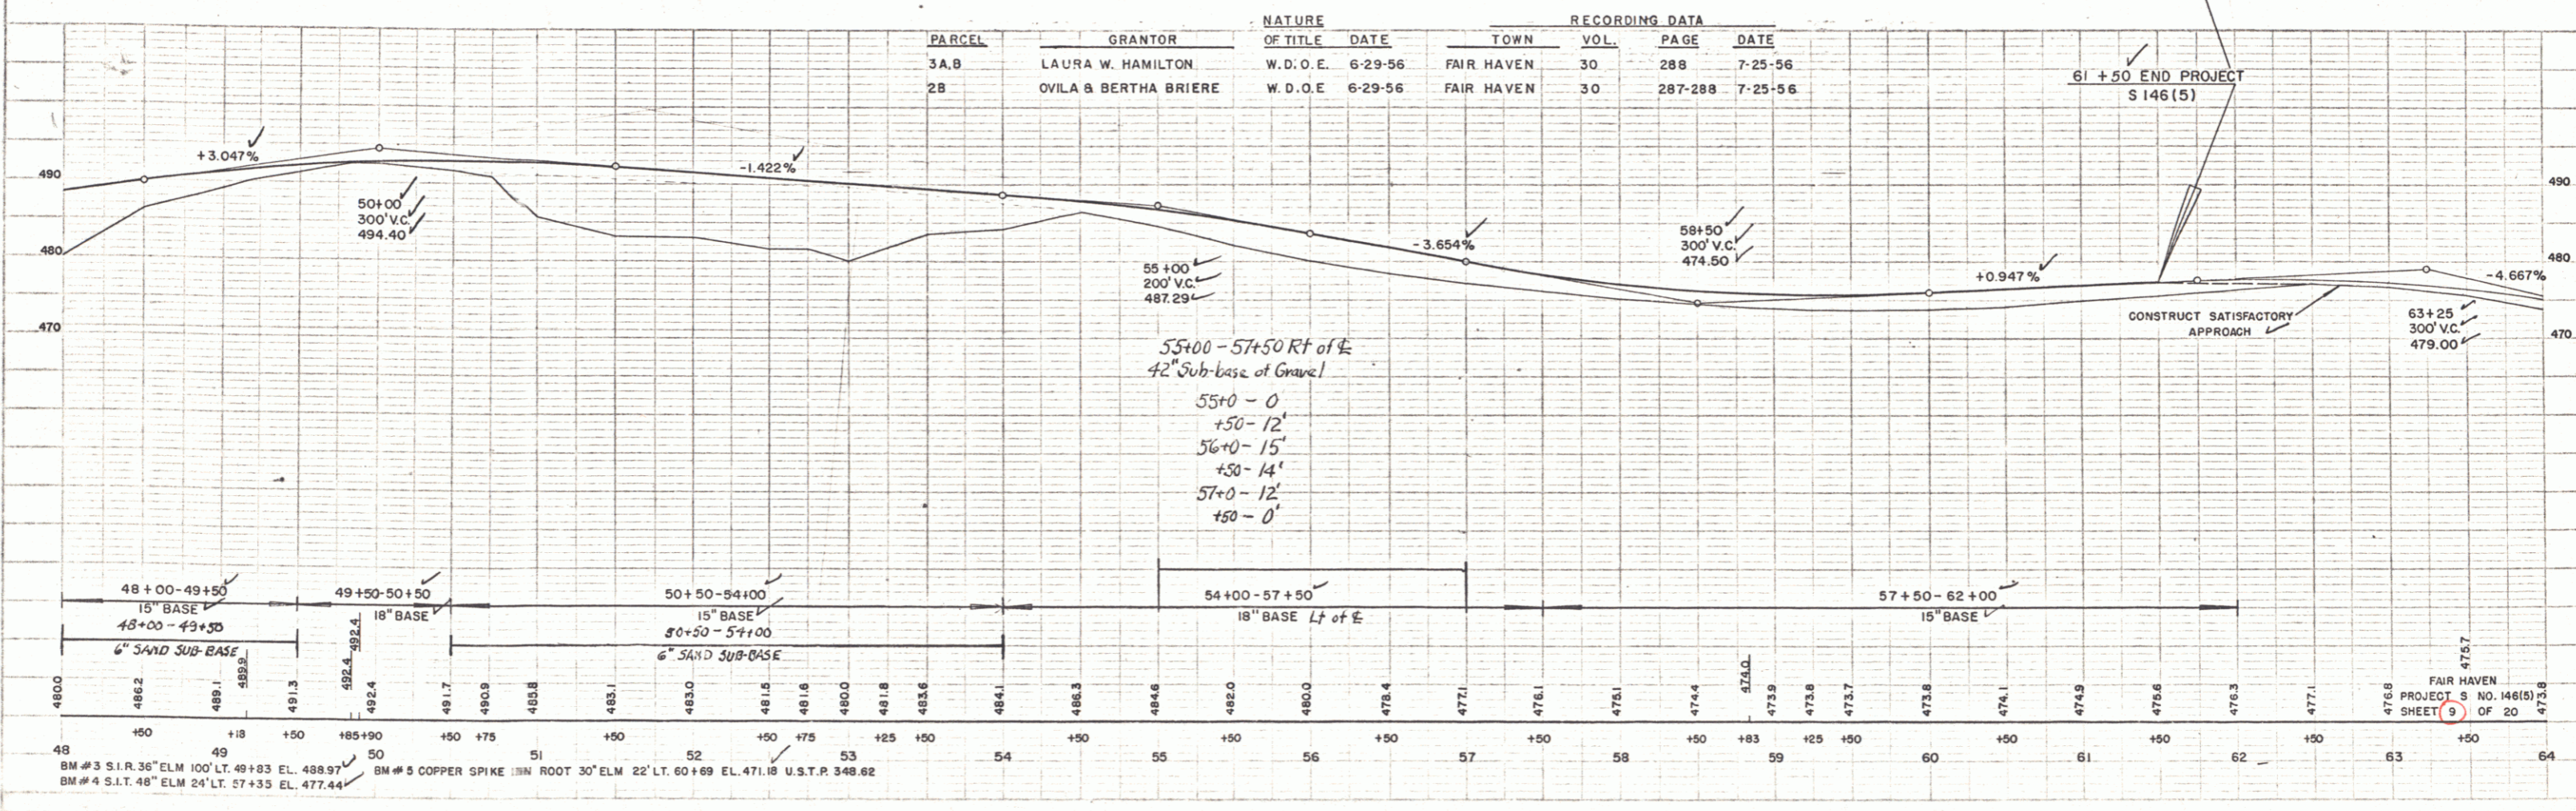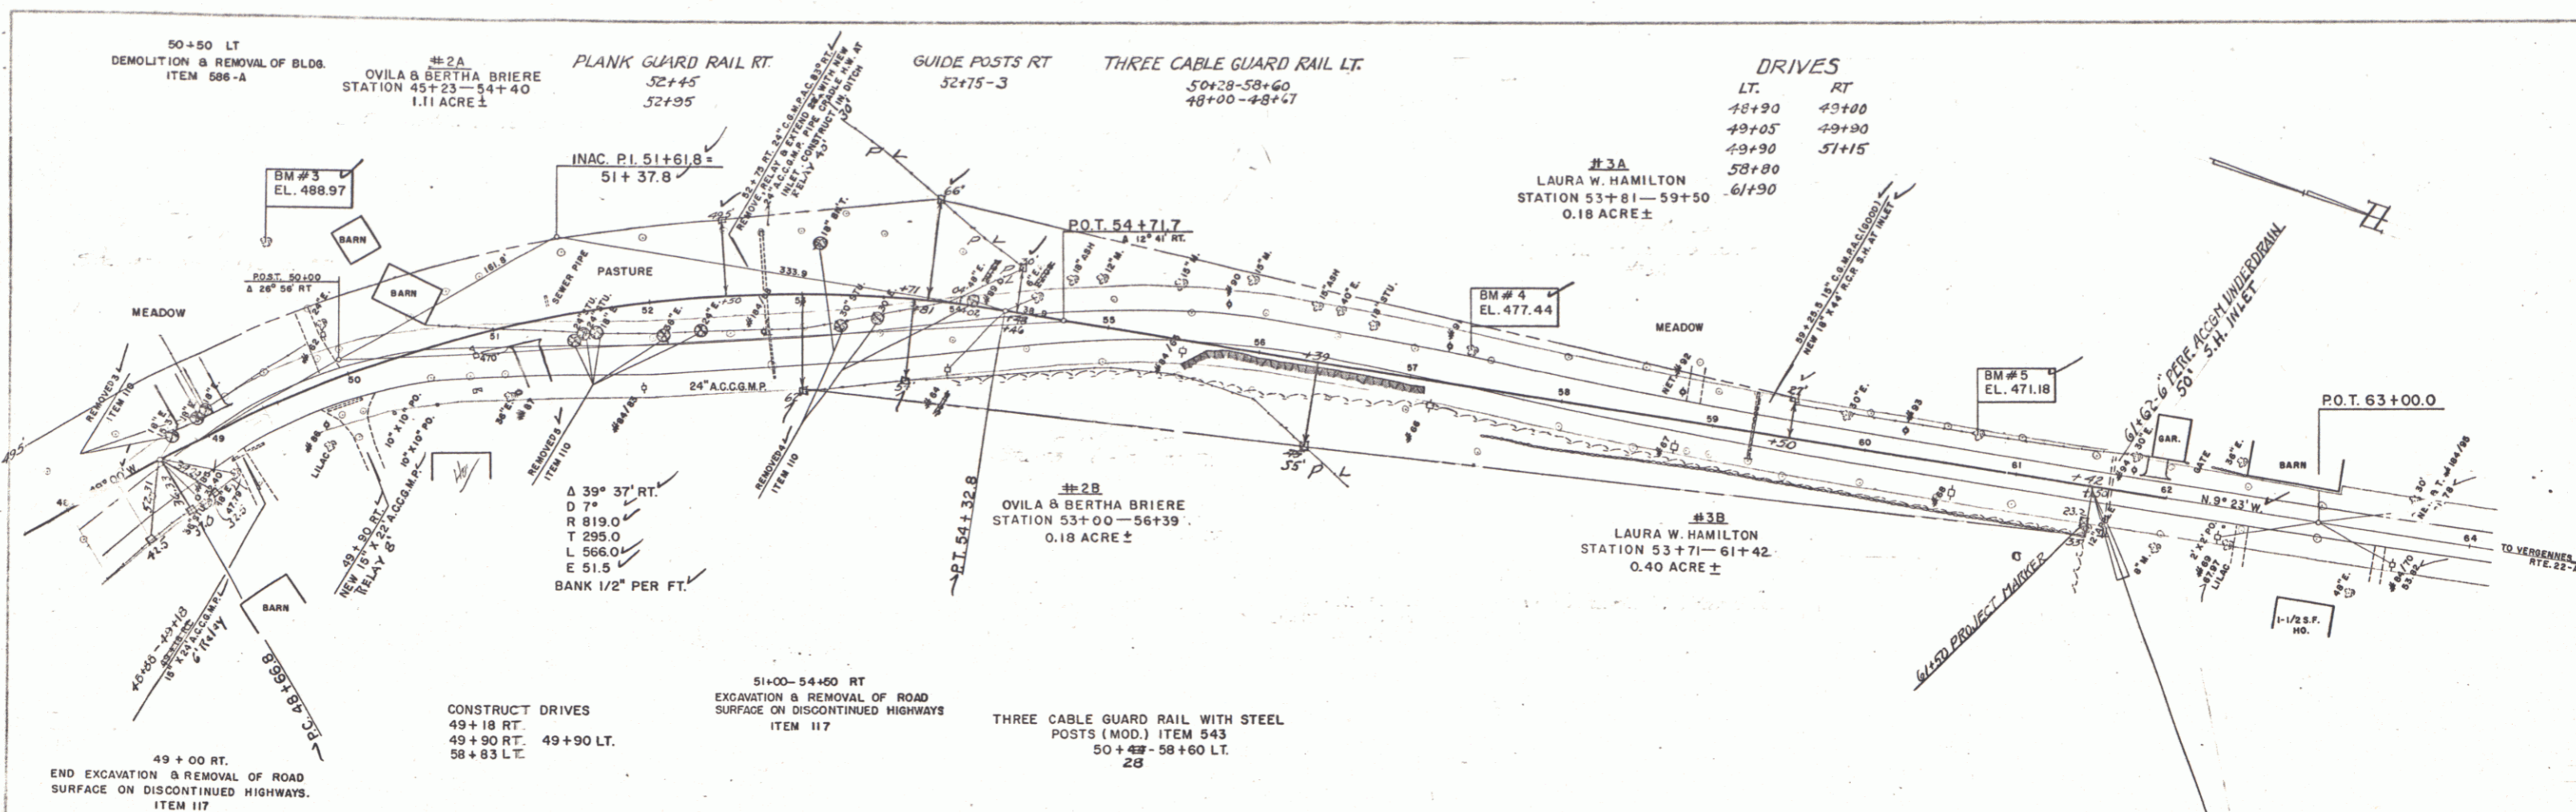

PARCEL	GRANTOR	NATURE OF TITLE	DATE	TOWN	VOL.	PAGE	DATE
3A,B	LAURA W. HAMILTON	W.D.O.E.	6-29-56	FAIR HAVEN	30	288	7-25-56
2B	OVILA & BERTHA BRIERE	W.D.O.E.	6-29-56	FAIR HAVEN	30	287-288	7-25-56

PLAN  
DATE LOCATED  
NO. THICKED

7/55  
7/56  
7/56

FAIR HAVEN  
PROJECT S NO. 146(5)  
SHEET 9 OF 20