


NOTE: ALL DRIVES TO BE CONSTRUCTED WITH A MINIMUM 12' WIDTH AND 15' FLARE RADIUS

BM # 11  
Ch<sup>n</sup> in ledge  
US Elev. 36770'

REMOVAL AND DISPOSAL OF PRESENT GUARD RAIL  
127+45 - 131+70'  
128+15 - 131+70'  
THREE CABLE GUARD RAIL WITH STEEL POSTS  
127+45 - 130+66  
128+15 - 131+70'  
131+76 - 133+00'

CONSTRUCT DRIVE  
131+00 - 132+50'  
132+00

PLAN  
DESIGNED BY  
CHECKED BY  
DATE  
NO.

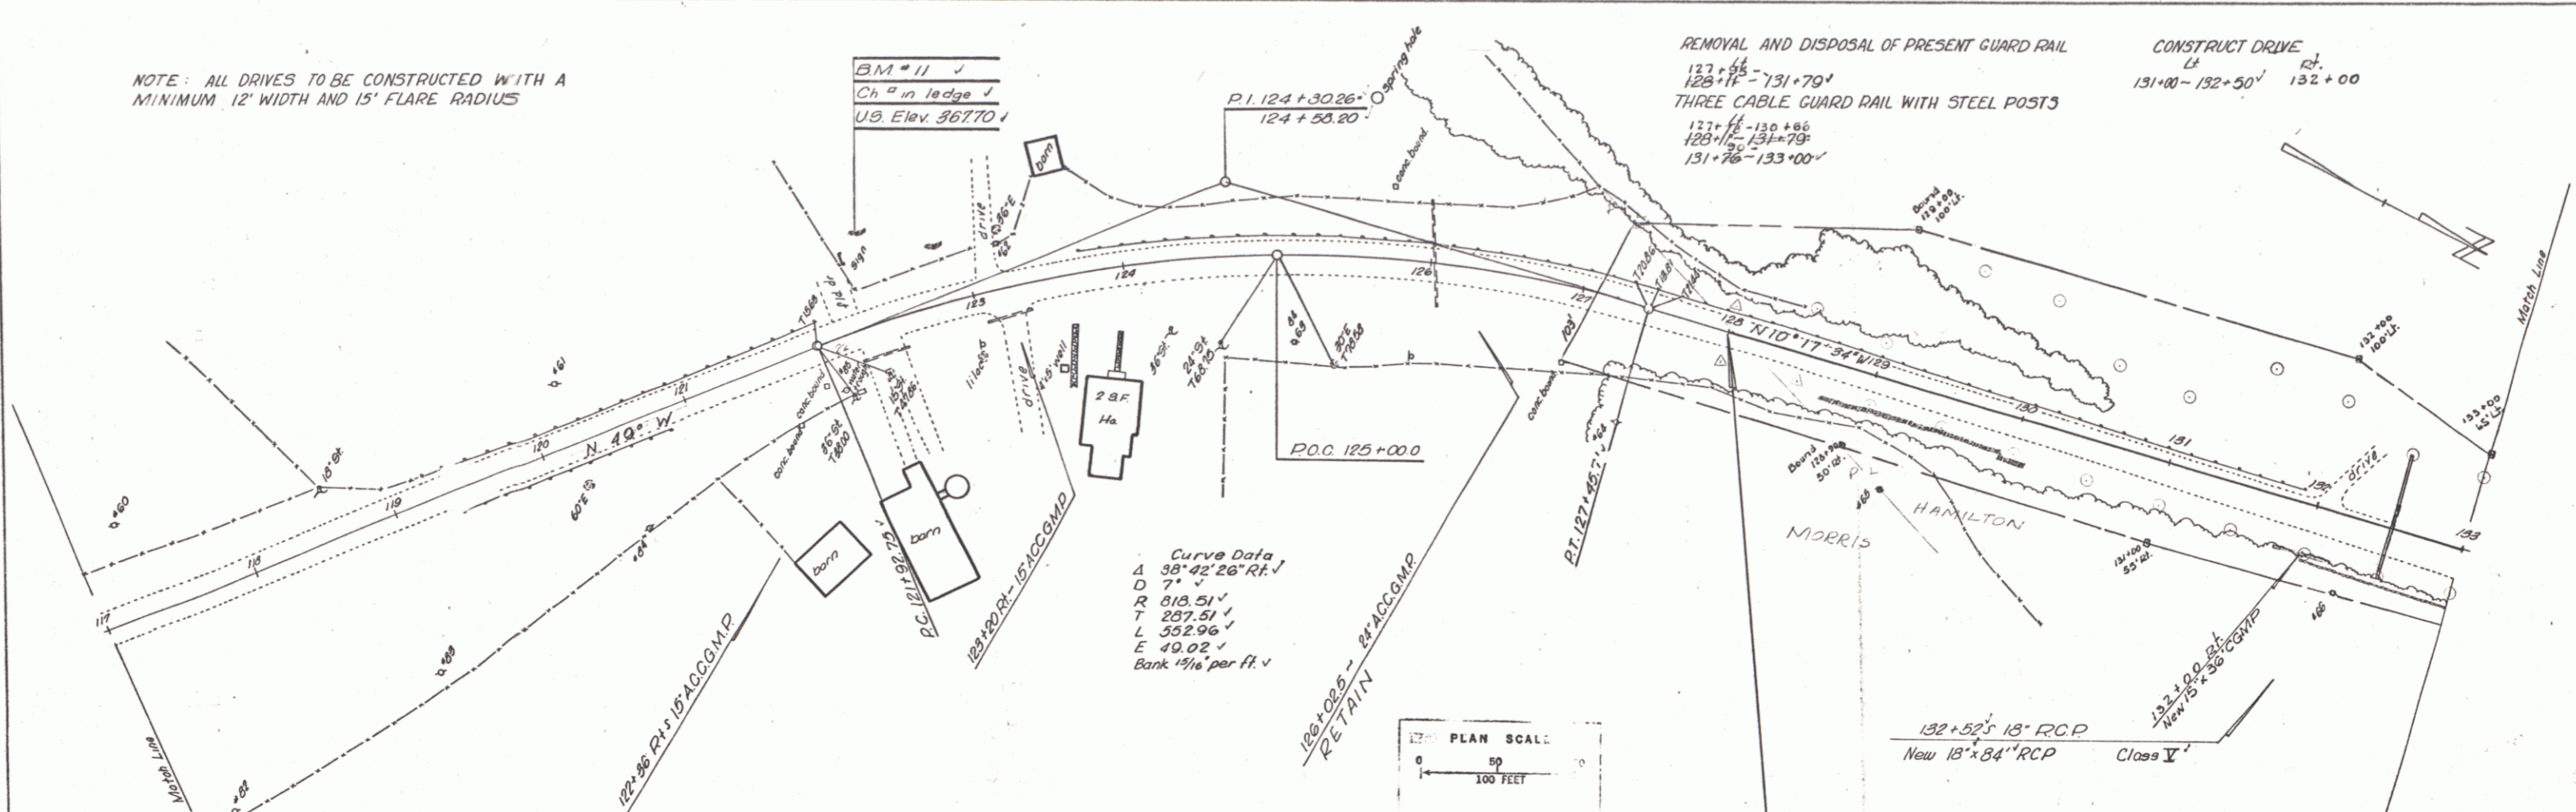

PROFILE  
DESIGNED BY  
CHECKED BY  
DATE  
NO.

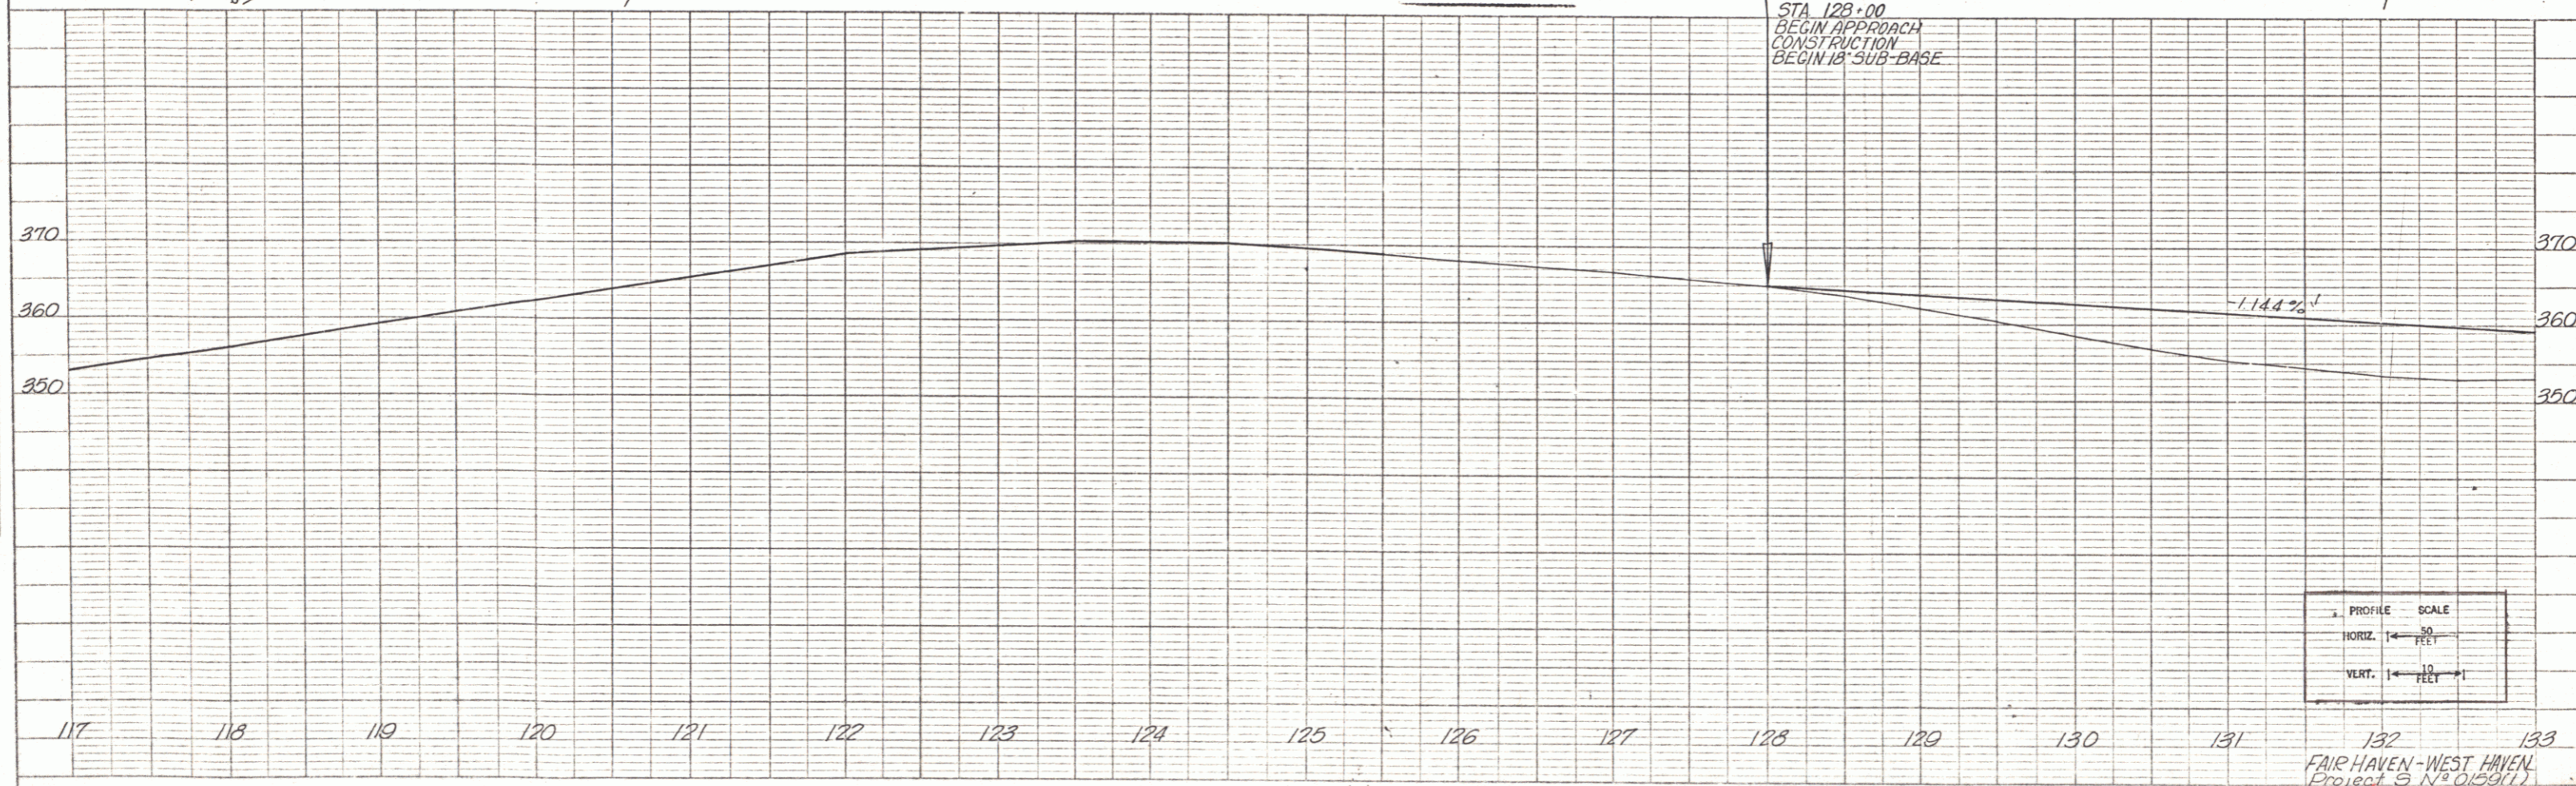


PLATE 1 - PLAN - PROFILE - D.P. & S.E. STANDARD  
REPRINTED & ADAPTED FROM  
R. E. & S. E. STANDARD  
NEW YORK

FAIR HAVEN - WEST HAVEN  
Project 8 N. O. 5011  
Sheet 28 of 77 sheets