

PLAN
 DATE BOOK NO. BY CHECKED BY
 1/1/55
 C.E.H.

PROFILE
 DATE BOOK NO. BY CHECKED BY
 1/1/55
 C.E.H.

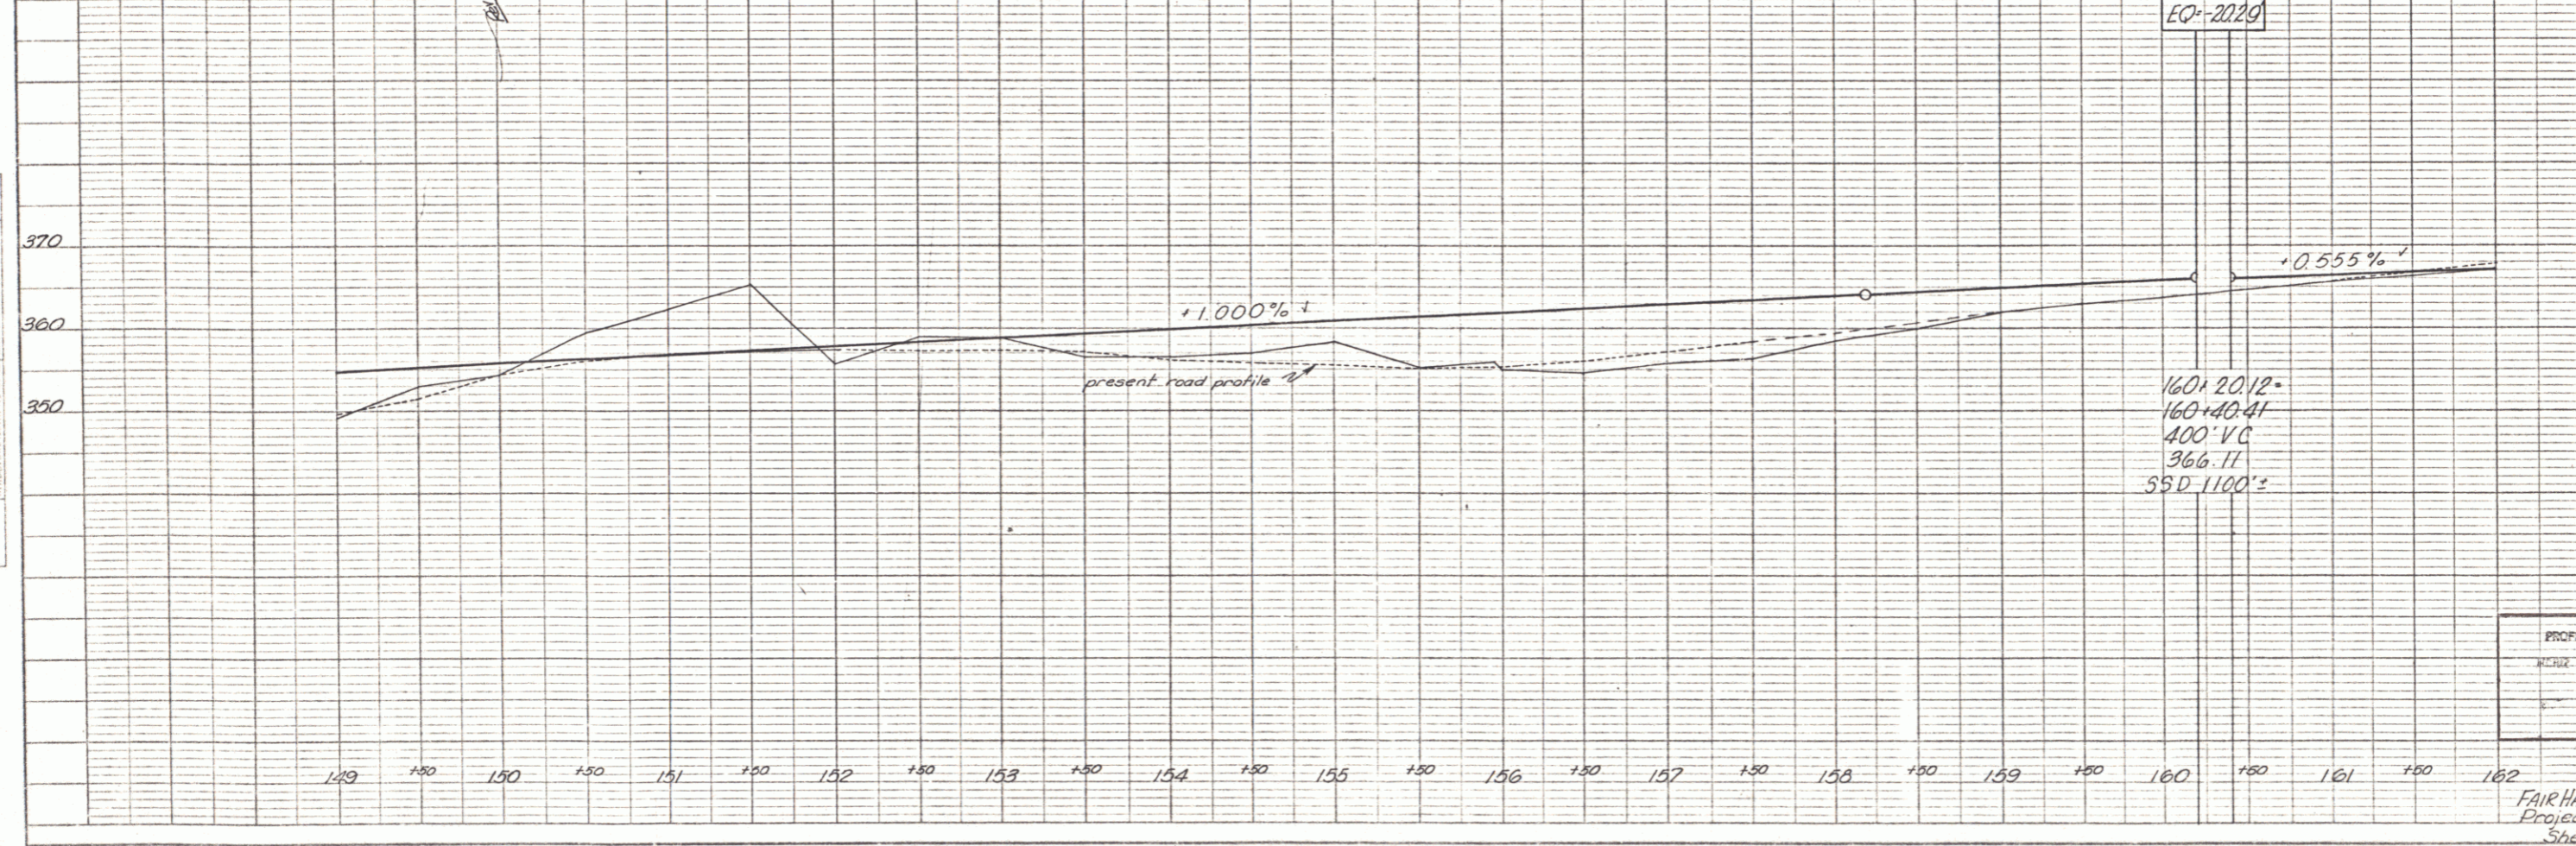
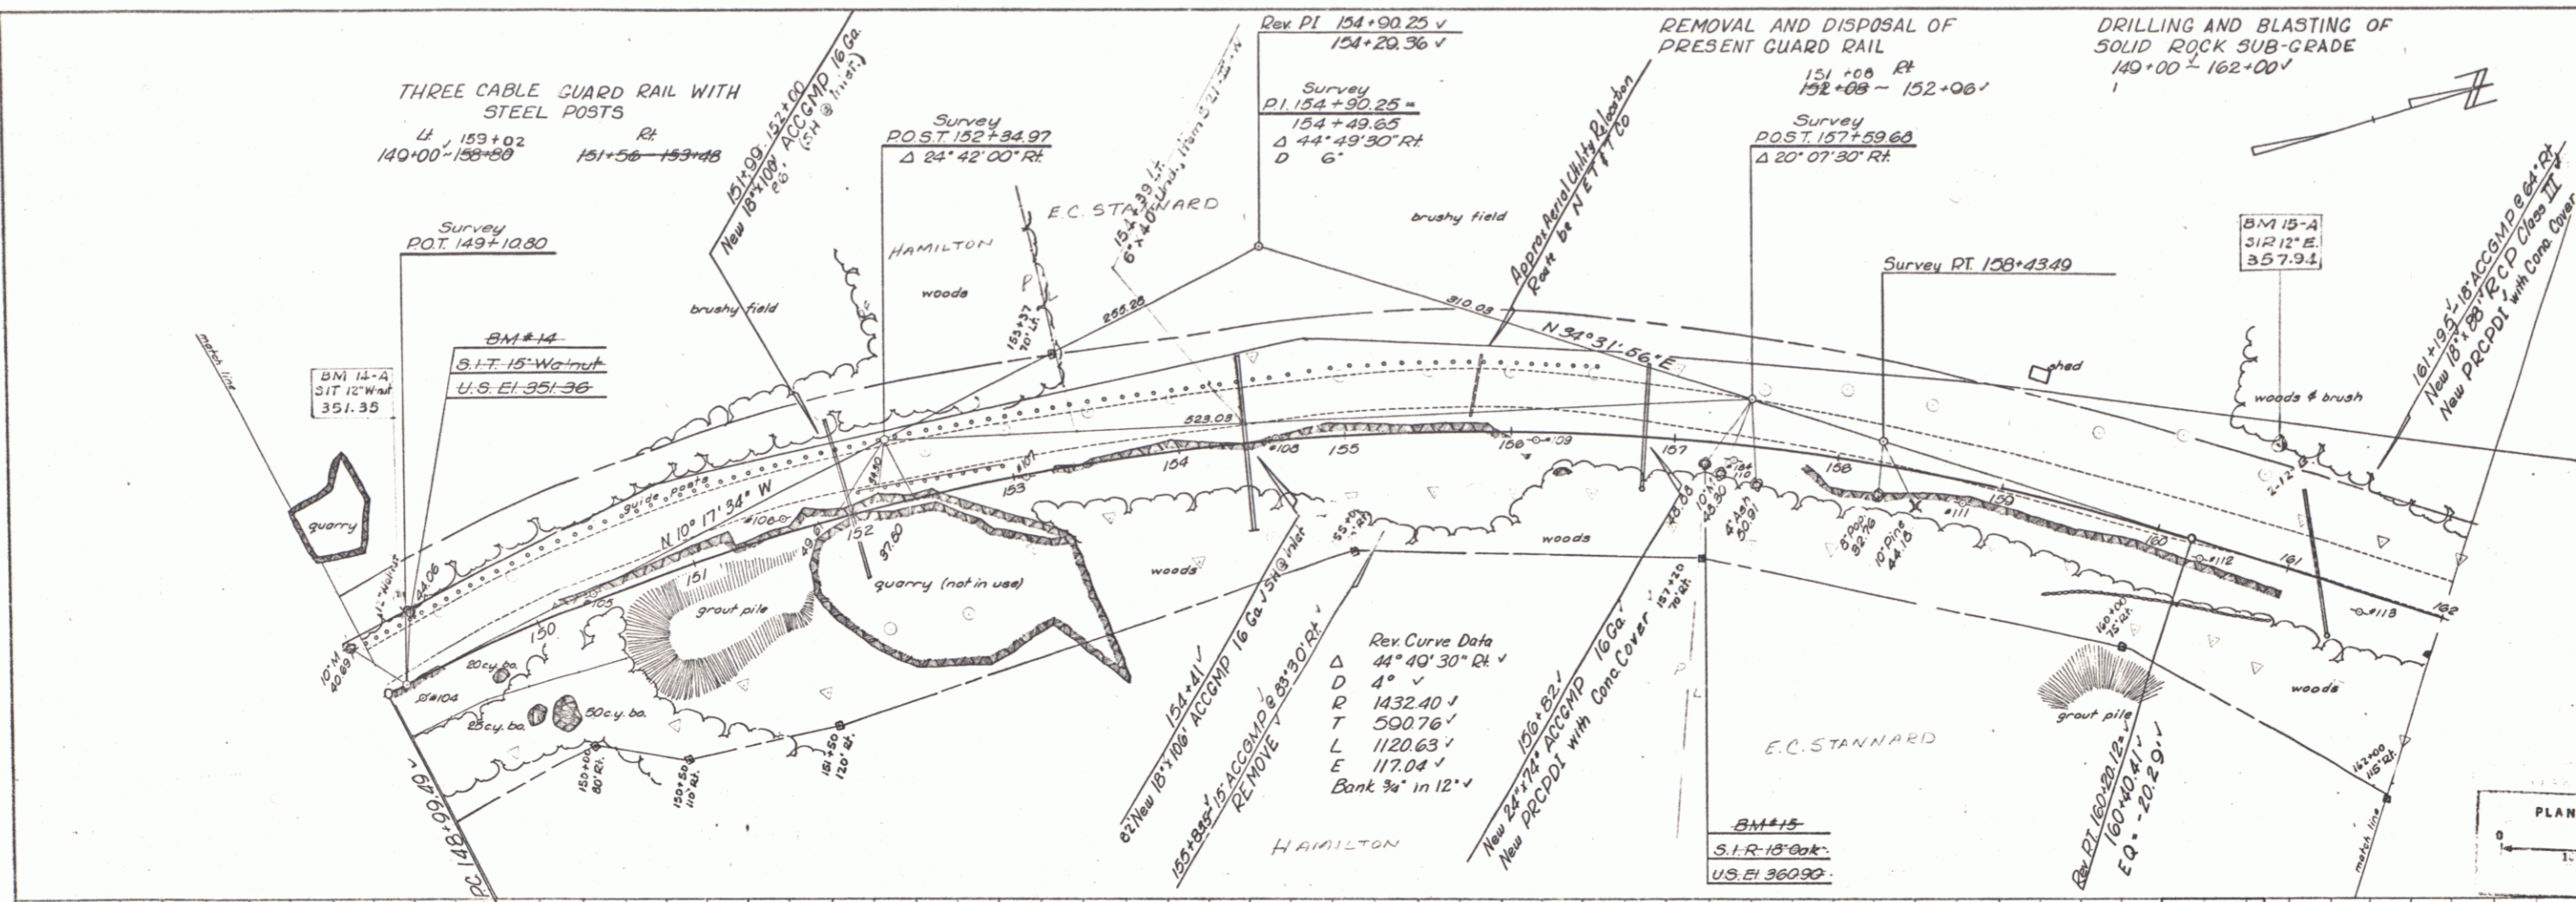


PLATE 1 - PLAN, PROFILE OF F.A.R. & E. STANNARD
 BEUTEL & CO. INC., NEW YORK
 S.E.E. 50' NO. 346-C
 1955