
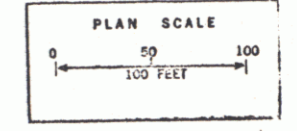


THREE CABLE GUARD RAIL WITH STEEL POSTS  
 165+05 LF 166+70 - 167+45  
 UNCLASSIFIED CHANNEL EXCAVATION  
 166+95 - 167+45  
 STONE FILL FOR SLOPE PROTECTION (LIGHT TYPE)  
 167+45 LF 166+95 - 167+45



CONSTRUCT APPROACH  
 LF 162+50  
 CONSTRUCT DRIVE  
 RT 166+00 - 169+00

DRILLING AND BLASTING OF SOLID ROCK  
 SUB-GRADE  
 162+00 - 165+70.50  
 171+50 - 174+00  
 BITUMINOUS CONCRETE CURB  
 ITEM 555 TYPE II  
 LF 162+85 - 164+50

PLAN  
 DATE: 7-65  
 DRAWN BY: W.S.S.  
 CHECKED BY: C.E.H.  
 NO. 17-65

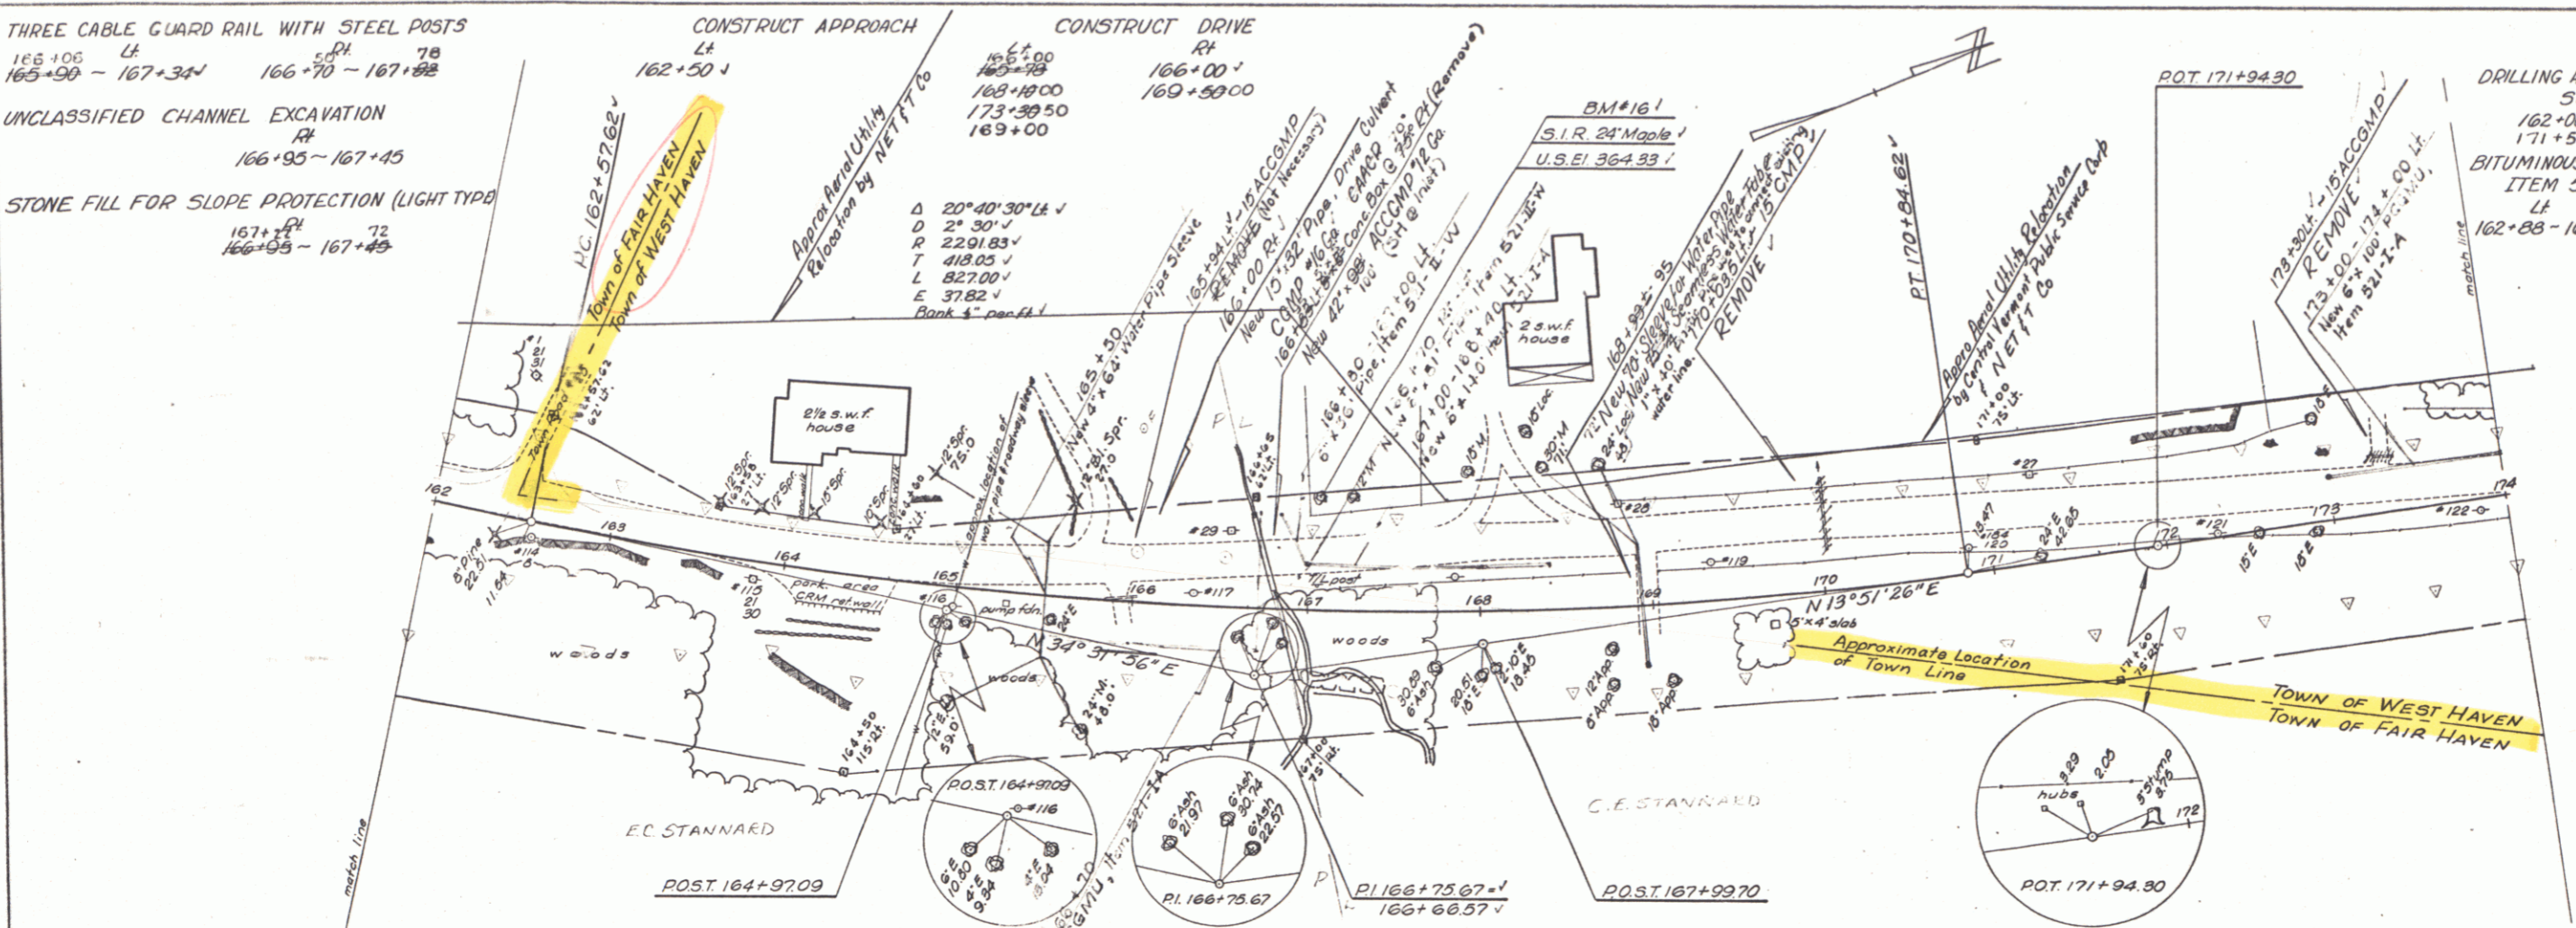

PROFILE  
 DATE: 7-65  
 DRAWN BY: W.S.S.  
 CHECKED BY: C.E.H.  
 NO. 17-65

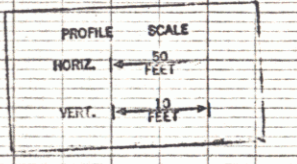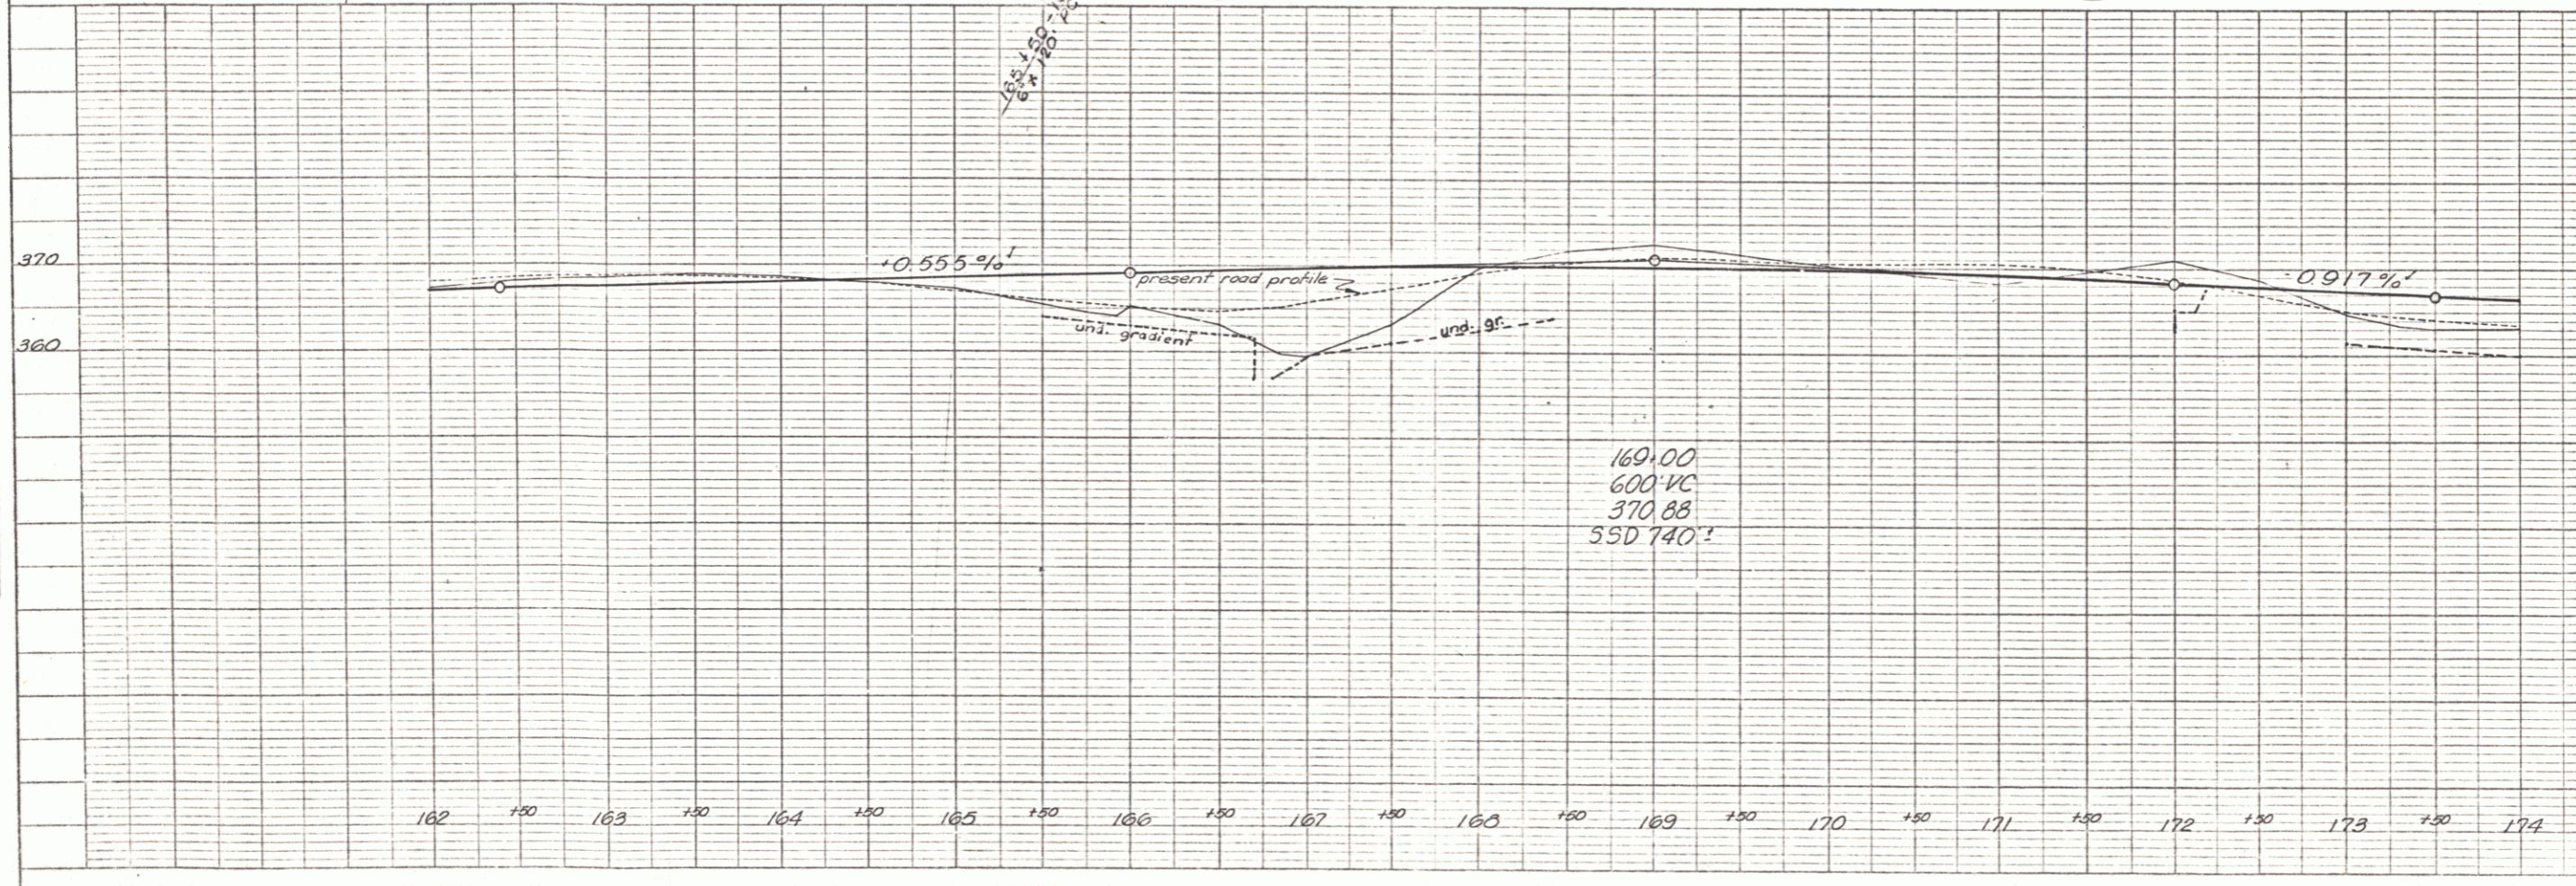

FAIR HAVEN - WEST HAVEN  
 Project S 18 0159(1)  
 Sheet 28 of 77

PLATE 3 - PLAN PROFILE - C.F. & E. STANDARD  
 KEPTON & CO. INC. NEW YORK  
 "KEEP TO THE LEFT"

4  
 5