


CONSTRUCT CLIMBING LANE
 218+00 L₁ - 228+00 L₁
 228+00 L₁ - 230+50 L₁ (transition)

DRILLING AND BLASTING OF SOLID ROCK
 SUB-GRADE
 218+25 - 226+75
 231+00 - 234+00

THREE CABLE GUARD RAIL
 WITH STEEL POSTS
 L₁ 227+90
 R₁ 227+50 - 228+94
 226+70 - 229+56

TREATED TIMBER CURB
 (PAVED SHOULDERS)
 L₁ 227+74 - 234+00
 R₁ 227+50 - 228+94

DRILLING AND BLASTING OF
 SOLID ROCK - ITEM 114
 226+00 L₁ - 227+50 L₁
 231+00 - 234+00

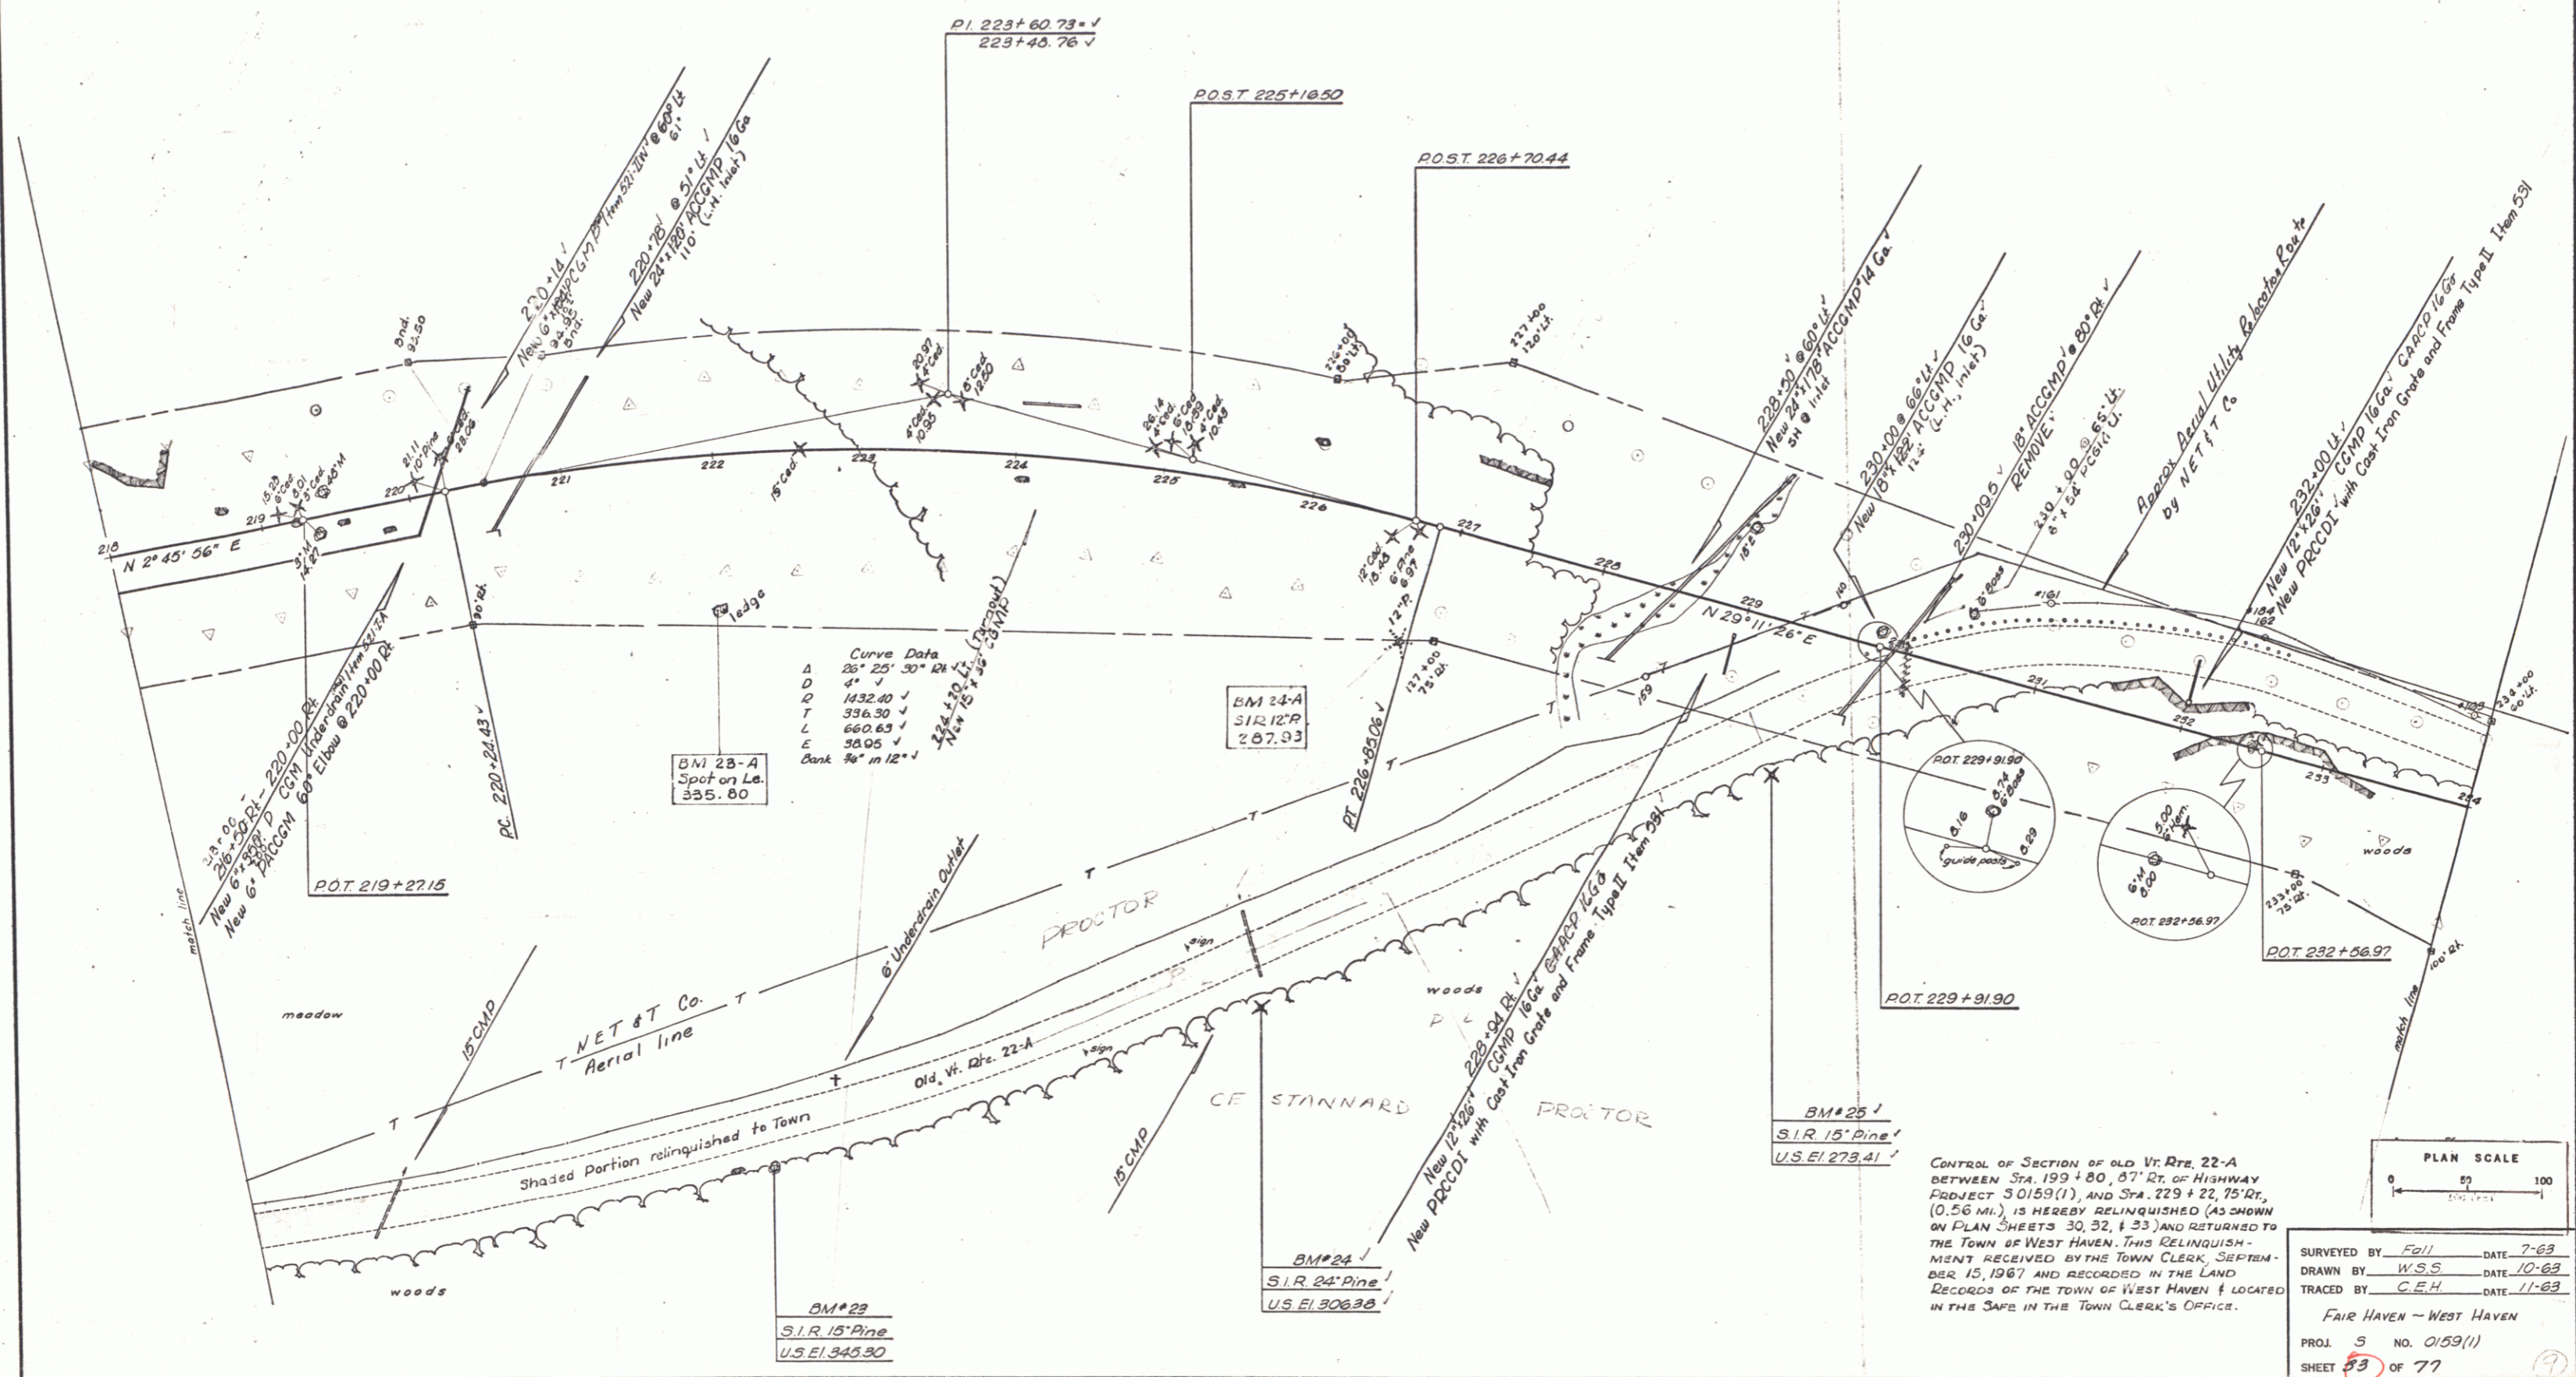

CONTROL OF SECTION OF OLD VT. RTE. 22-A
 BETWEEN STA. 199+80, 87' RT. OF HIGHWAY
 PROJECT 30159(1), AND STA. 229+22, 75' RT.,
 (0.56 MI.) IS HEREBY RELINQUISHED (AS SHOWN
 ON PLAN SHEETS 30, 32, & 33) AND RETURNED TO
 THE TOWN OF WEST HAVEN. THIS RELINQUISH-
 MENT RECEIVED BY THE TOWN CLERK, SEPTEM-
 BER 15, 1967 AND RECORDED IN THE LAND
 RECORDS OF THE TOWN OF WEST HAVEN & LOCATED
 IN THE SAFE IN THE TOWN CLERK'S OFFICE.

SURVEYED BY: Fall DATE: 7-63
 DRAWN BY: W.S.S. DATE: 10-63
 TRACED BY: C.E.H. DATE: 11-63
 FAIR HAVEN - WEST HAVEN
 PROJ. 5 NO. 0159(1)
 SHEET 33 OF 77