



15

THREE CABLE GUARD RAIL WITH
STEEL POSTS
Lt
185+60-186+00

CONSTRUCT DRIVE
Lt Rr
177+68 179+50
183+00

REMOVAL AND DISPOSAL OF
PRESENT GUARD RAIL
Lt Rr
182+40-182+34 182+16-182+40

DRILLING AND BLASTING OF SOLID
ROCK SUB-GRADE
176+00

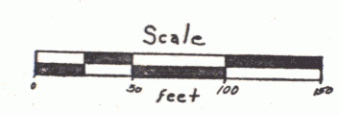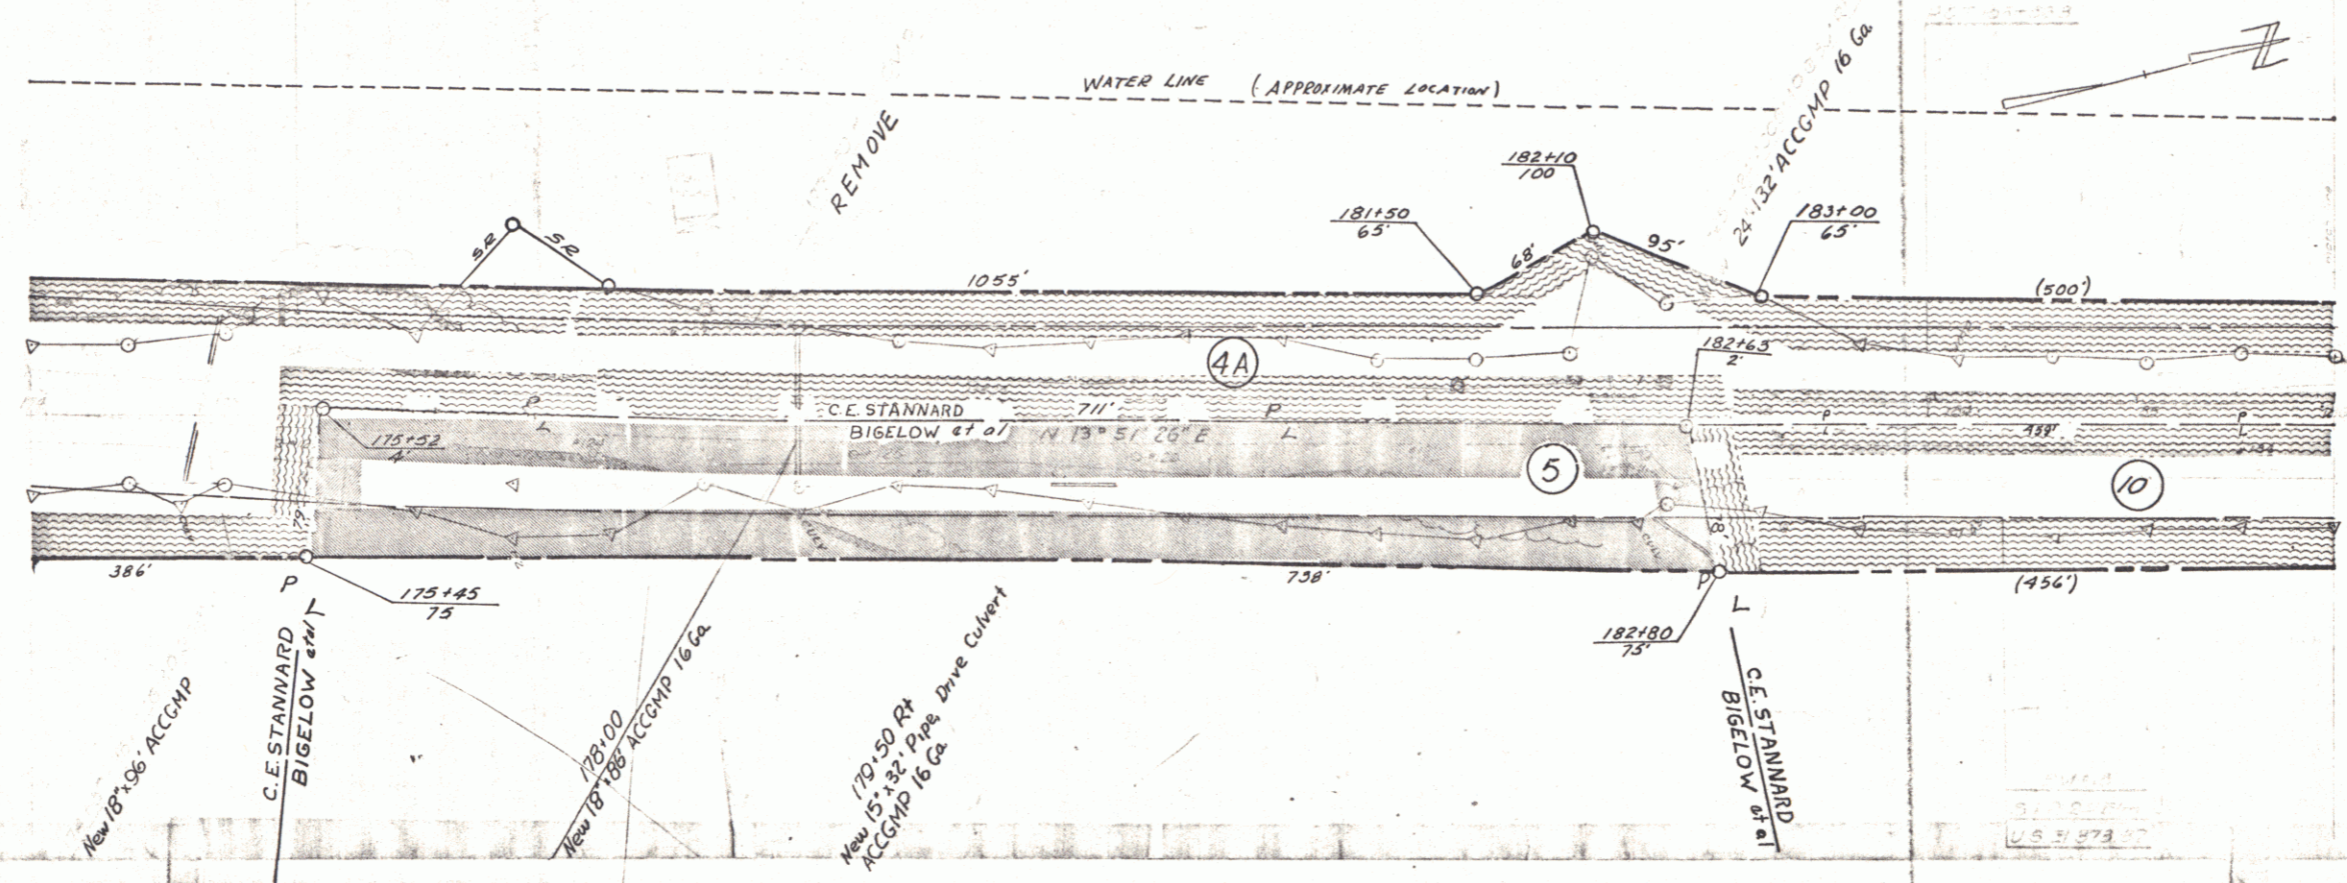

VERMONT DEPARTMENT OF HIGHWAYS
 RIGHT-OF-WAY PLANS
 PROJECT: FAIR HAVEN — WEST HAVEN
 No. S 0159 (1)
 SHEET 17 OF 18

15