
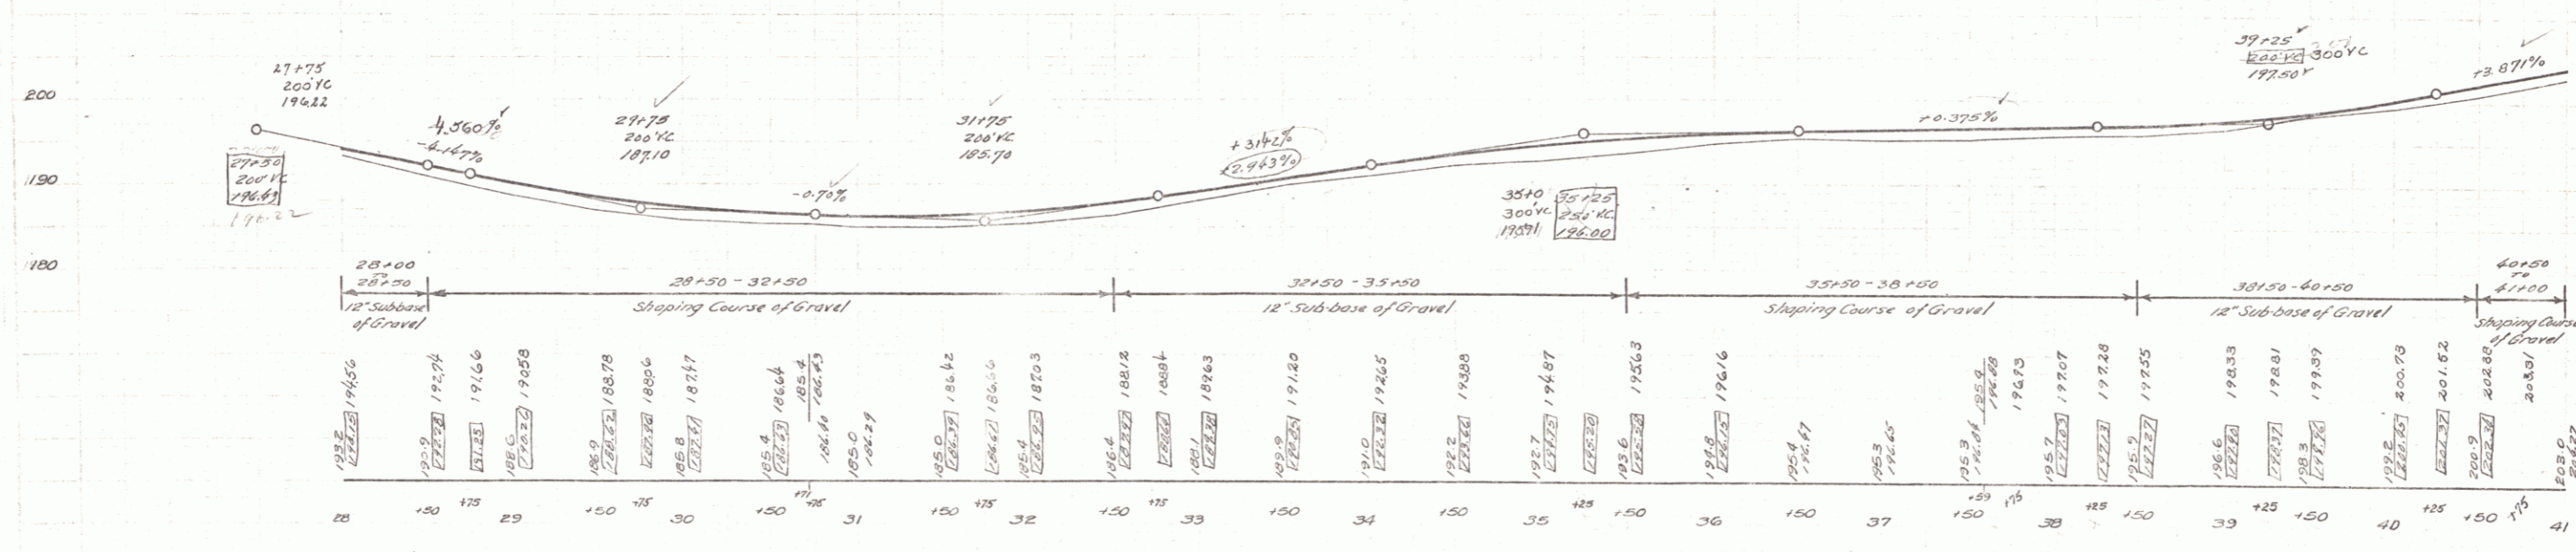


4 1/2 ft
 12" Sub-base of Gravel
 18" Sub-base of Gravel
 12" Sub-base of Gravel
 18" Sub-base of Gravel

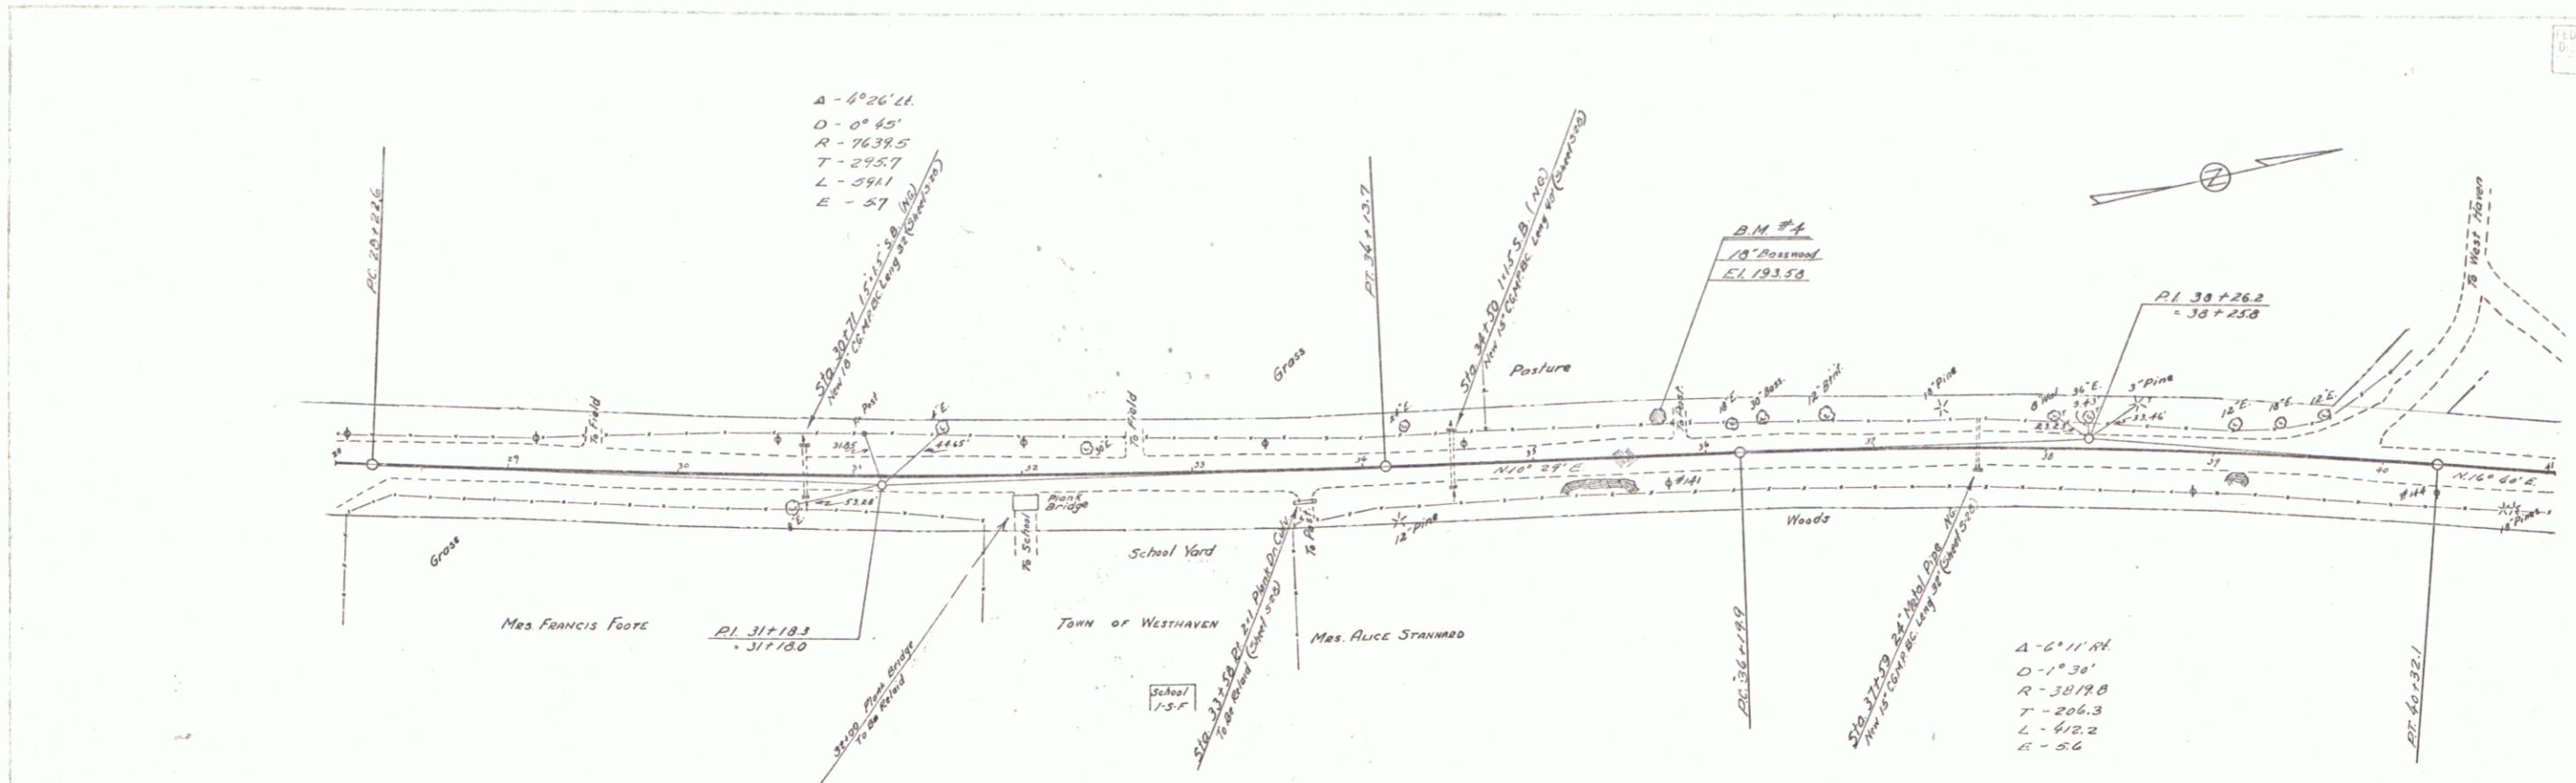

B.M. #4 SPINE IN ROOT OF 18'-GASS 1917. IN STA. 35+111 ELEV. 193.58