


Aultram
 F. Hyman
 Griggs
 720000

113100
 208' VC
 38.10

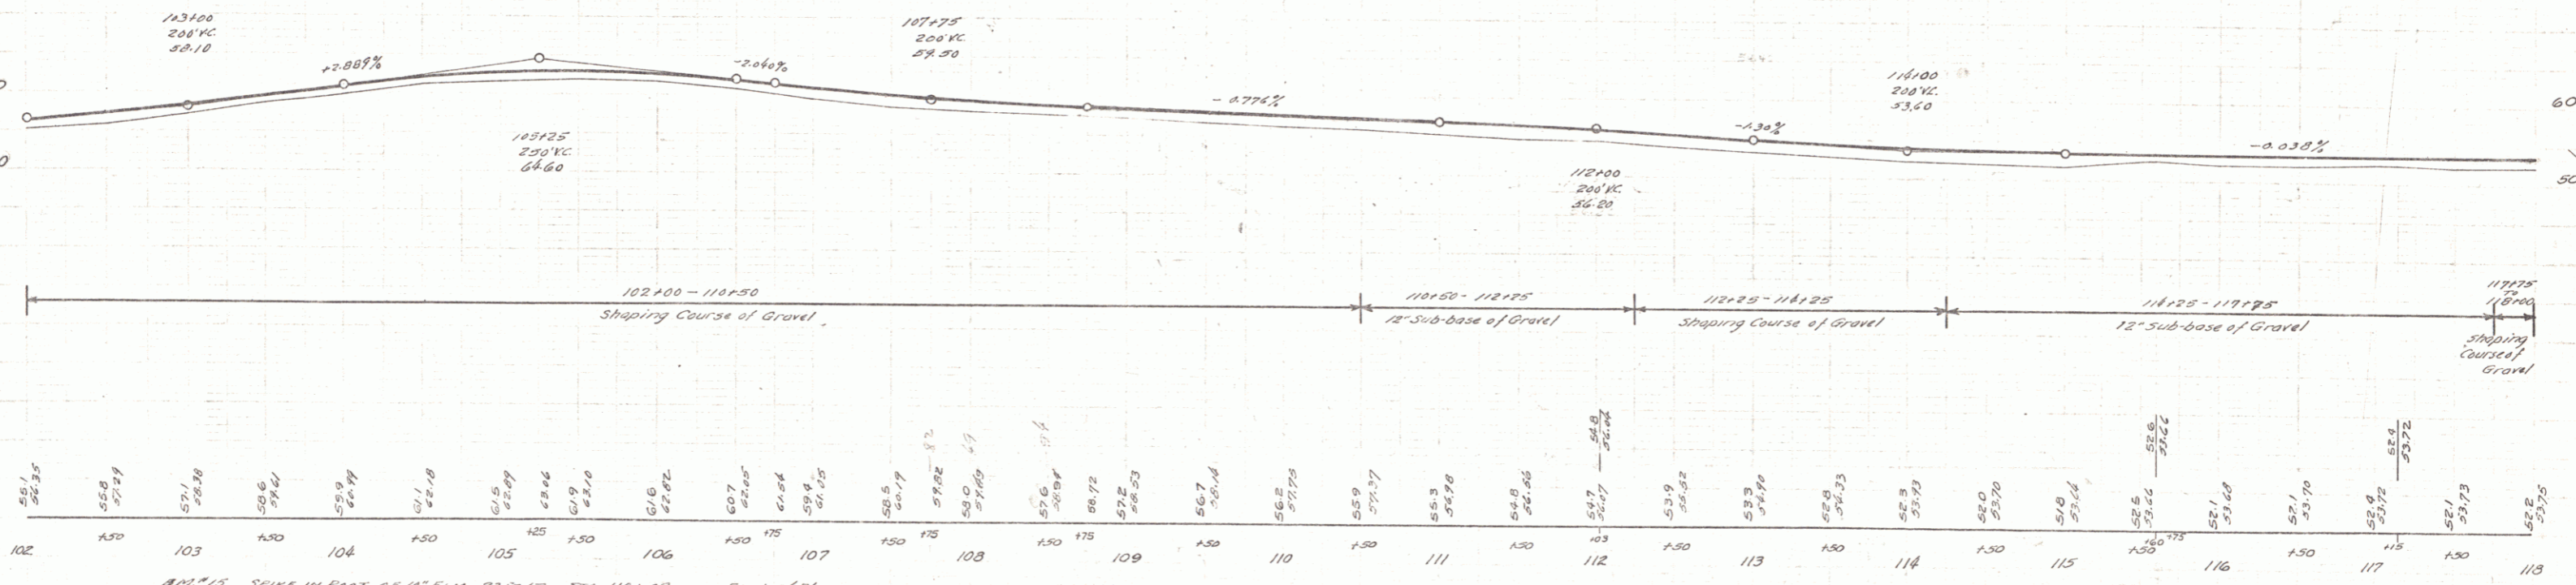

B.M. #15 SPINE IN ROOT OF 18' ELM 23' 24" LT. STA. 110+09 ELEV. 54.74
 B.M. #16 " " TOP OF 24' ELM STUMP 22' 11" STA. 117+85 ELEV. 54.18