


STA 280+78
NOTE:
Where box culverts are to be extended, extension is to dowel to existing structure with 3/8" deformed bars at long ends. These dowels to extend into existing structure a minimum of 12". Drilling, placing and grouting to be included in bid price for reinforcing steel. Care to be taken in constructing the inlet of the culvert.

BM 35
12" ELM
EL. 75.21

Δ 1°-49'12"
D 1°
R 5729.7
T 90.8
L 18.6
E 0.7

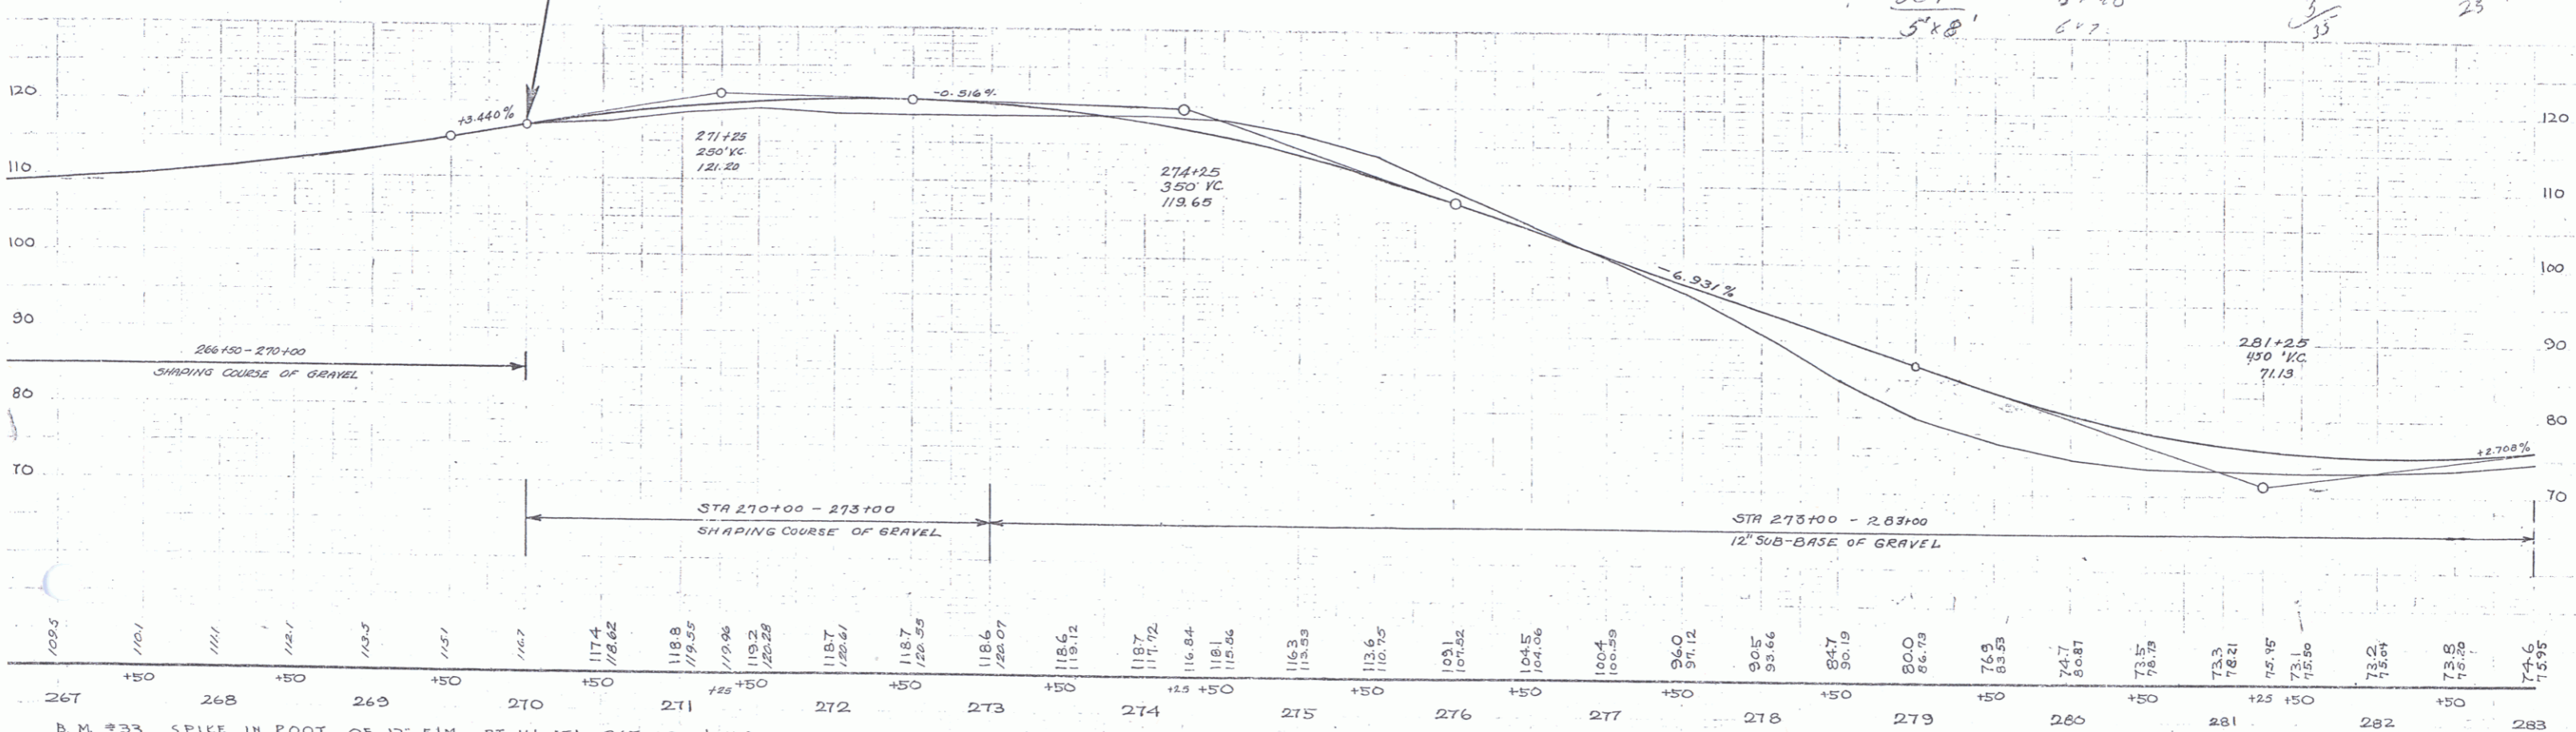

B.M. #33 SPIKE IN ROOT OF 12" ELM AT 16' STA. 267+89 EL. 109.58
B.M. #34 SPIKE " " 12" ELM LT 28' STA. 274+86 EL. 117.35
B.M. #35 PT. SPOT ON RT. RAIL CONC. BRIDGE AT 115' STA. 280+83 EL. 75.21

SERIES NRS No 146B (1935)
SHEET 7 OF 26

7