
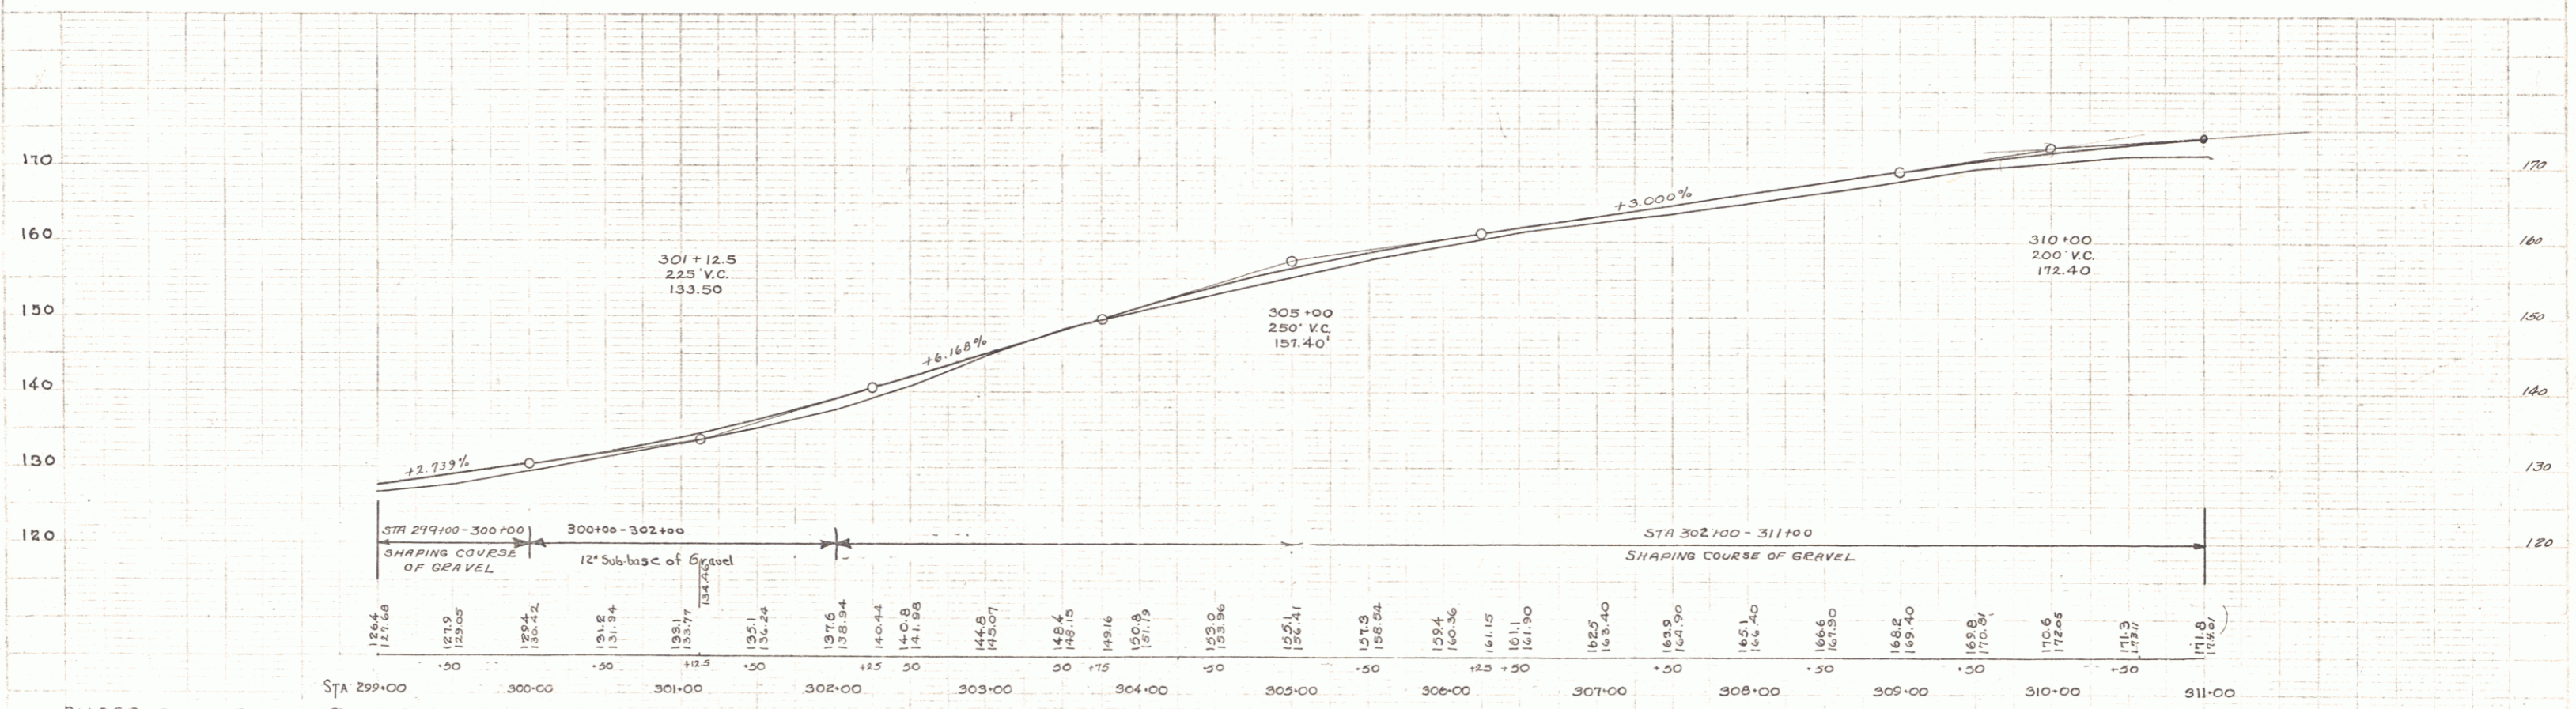


BARRETT
 WOOD
 PARKER

BARRETT
 WOOD

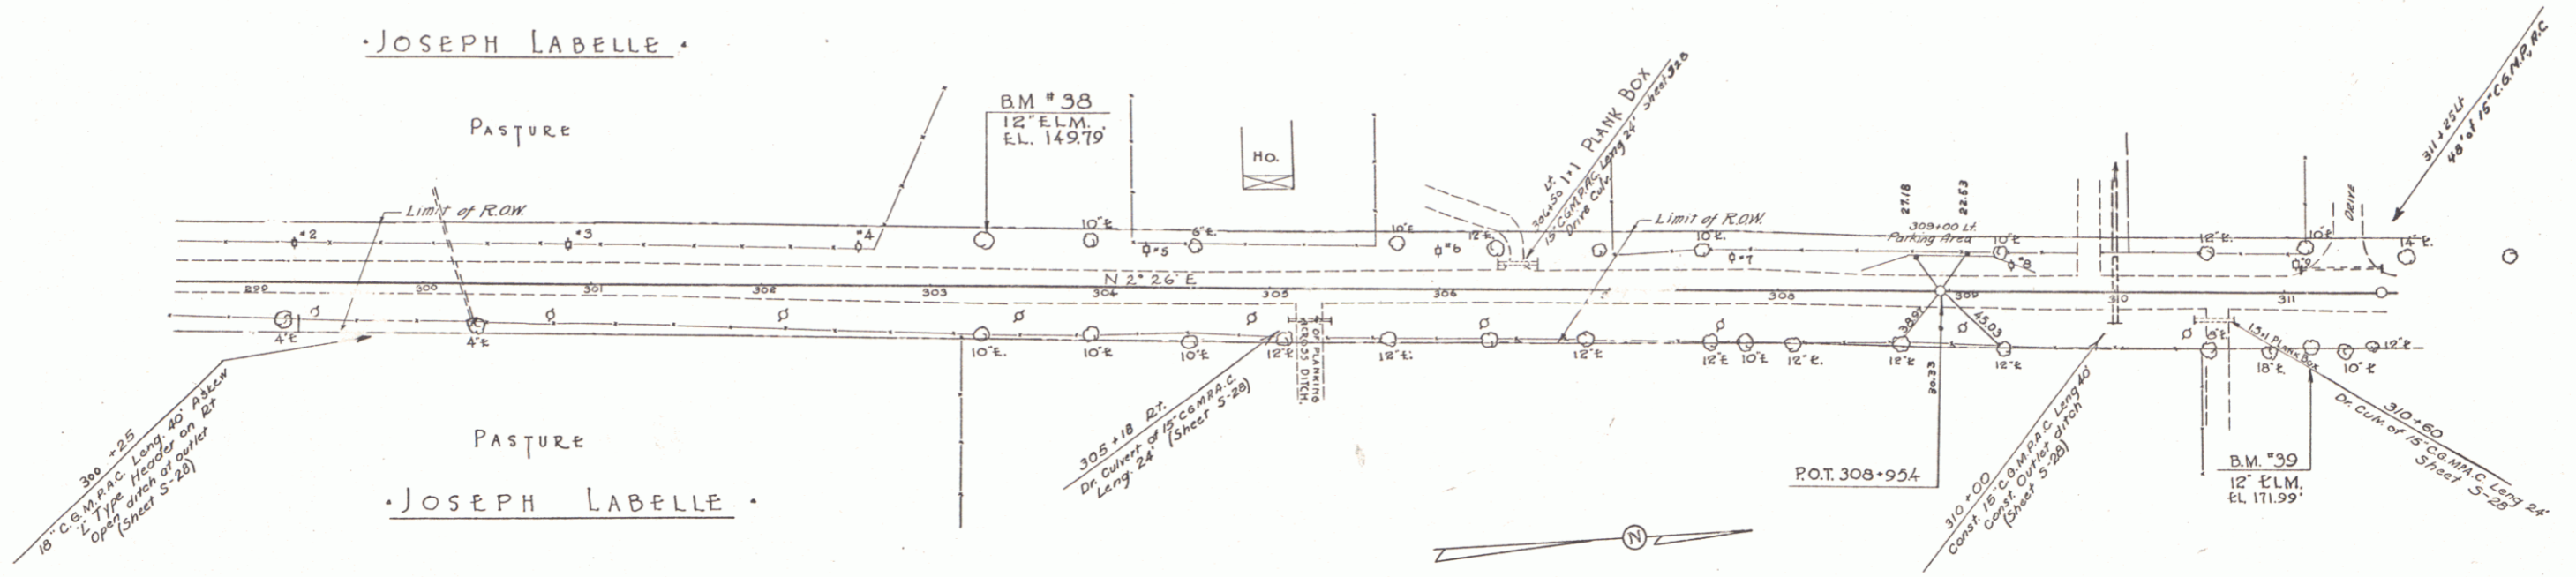

B.M. #38 SPIKE IN ROOT OF 12' ELM. 23' LT. OF STA. 303+35 EL. 149.79.
 B.M. #39 SPIKE IN ROOT OF 12' ELM. 305' RT. OF STA. 311+13 EL. 171.99.