
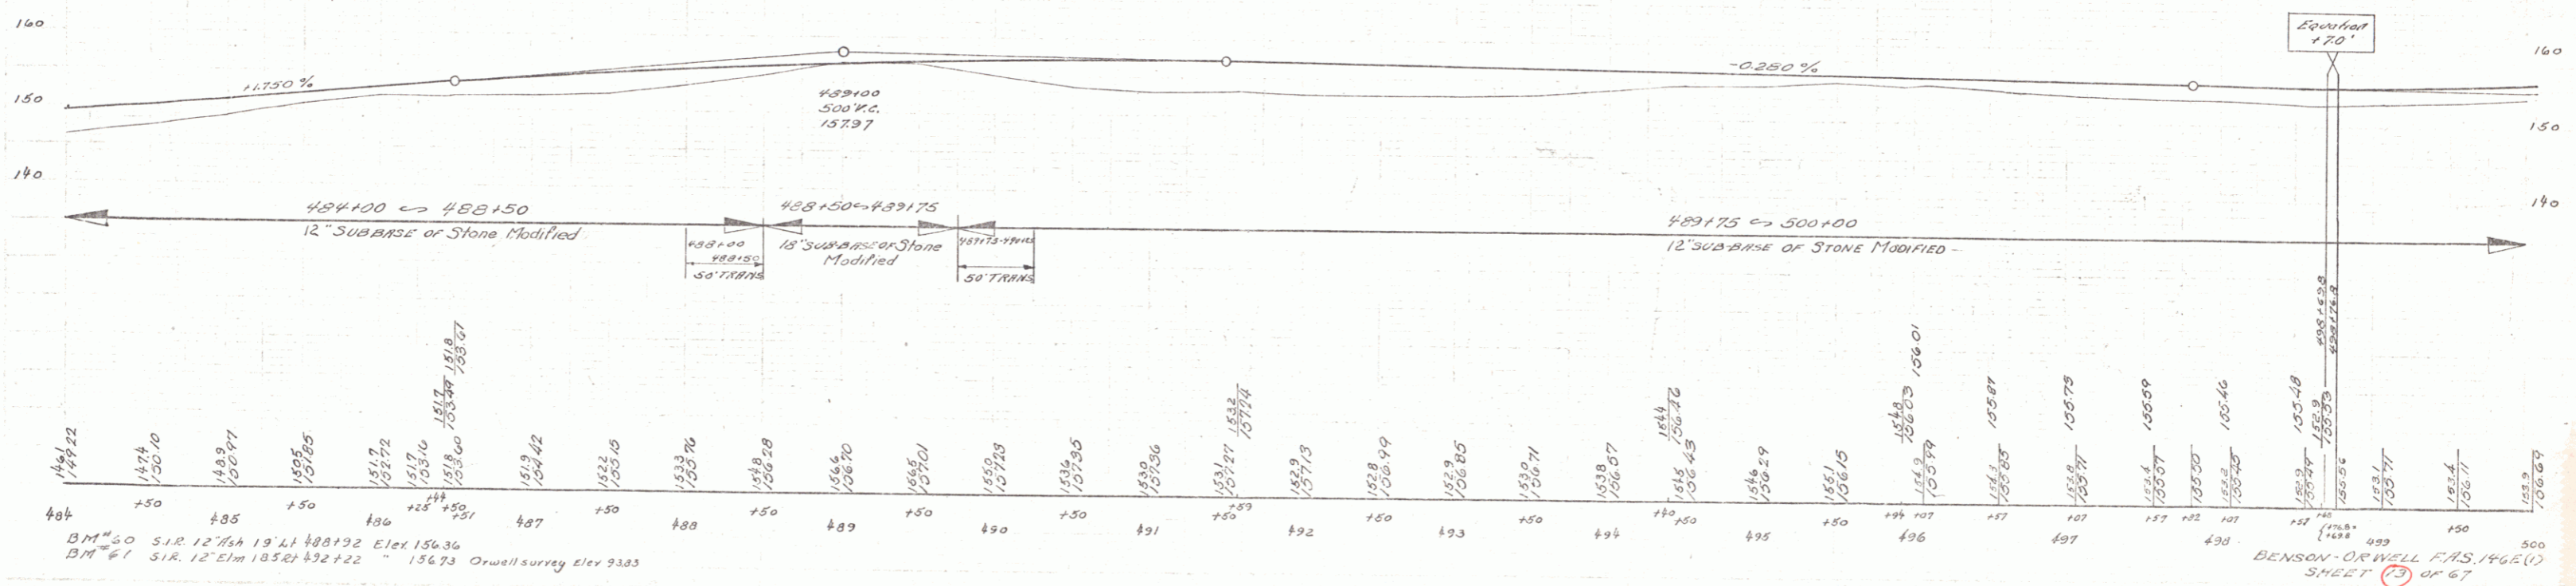


PARCEL	INSTRUMENT	DATE	GRANTOR	GRANTEE	RECORDED	REMARKS
A	V.D.O.E.	8-31-60	HENRY E. ERNEST VOLCOTT	ST OF VT	BOOK 19 PAGE 22	DATE 3-6-60
A, B	V.D.O.E.	7-24-60	PAUL PINDERS	ST OF VT	19 16	7-31-60

NOTE: 314 495.194 ft. Town & County markers to be relocated as directed by the Engineer. Payment to be made as extra work.

FR. G. 146(E) 1941 13 67

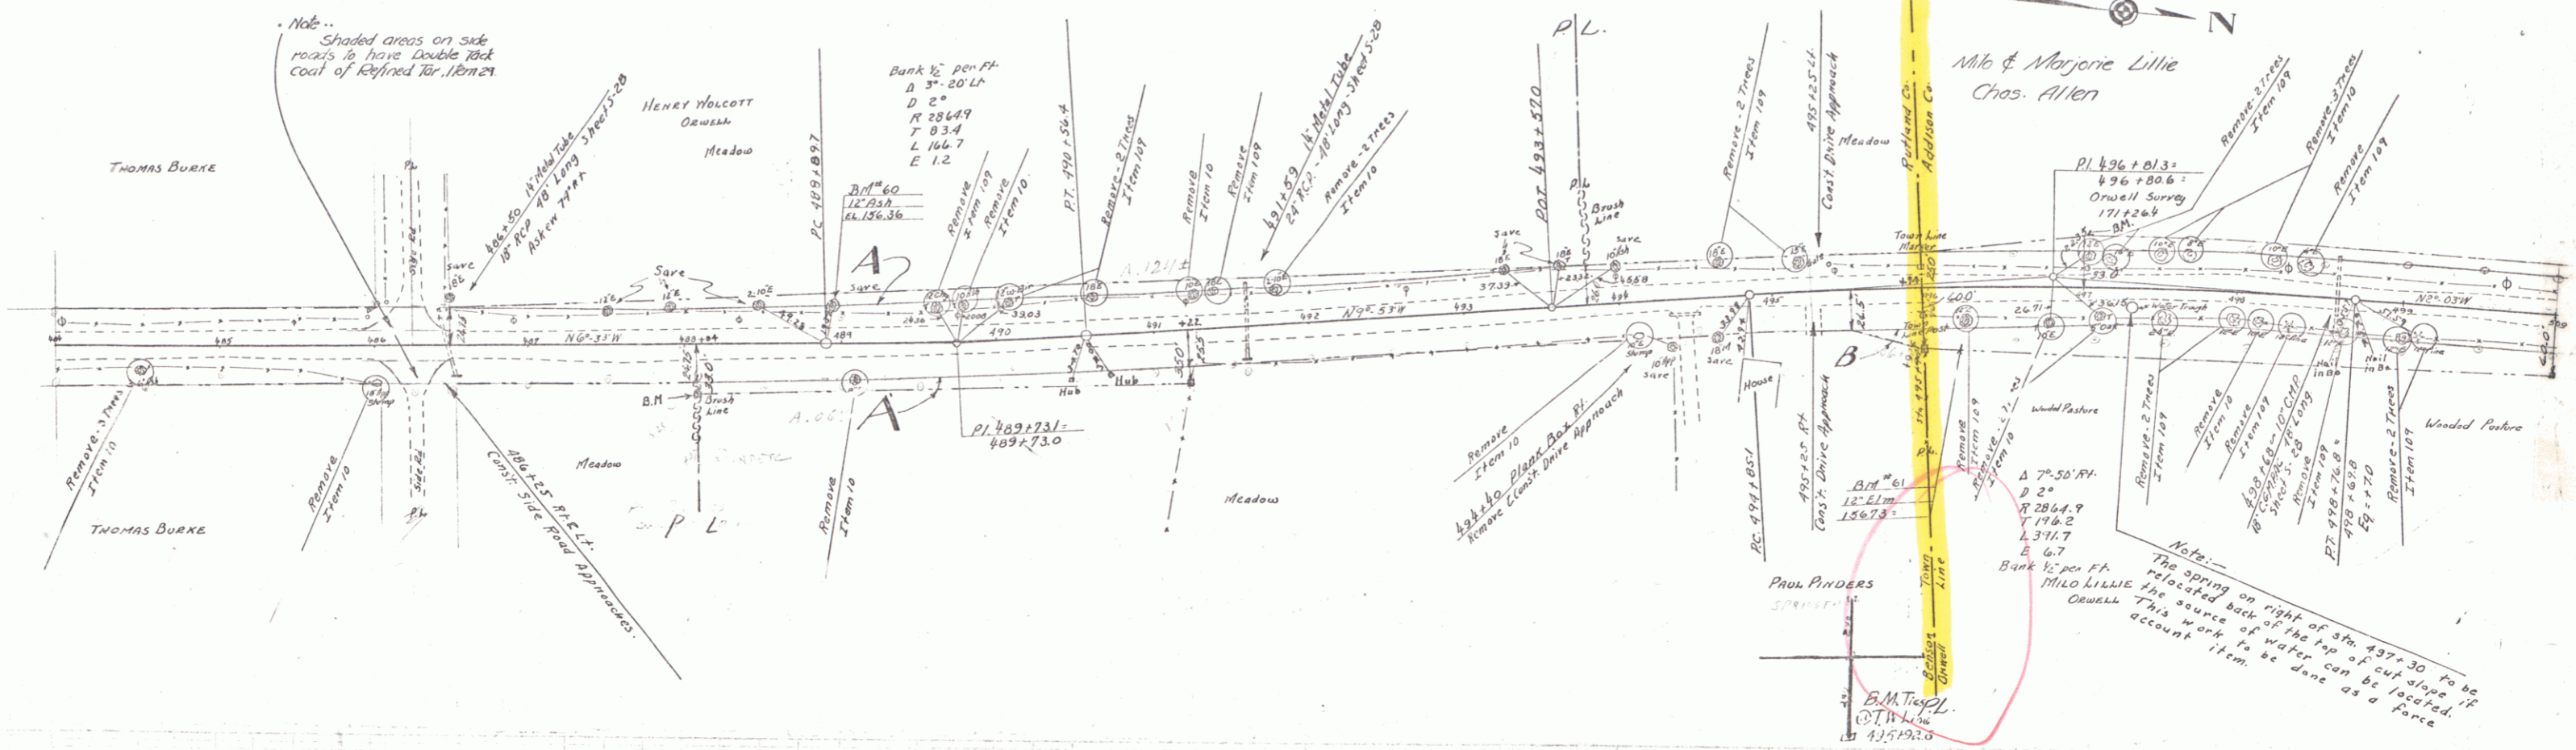

BM #60 S.I.R. 12' 7/8" 19' 11" 488192 Elev 156.36
 BM #61 S.I.R. 12' 11" 18' 52" 432122 Elev 156.73 Orwell survey Elev 93.83

BENSON-ORWELL F.A.S. 1966 (1) SHEET 13 of 67