
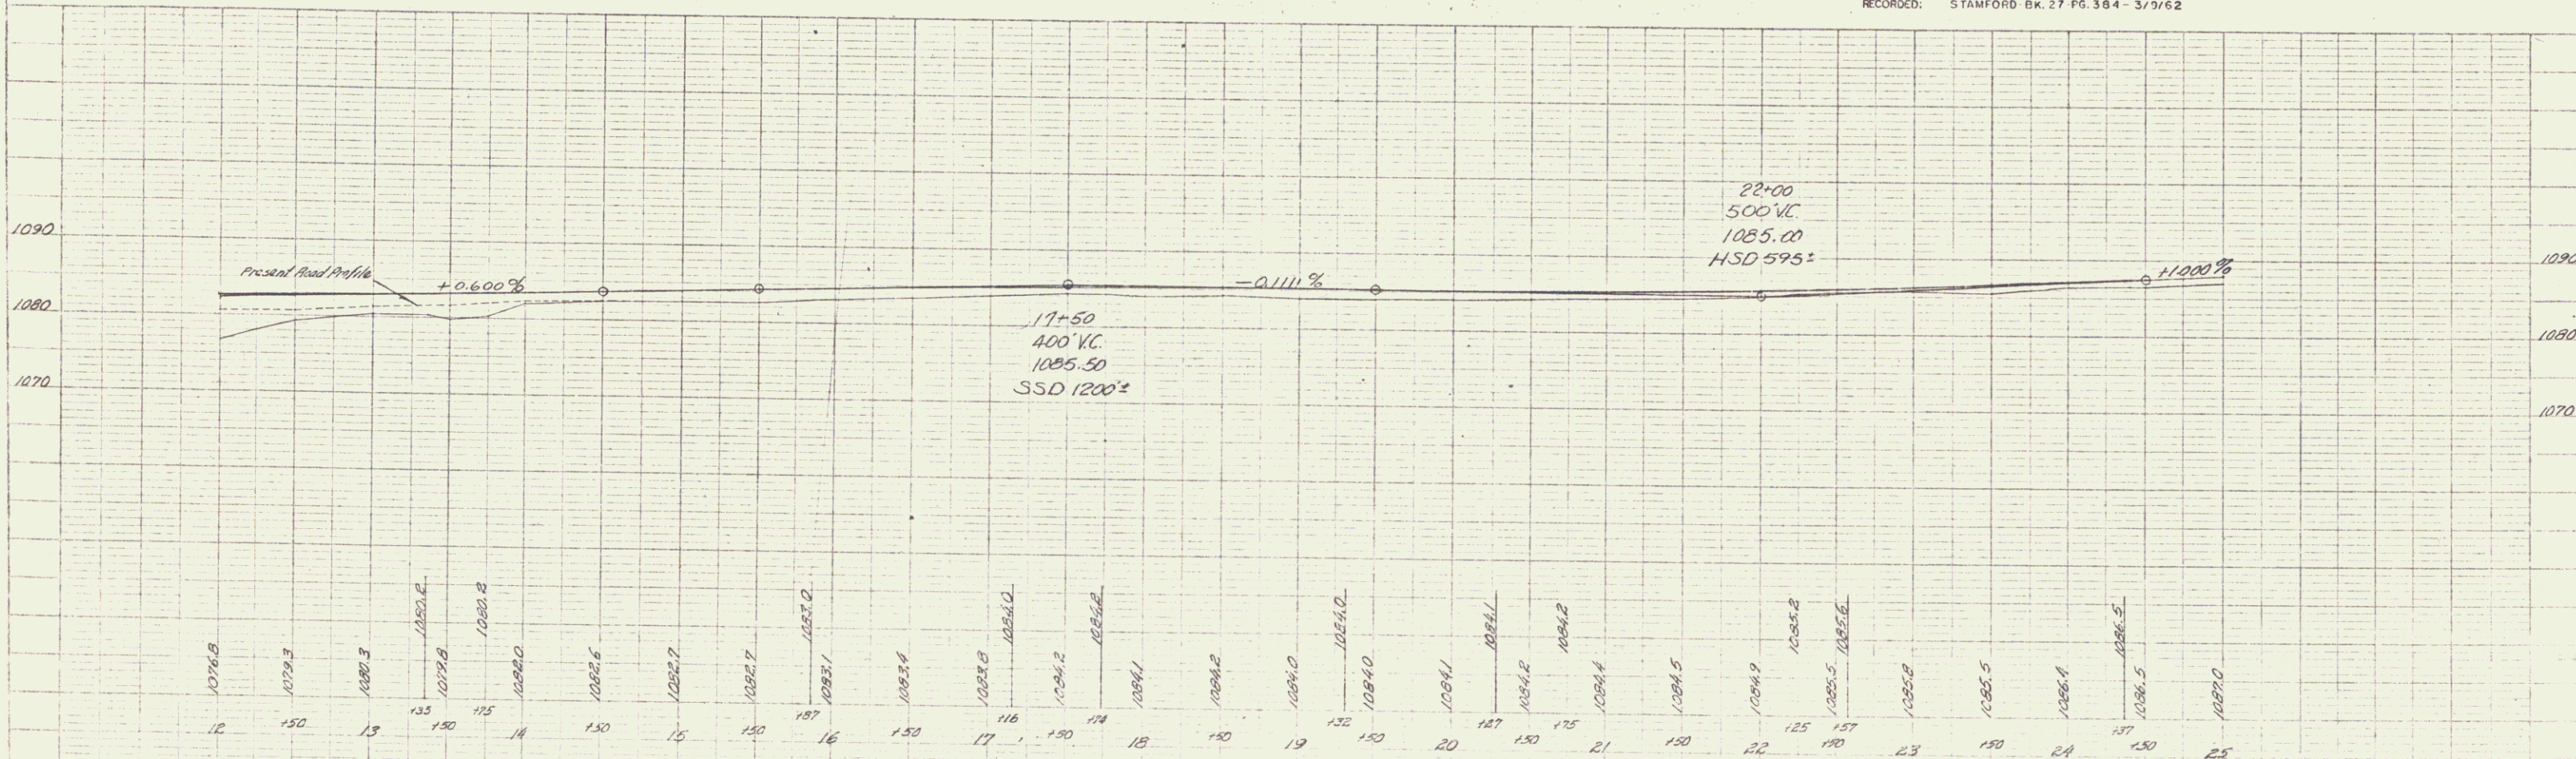


PLAN
 1969
 H. CHARLES
 1969
 H. CHARLES

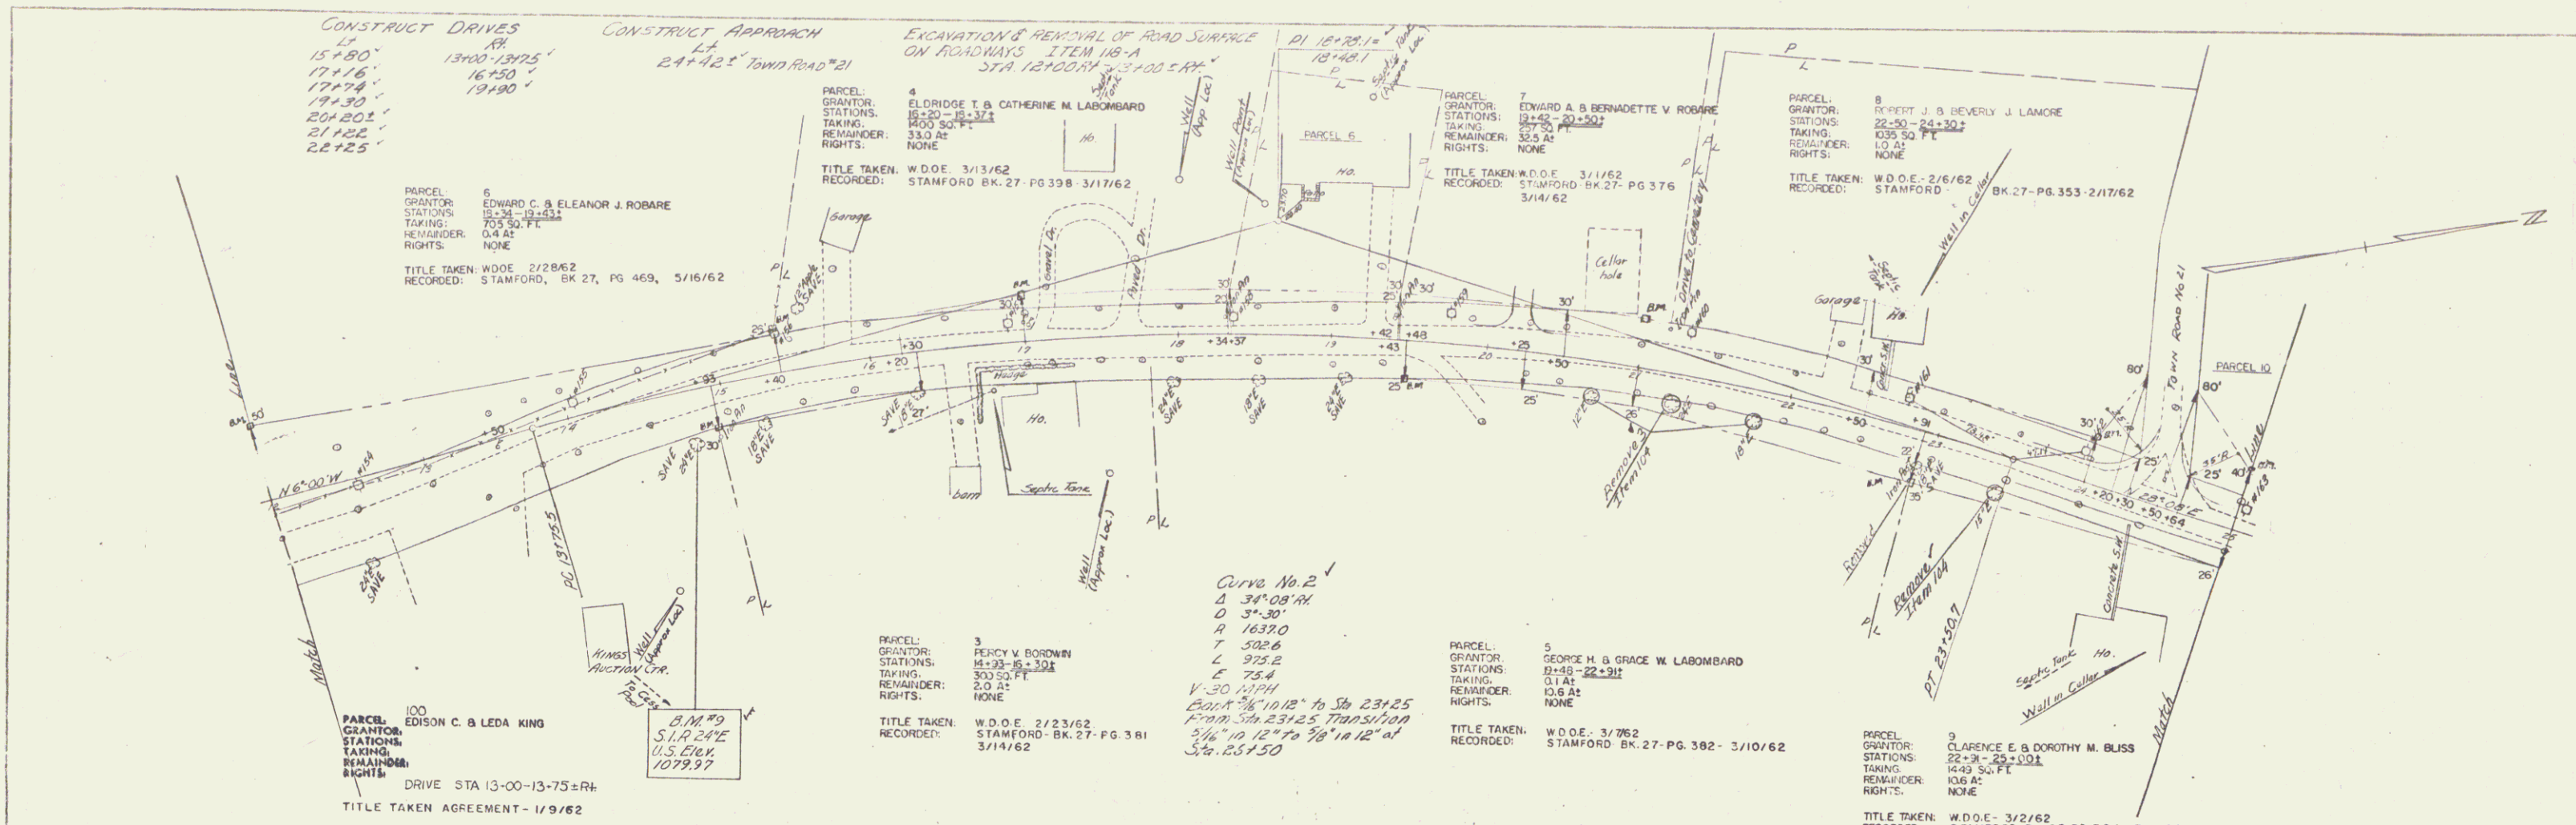

STAMFORD
 No. 5-0102(c)
 Sheet 27 of 151