
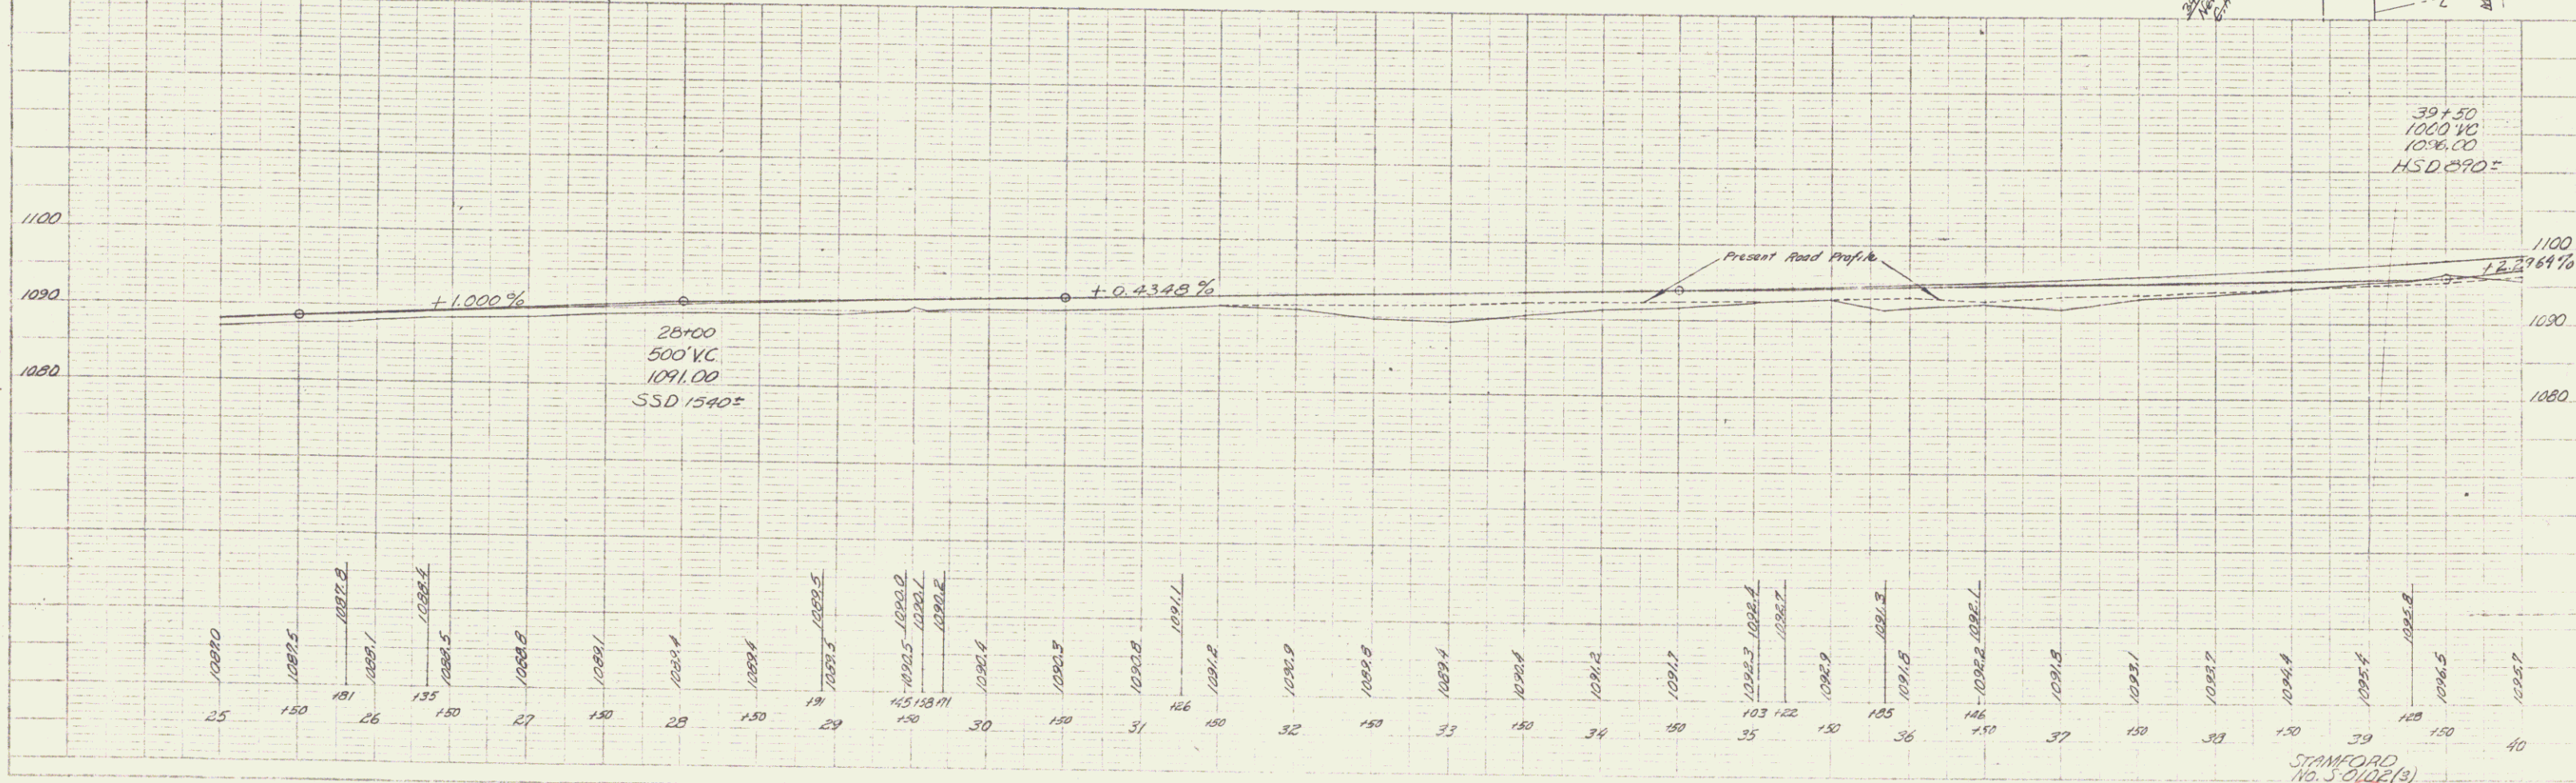


PLAN
 1959
 H. CHWILES
 1960

PROFILE
 1959
 H. CHWILES
 1960

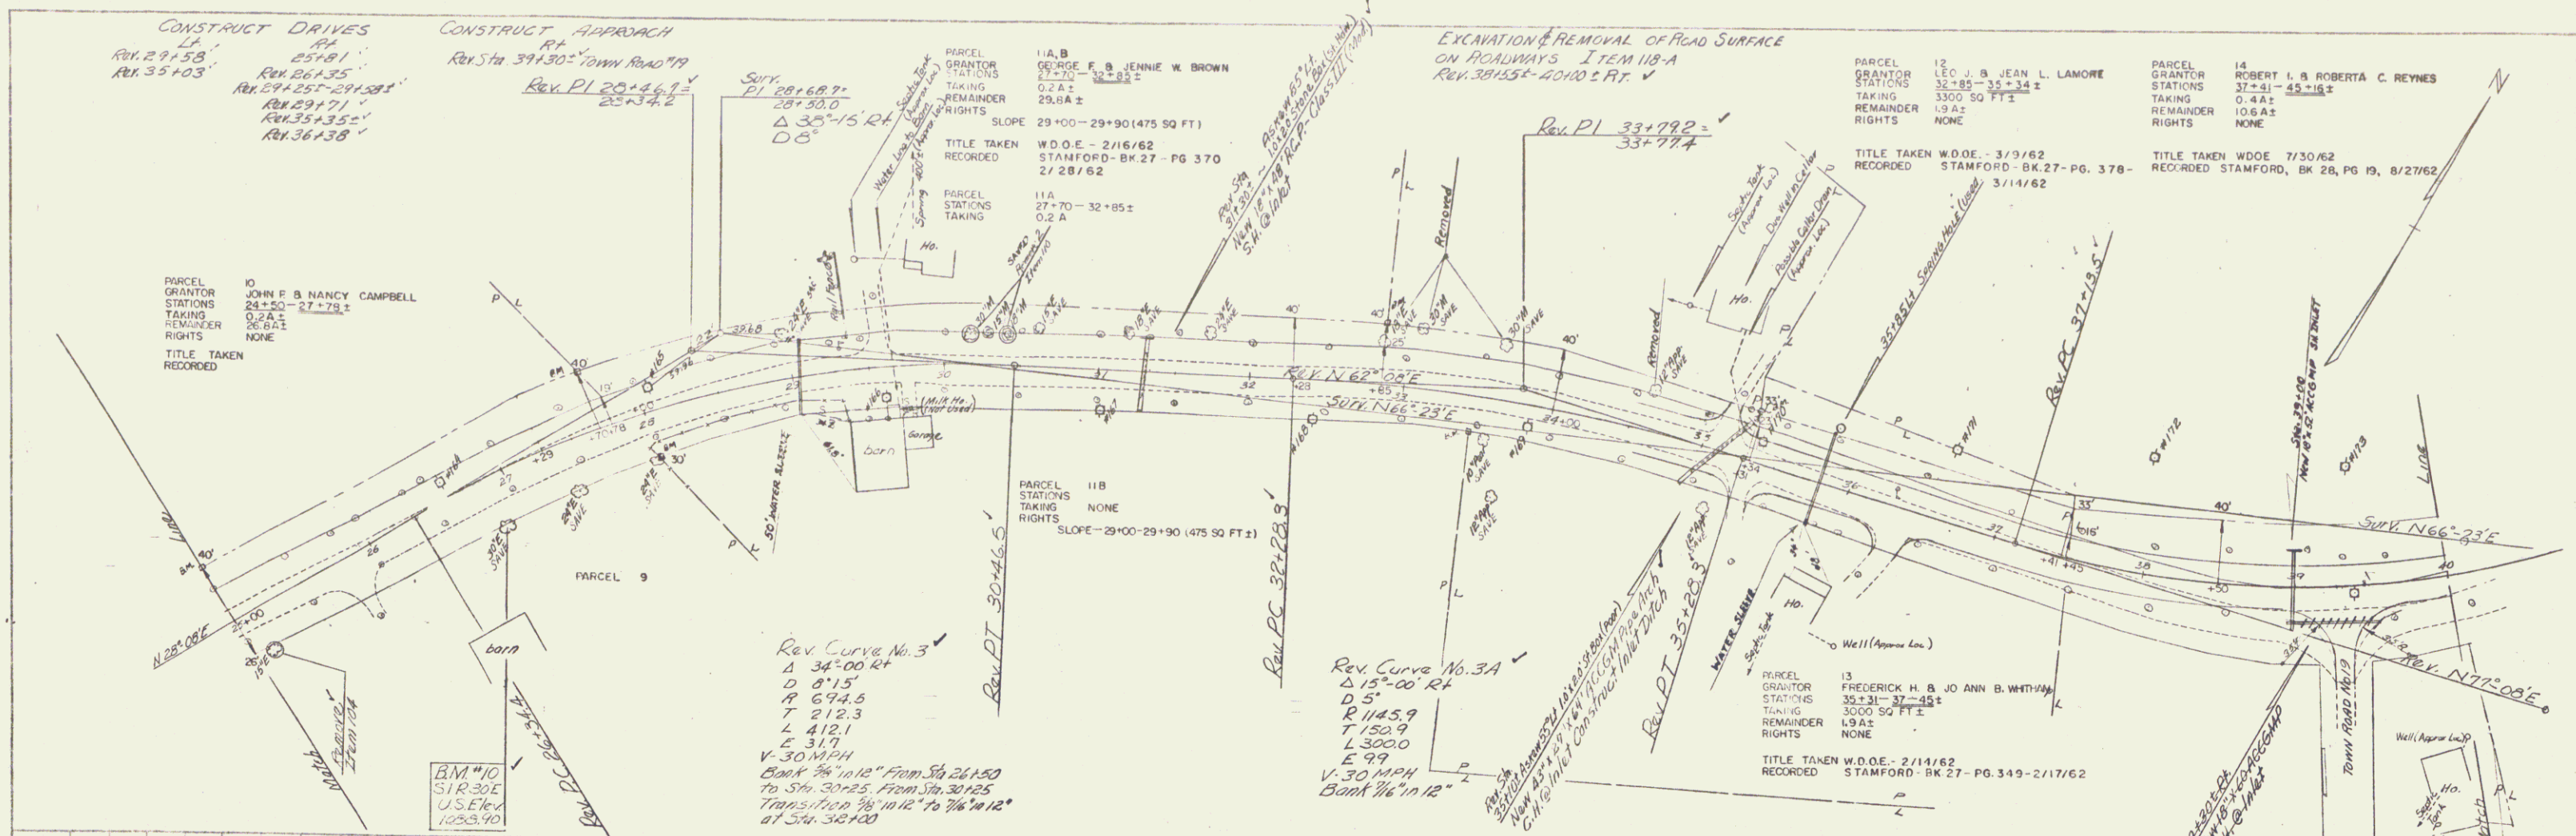

STAMFORD
 No. 5-0122(a)
 Street (18) of 157