
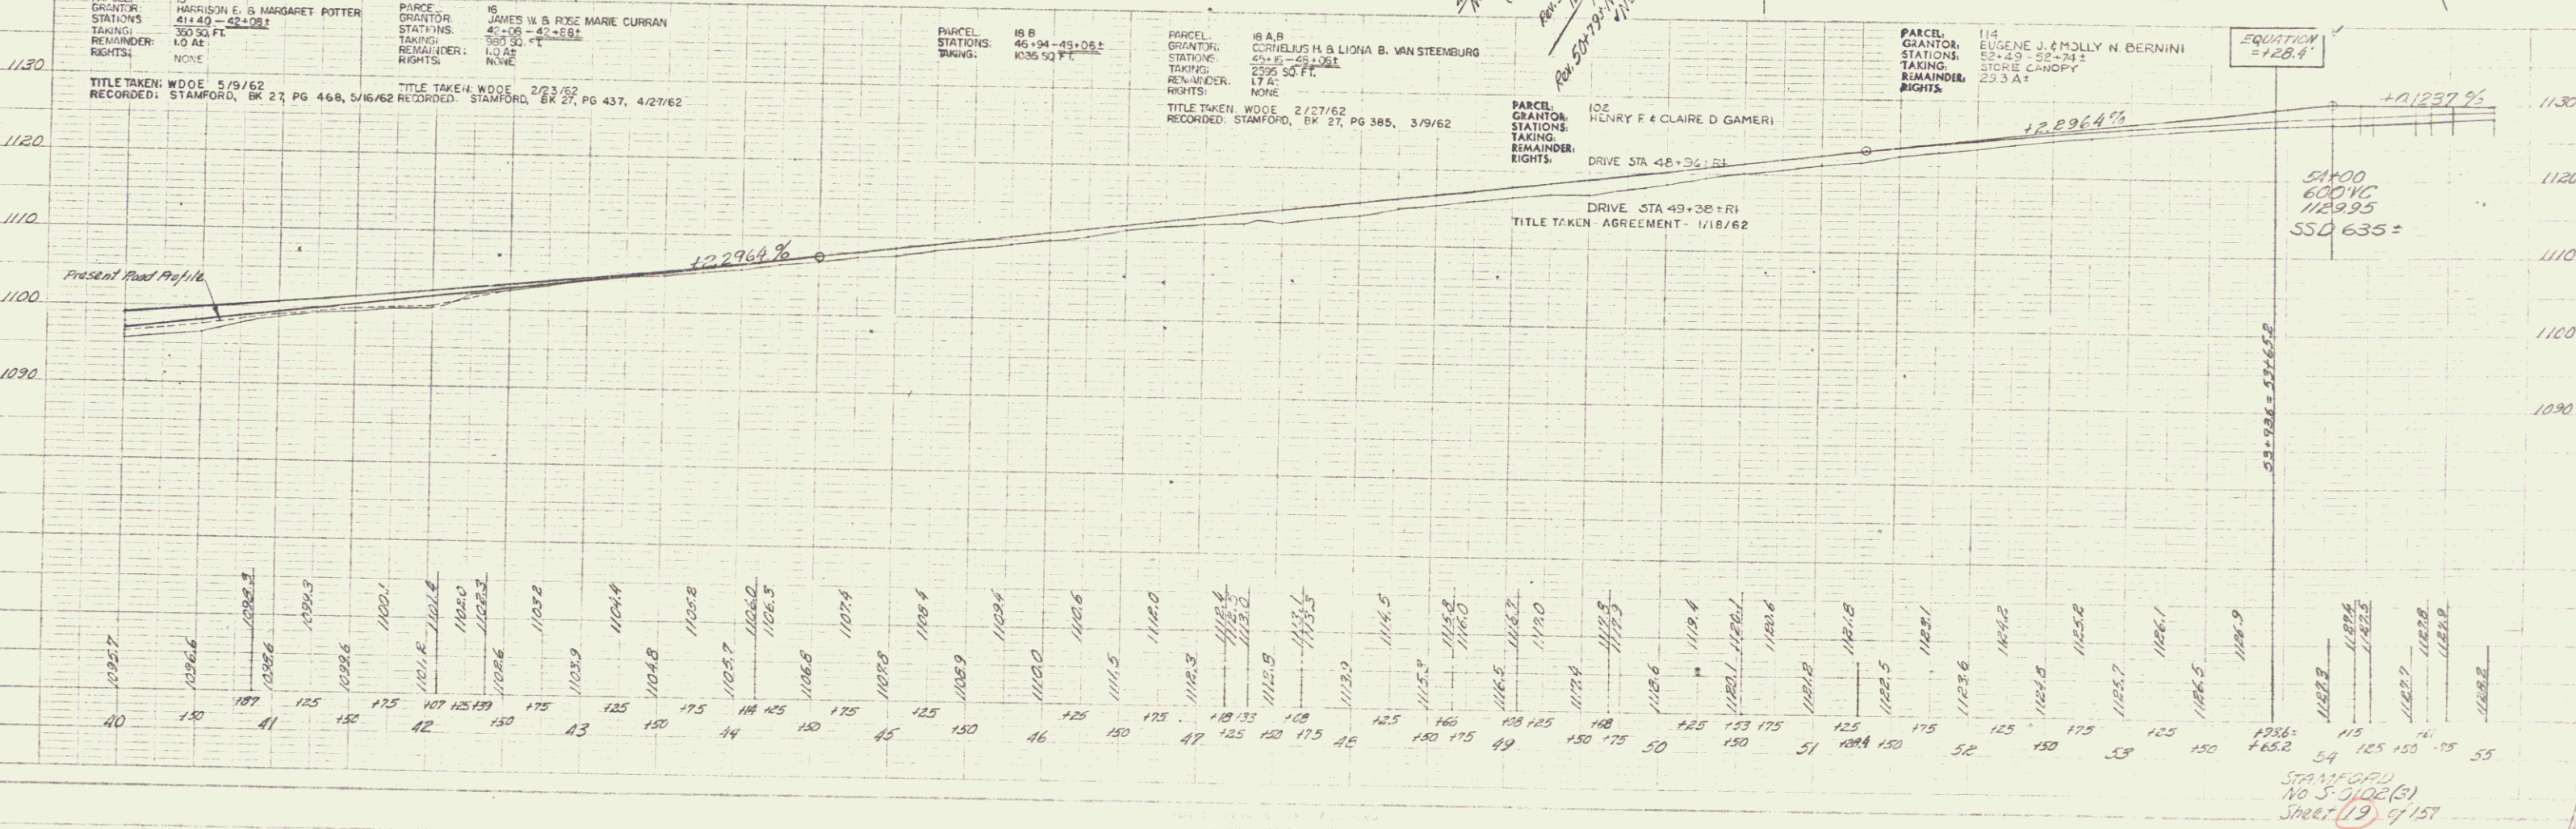


PLAN
 DRAWN BY: S. SANDOZ
 CHECKED BY: M. G. WILKES
 DATE: 1/28/62

PROFILE
 DATE: 1/28/62

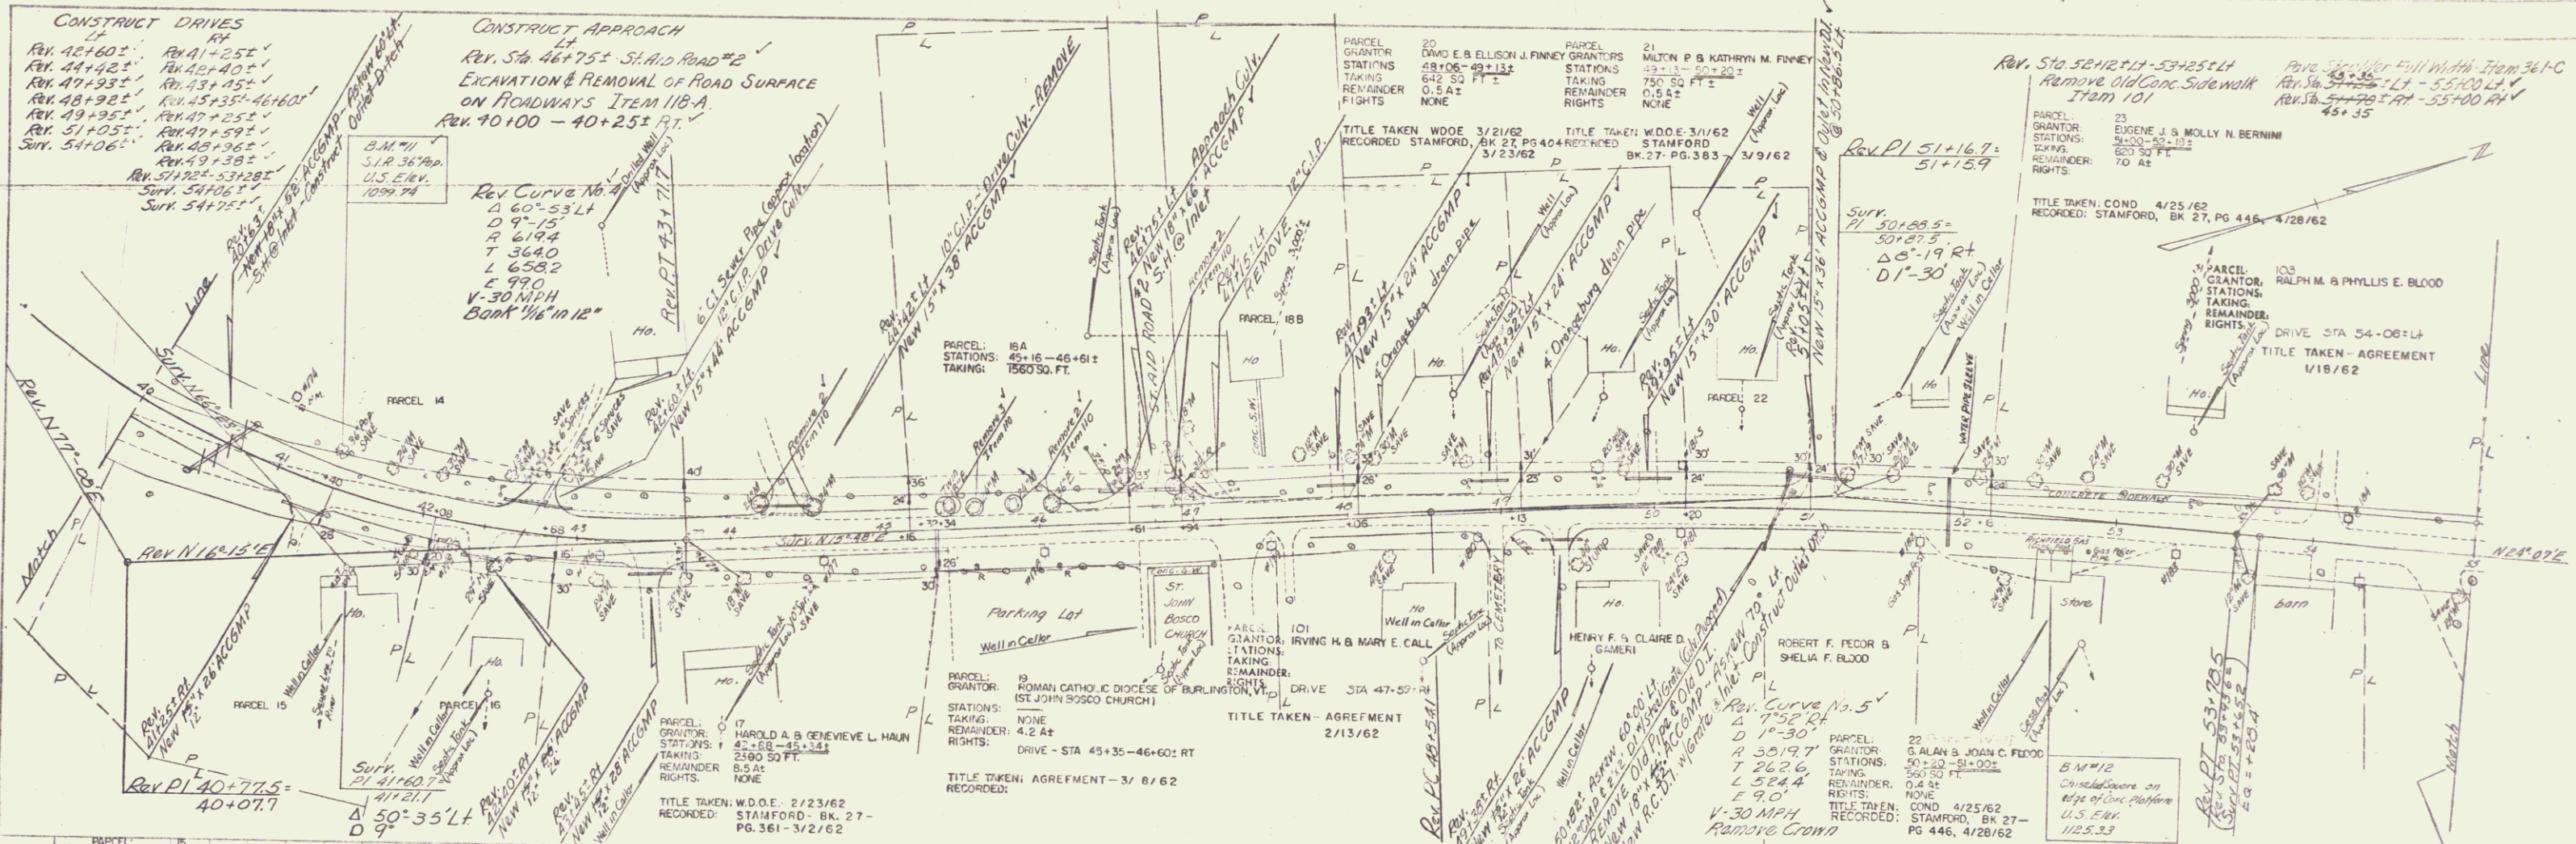

STATIONING
 NO. 5-1102(2)
 STREET 19 9/157