


PLAN
 DATE RECD. 1/19/60
 DRAWN BY H. DOWNES
 CHECKED H. DOWNES

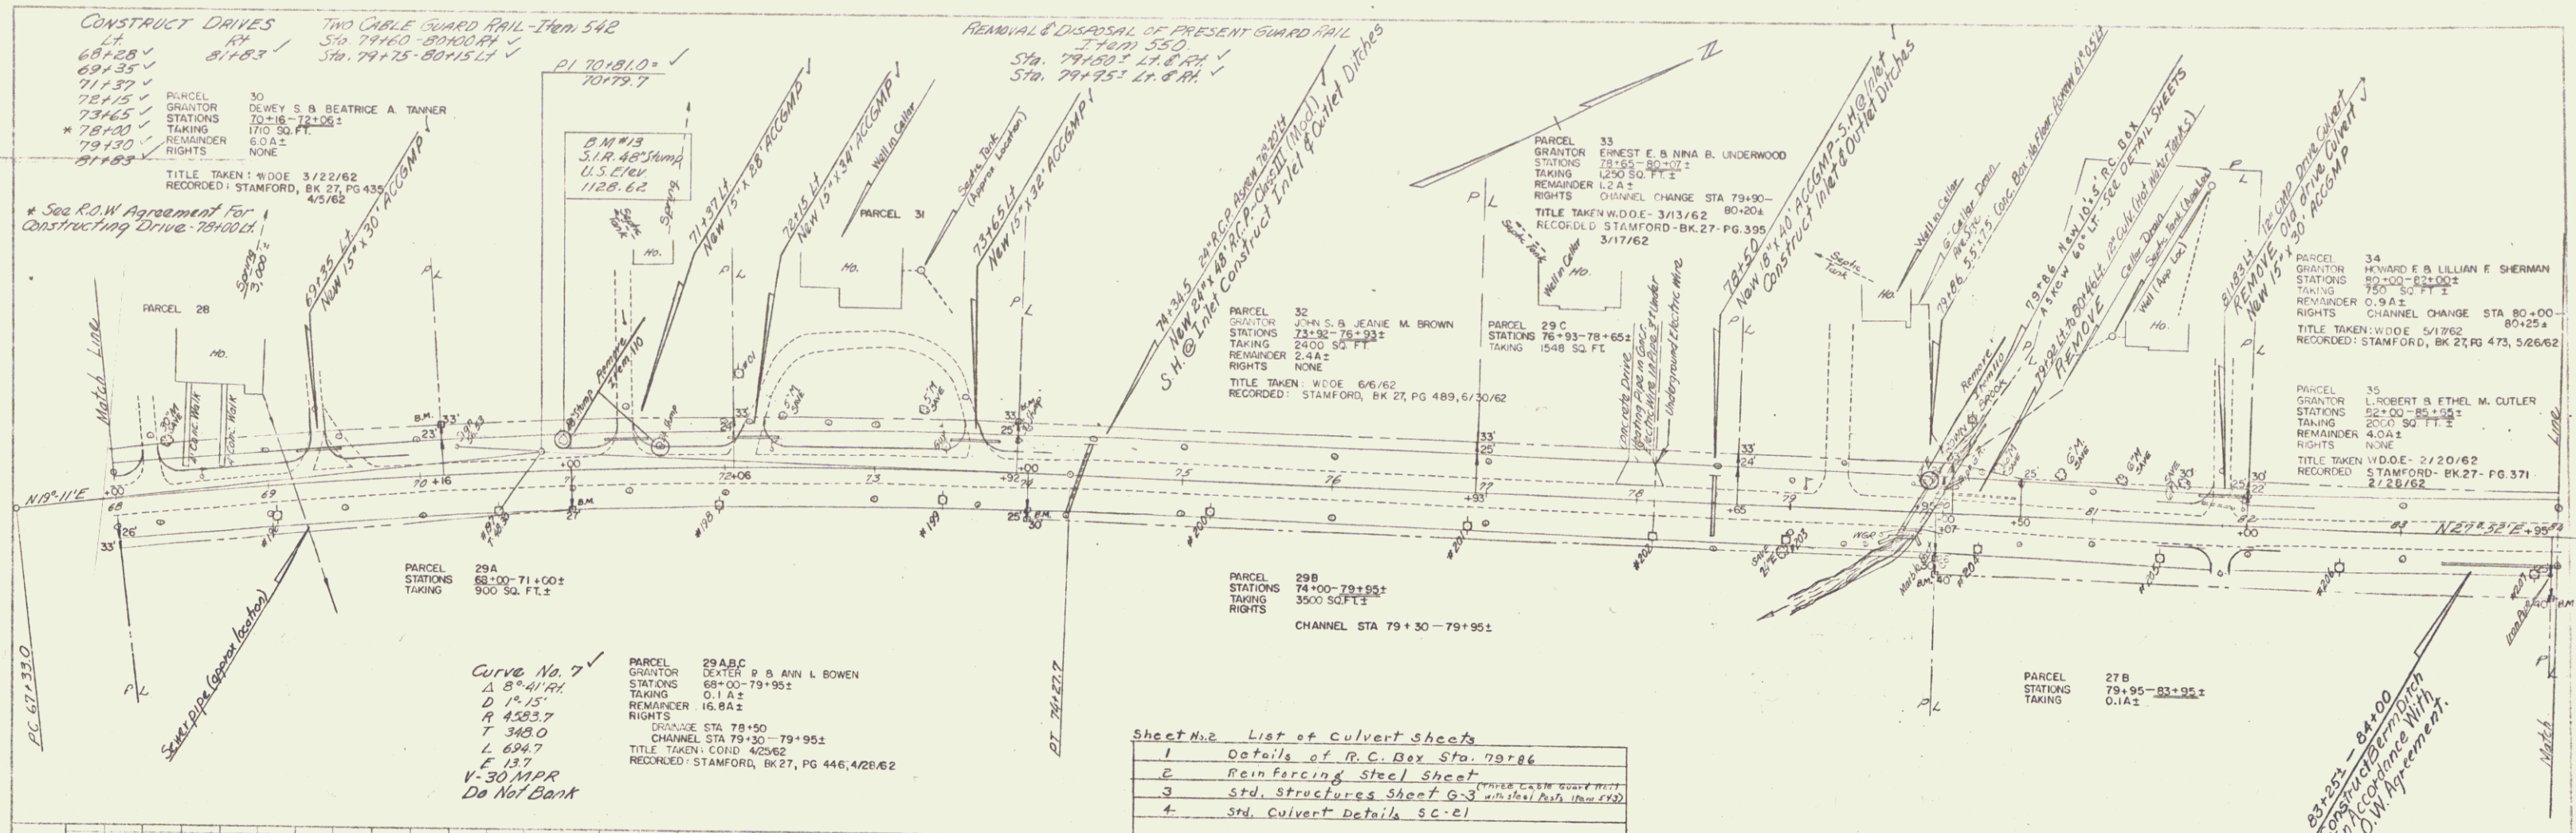

PROFILE
 DATE RECD. 1/19/60
 DRAWN BY H. DOWNES
 CHECKED H. DOWNES

