
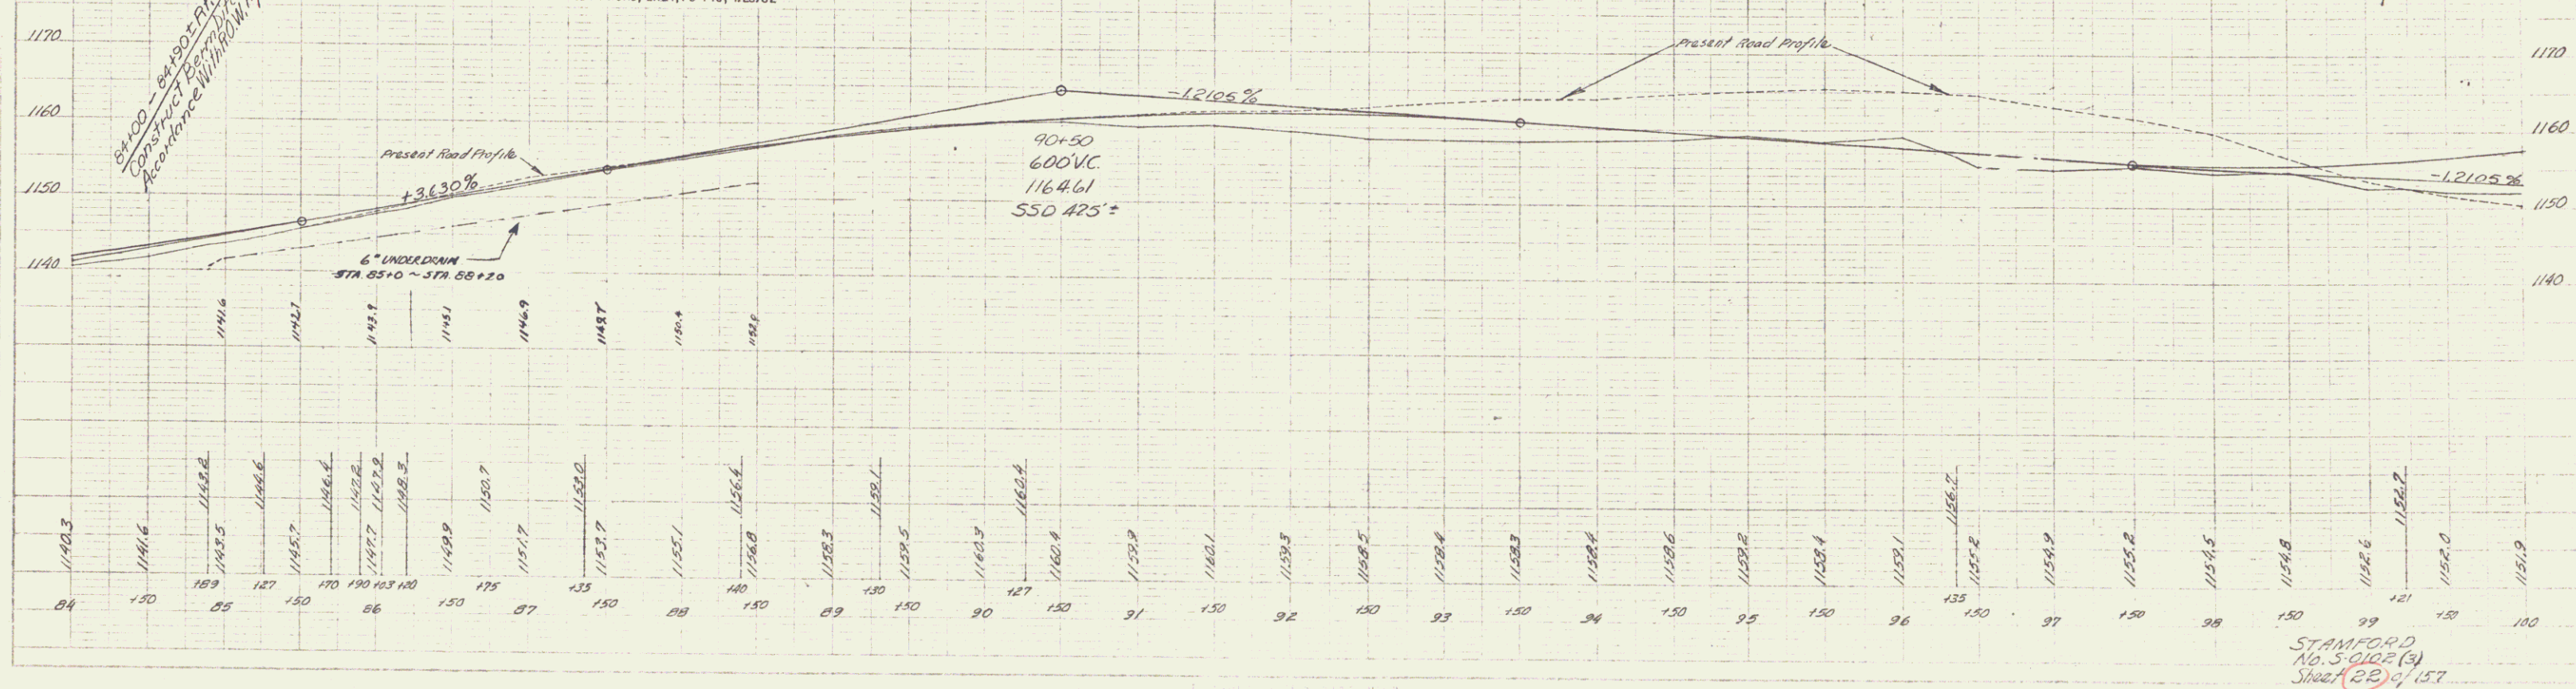


PLAN
 DATE: 1962
 DRAWN BY: E. J. SCHILLING
 CHECKED BY: H. CONNORS

PLAN
 DATE: 1962
 DRAWN BY: E. J. SCHILLING
 CHECKED BY: H. CONNORS

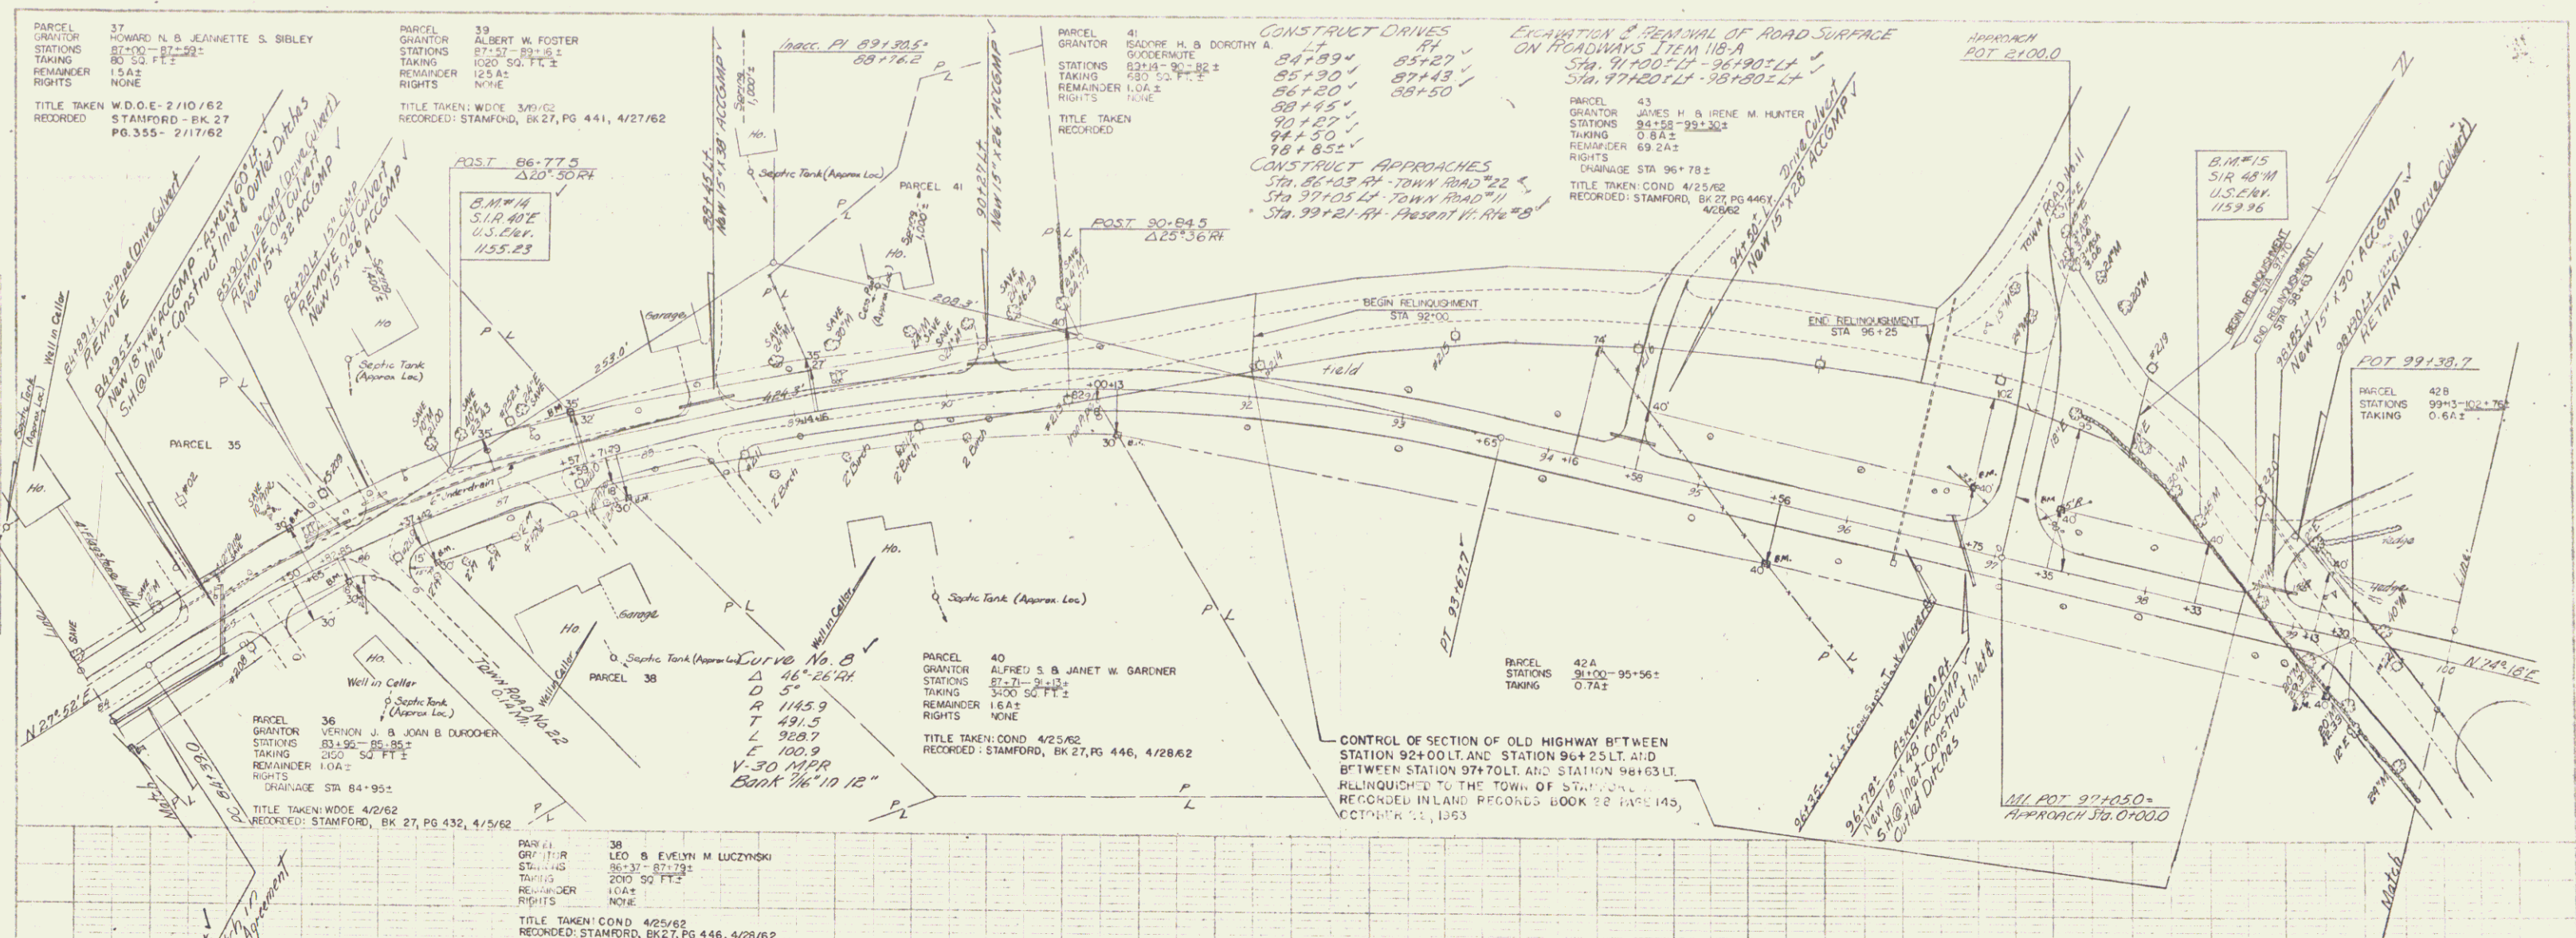

STAMFORD
 No. 5-0122 (3)
 Sheet (22) of 157