
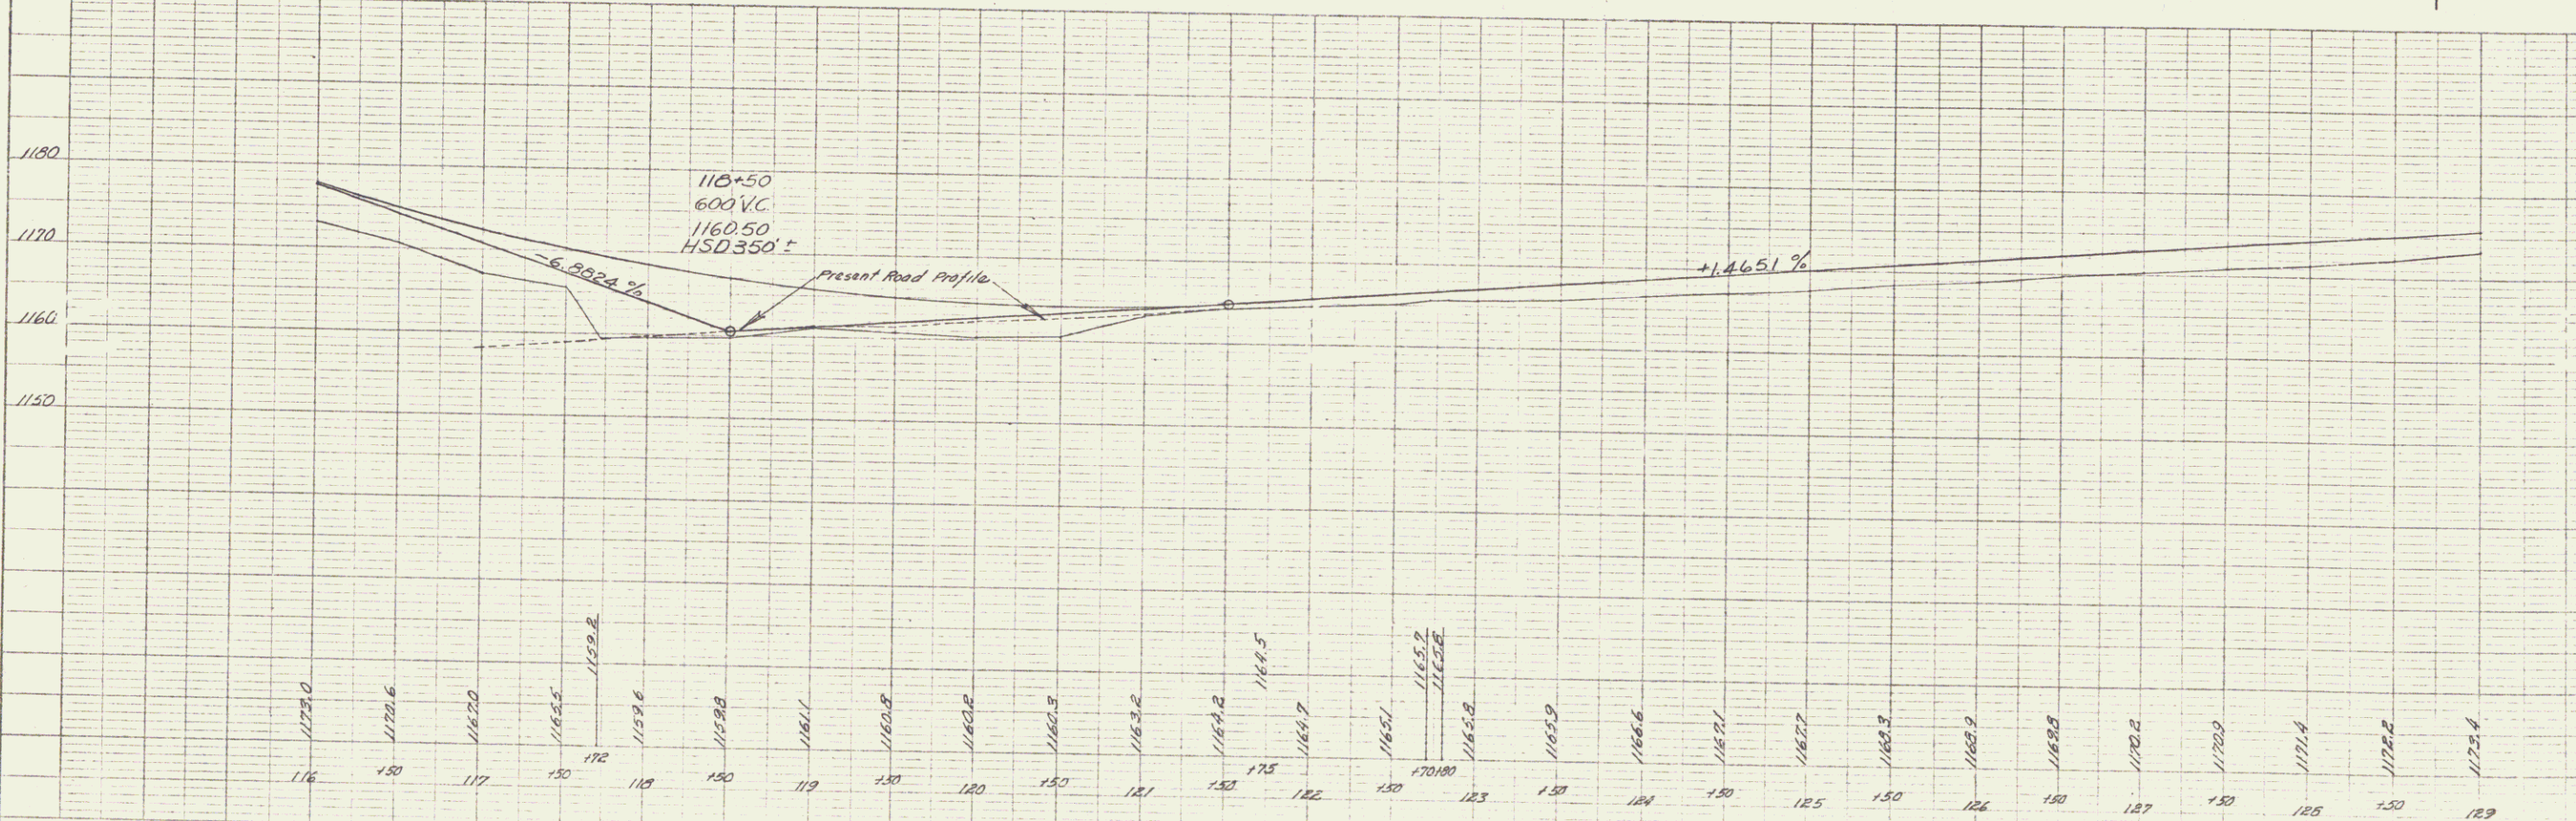


PLAN
 DRAWN BY: E.D. SANDERSON
 CHECKED BY: M. CHAMBERS
 DATE: 1/23/62

PROFILE
 DRAWN BY: M. Chambers
 CHECKED BY: E.D. SANDERSON
 DATE: 1/23/62

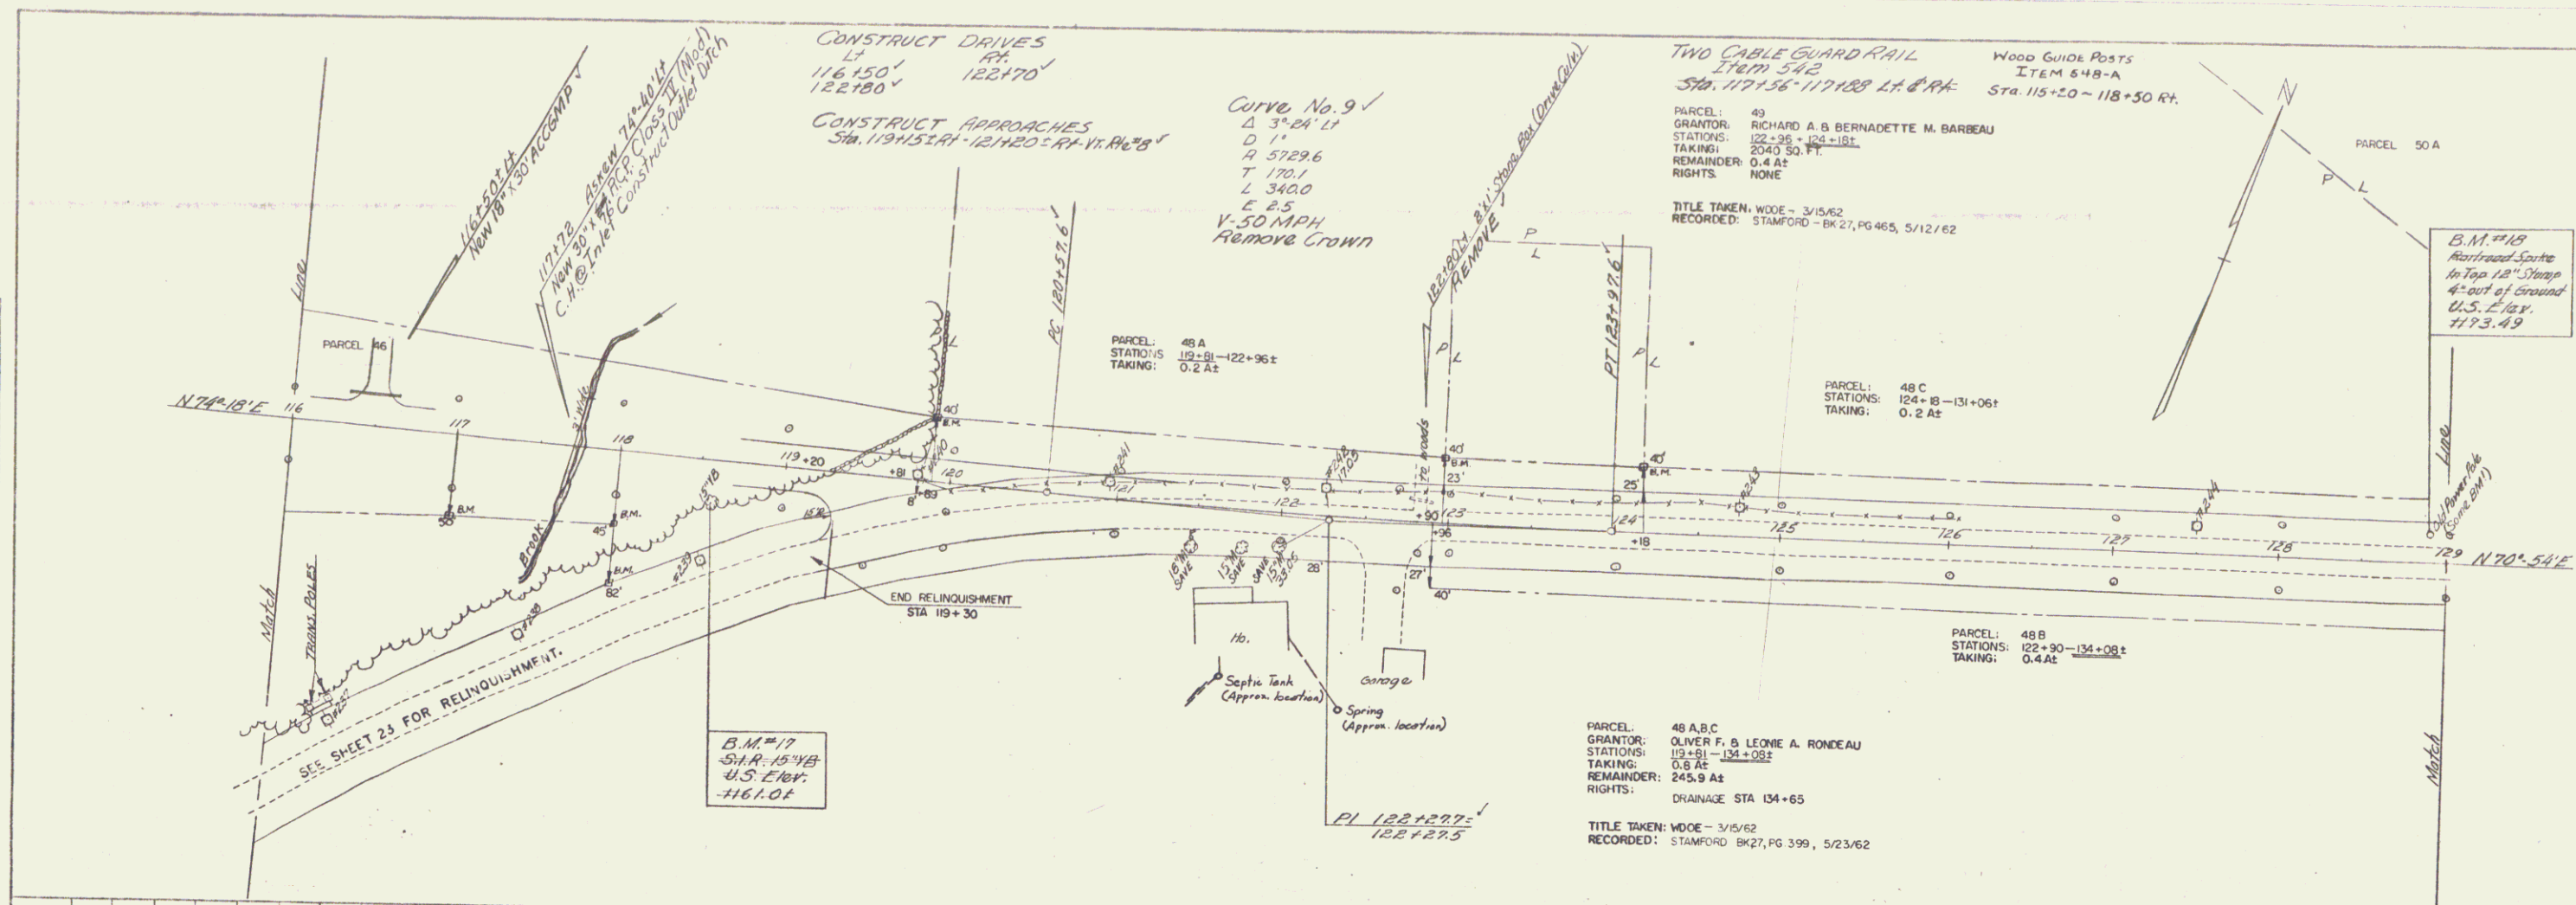

STAMFORD,
 No. 5 0102(3)
 Sheet 25 of 157