


EXCAVATION & REMOVAL OF ROAD SURFACE  
232+00.0 - 233+00.0

PLAN  
DATE: 1/23/61  
BY: C.E.H.  
CHECKED: C.E.H.  
SCALE: 1" = 40'

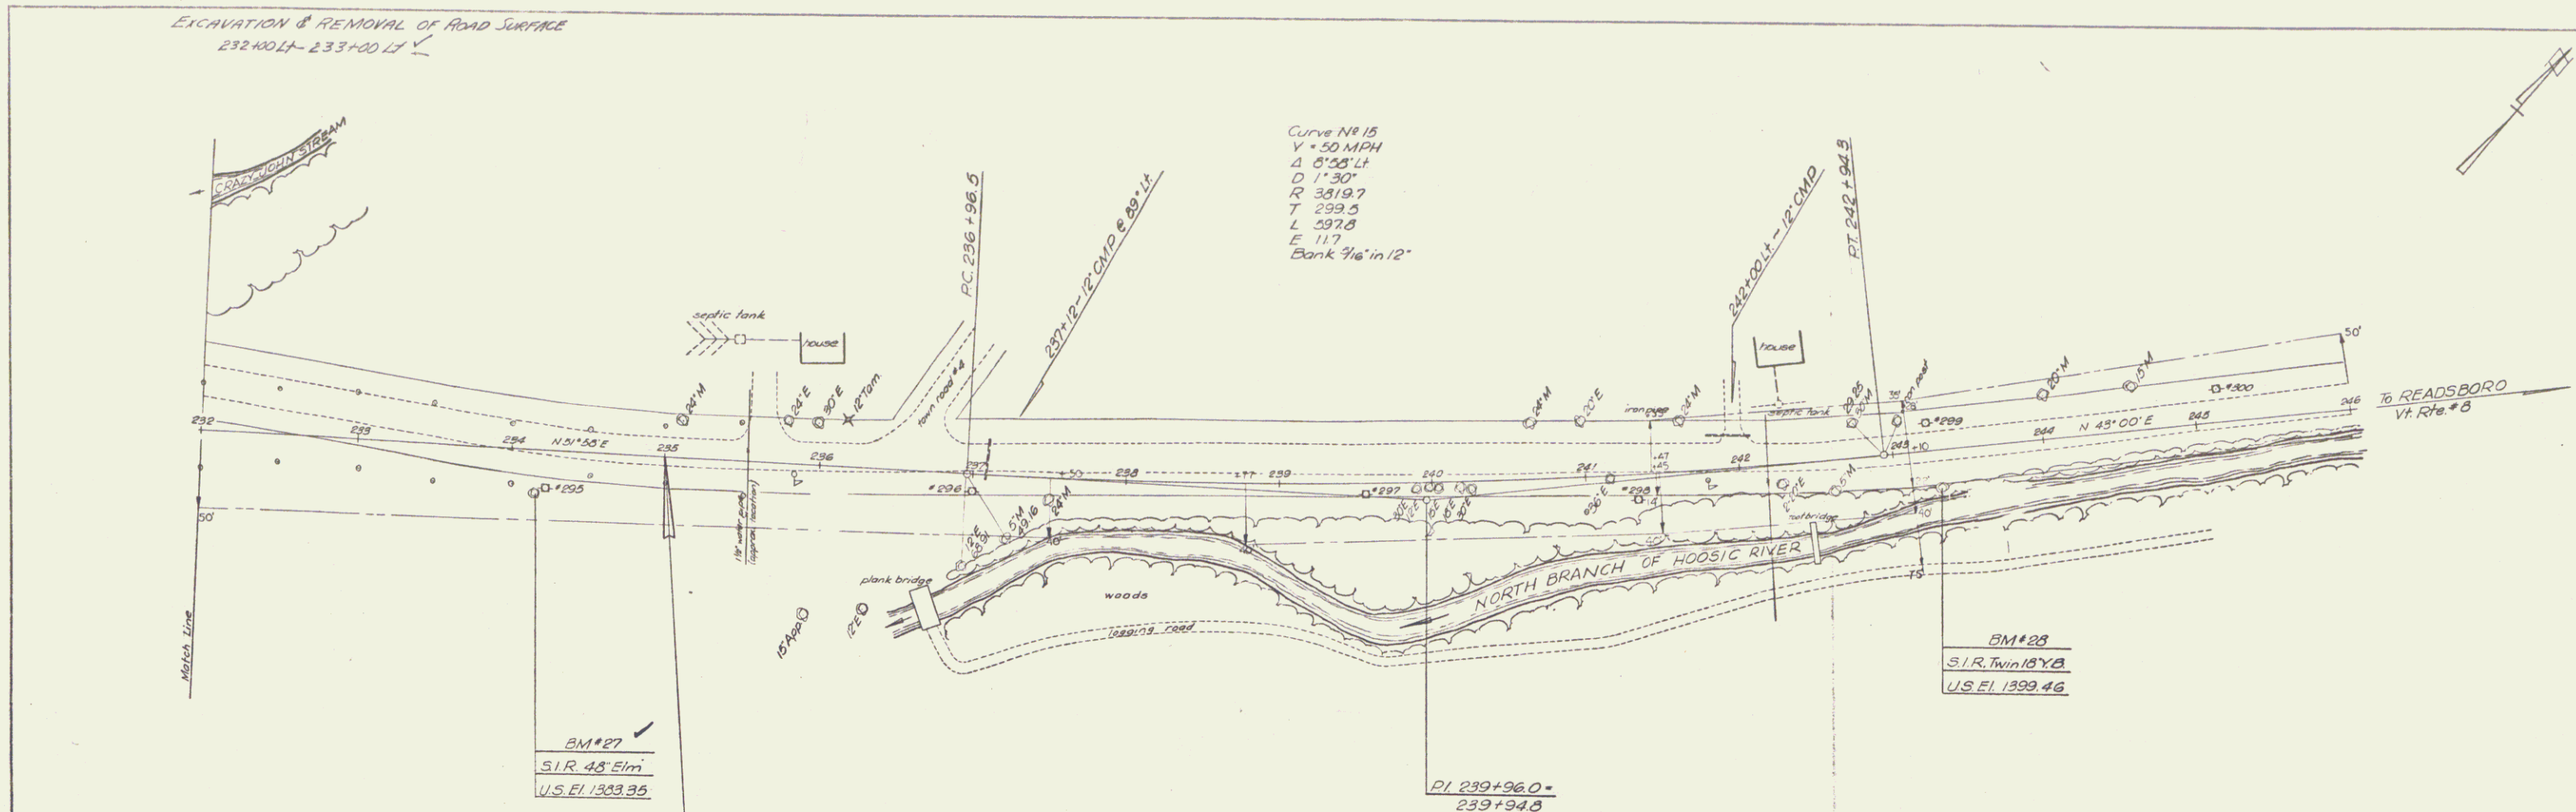

PROFILE  
DATE: 1/23/61  
BY: C.E.H.  
CHECKED: C.E.H.  
SCALE: 1" = 40'

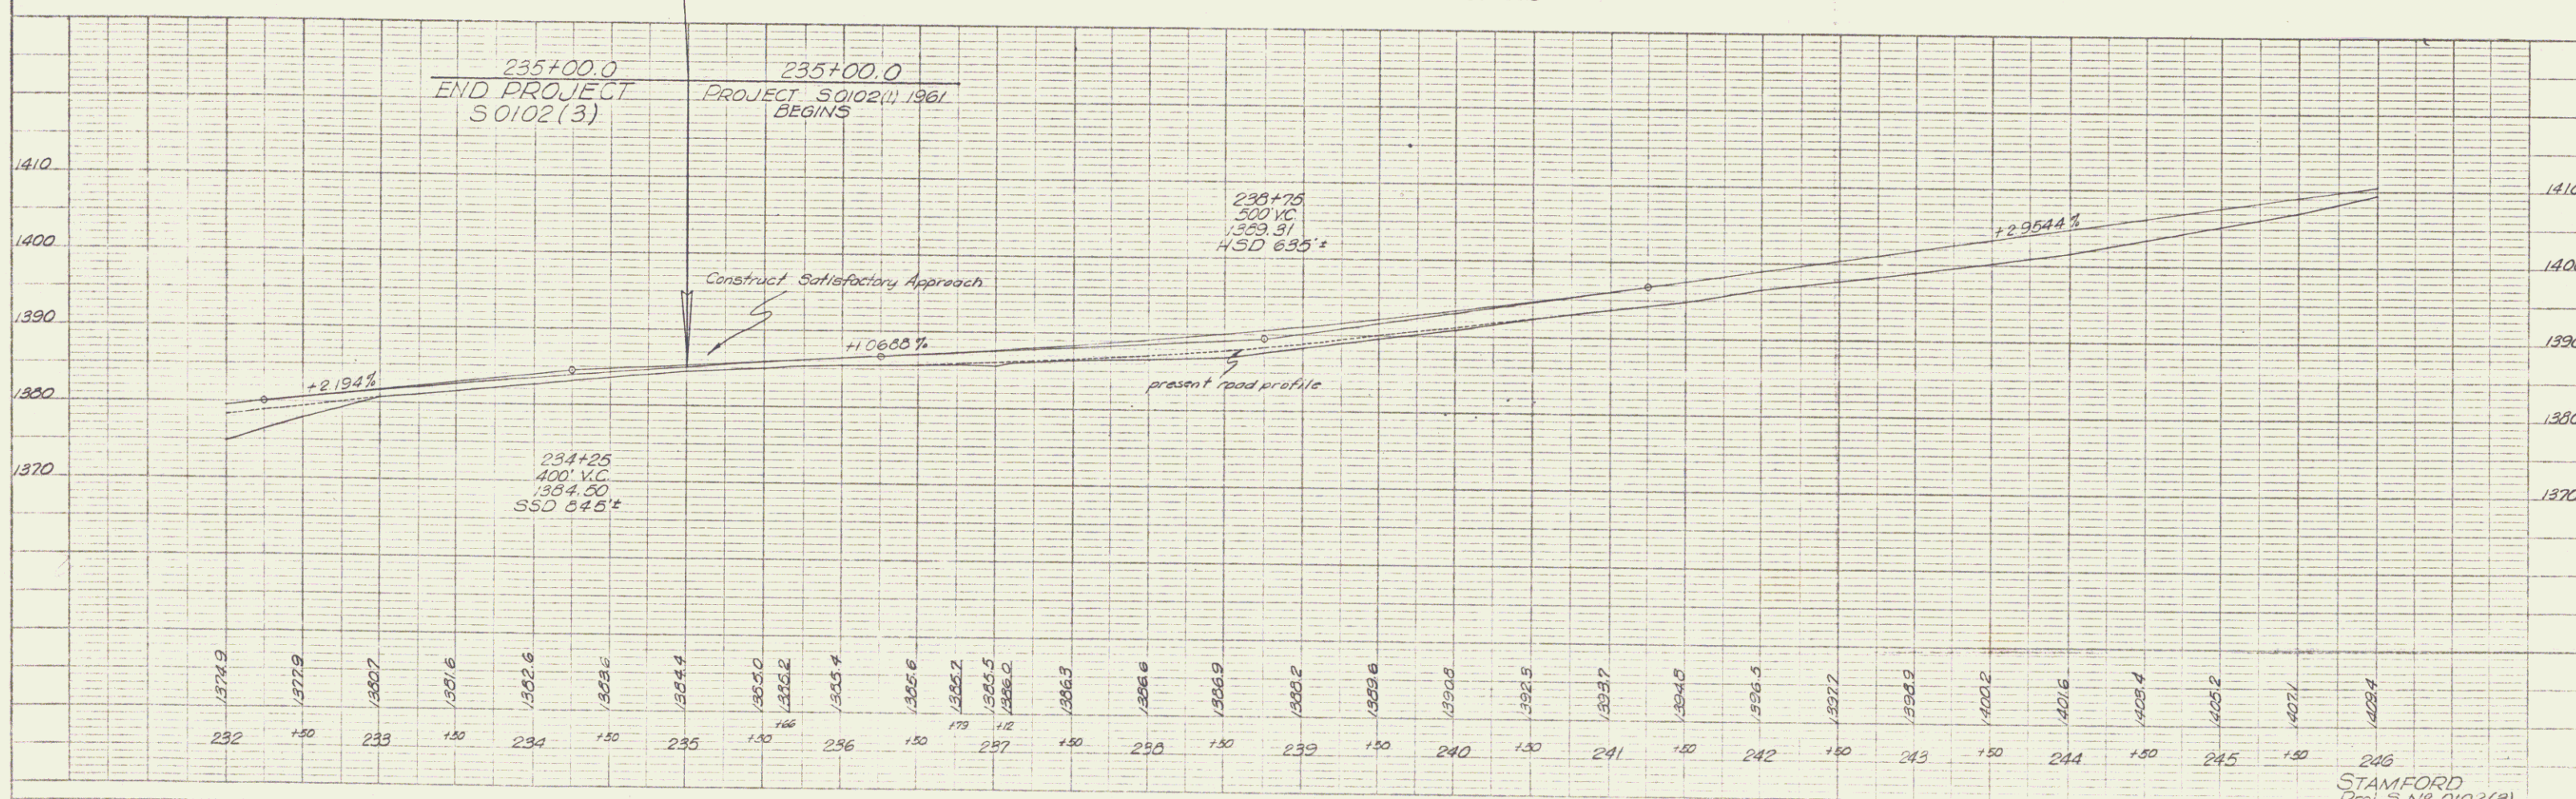


PLATE 1 - PLAN, PROFILE & P.A.E. SURROUND  
RECORDS SECTION

STAMFORD  
Proj. 5 No. 0102(3)  
Sheet 35 of 157