
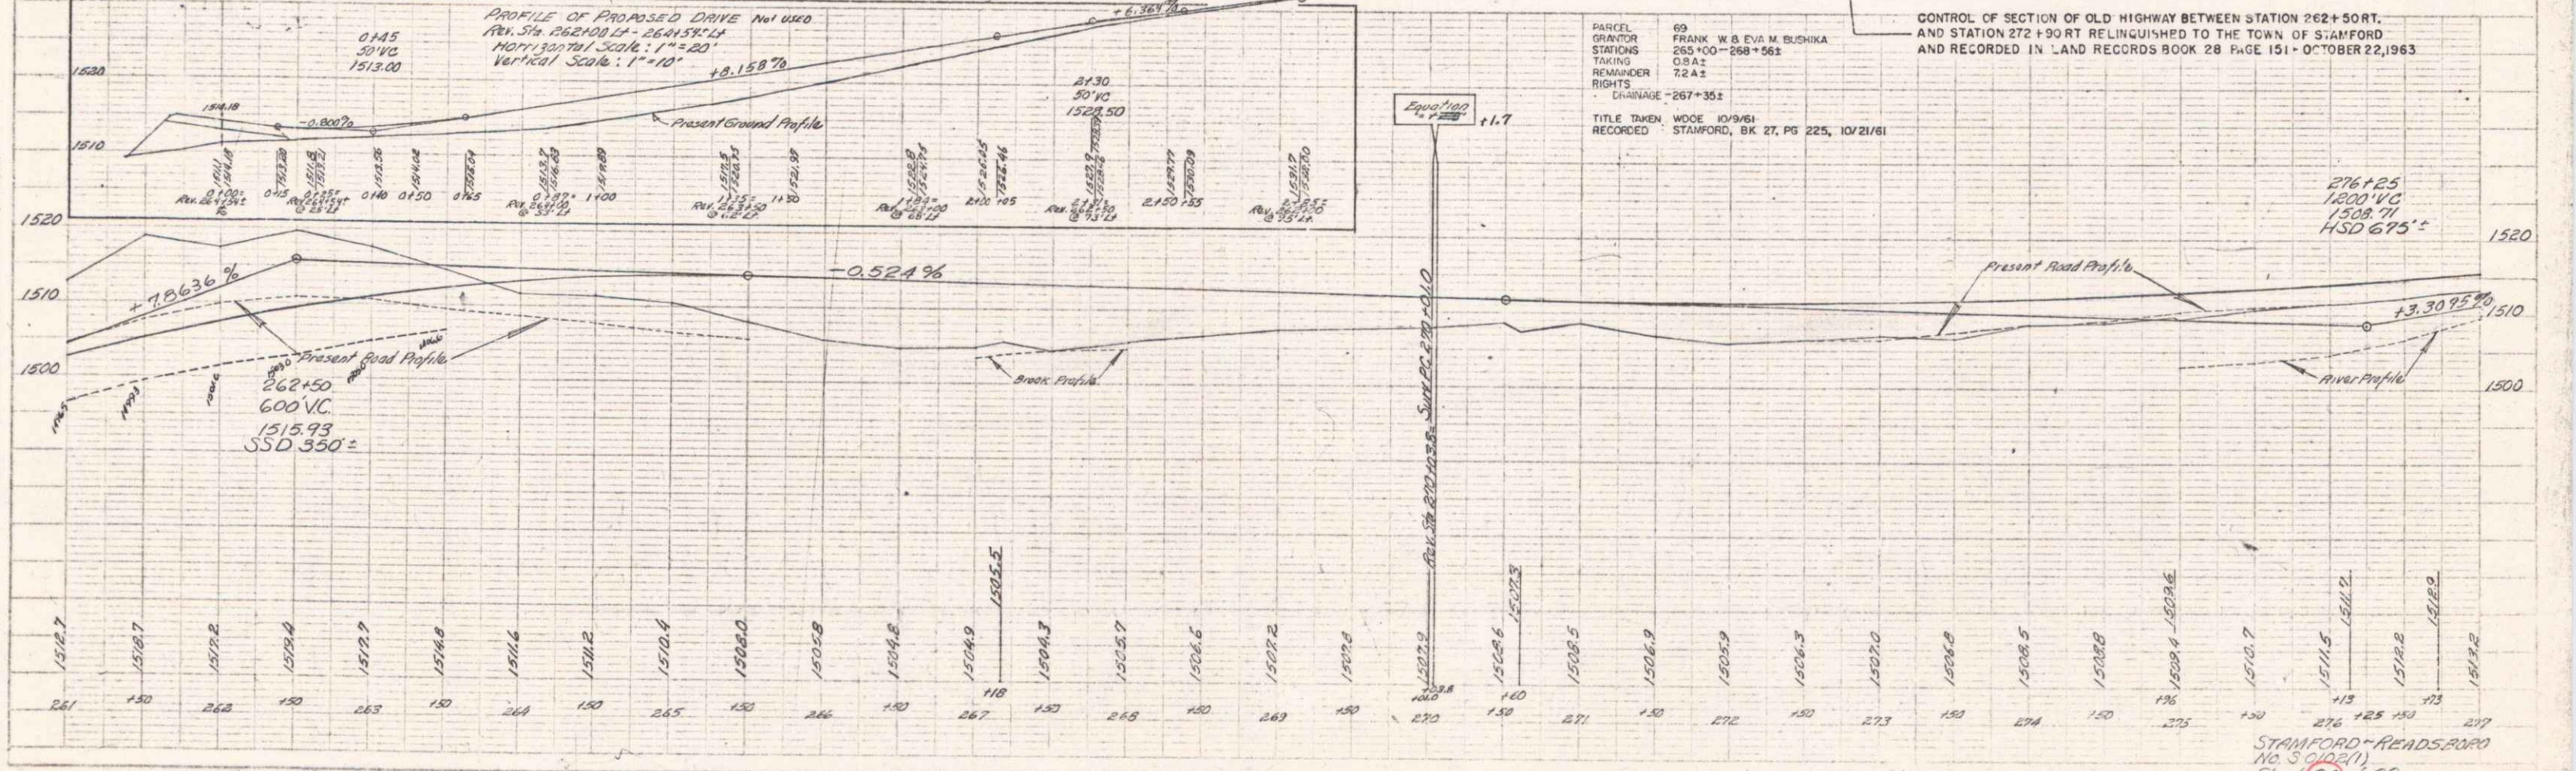


PLAN  
 1959  
 10/16/60  
 H. CONLIES

PROFILE  
 1959  
 10/16/60  
 H. CONLIES

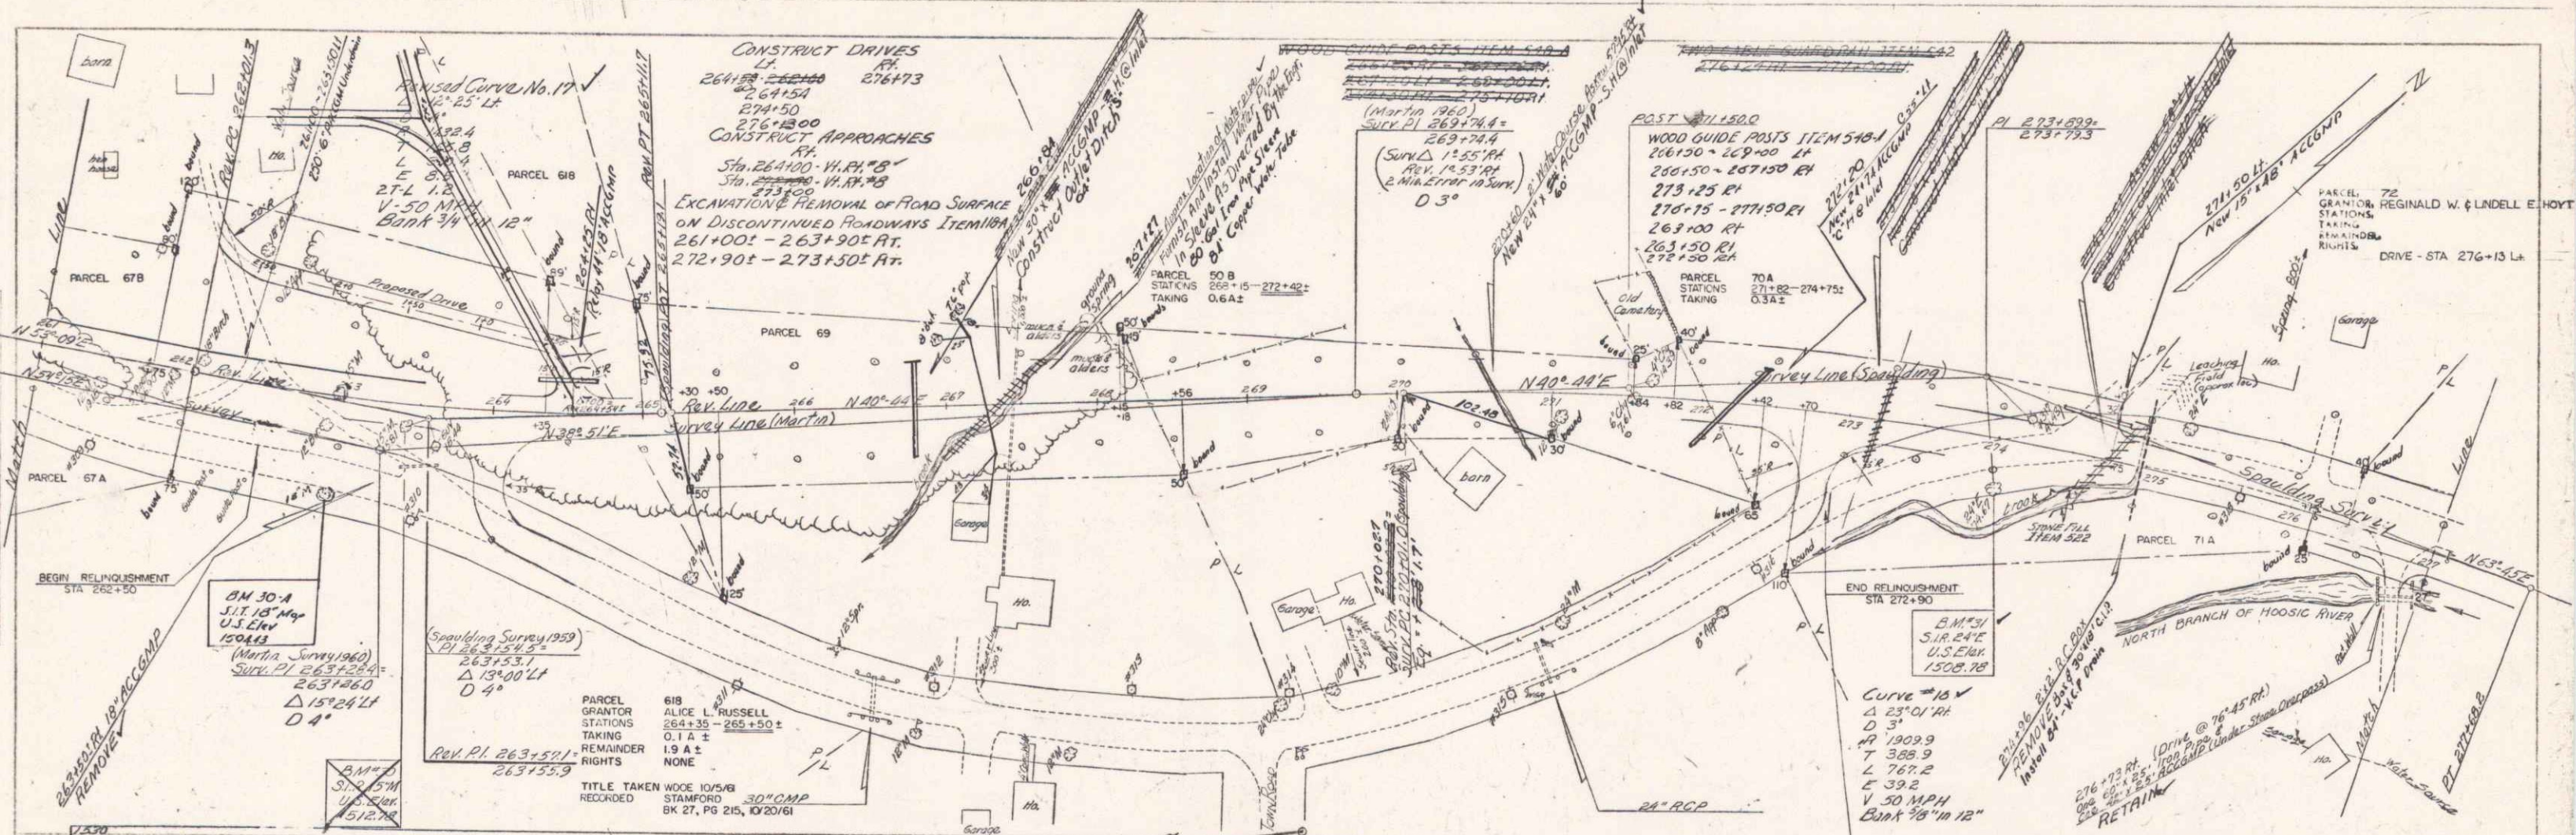

4