


ED. J. WILKINS  
A. GARDNER  
1960  
ALGONQUILS  
1960  
TRAGED

PROFILE  
1960  
ALGONQUILS  
1960

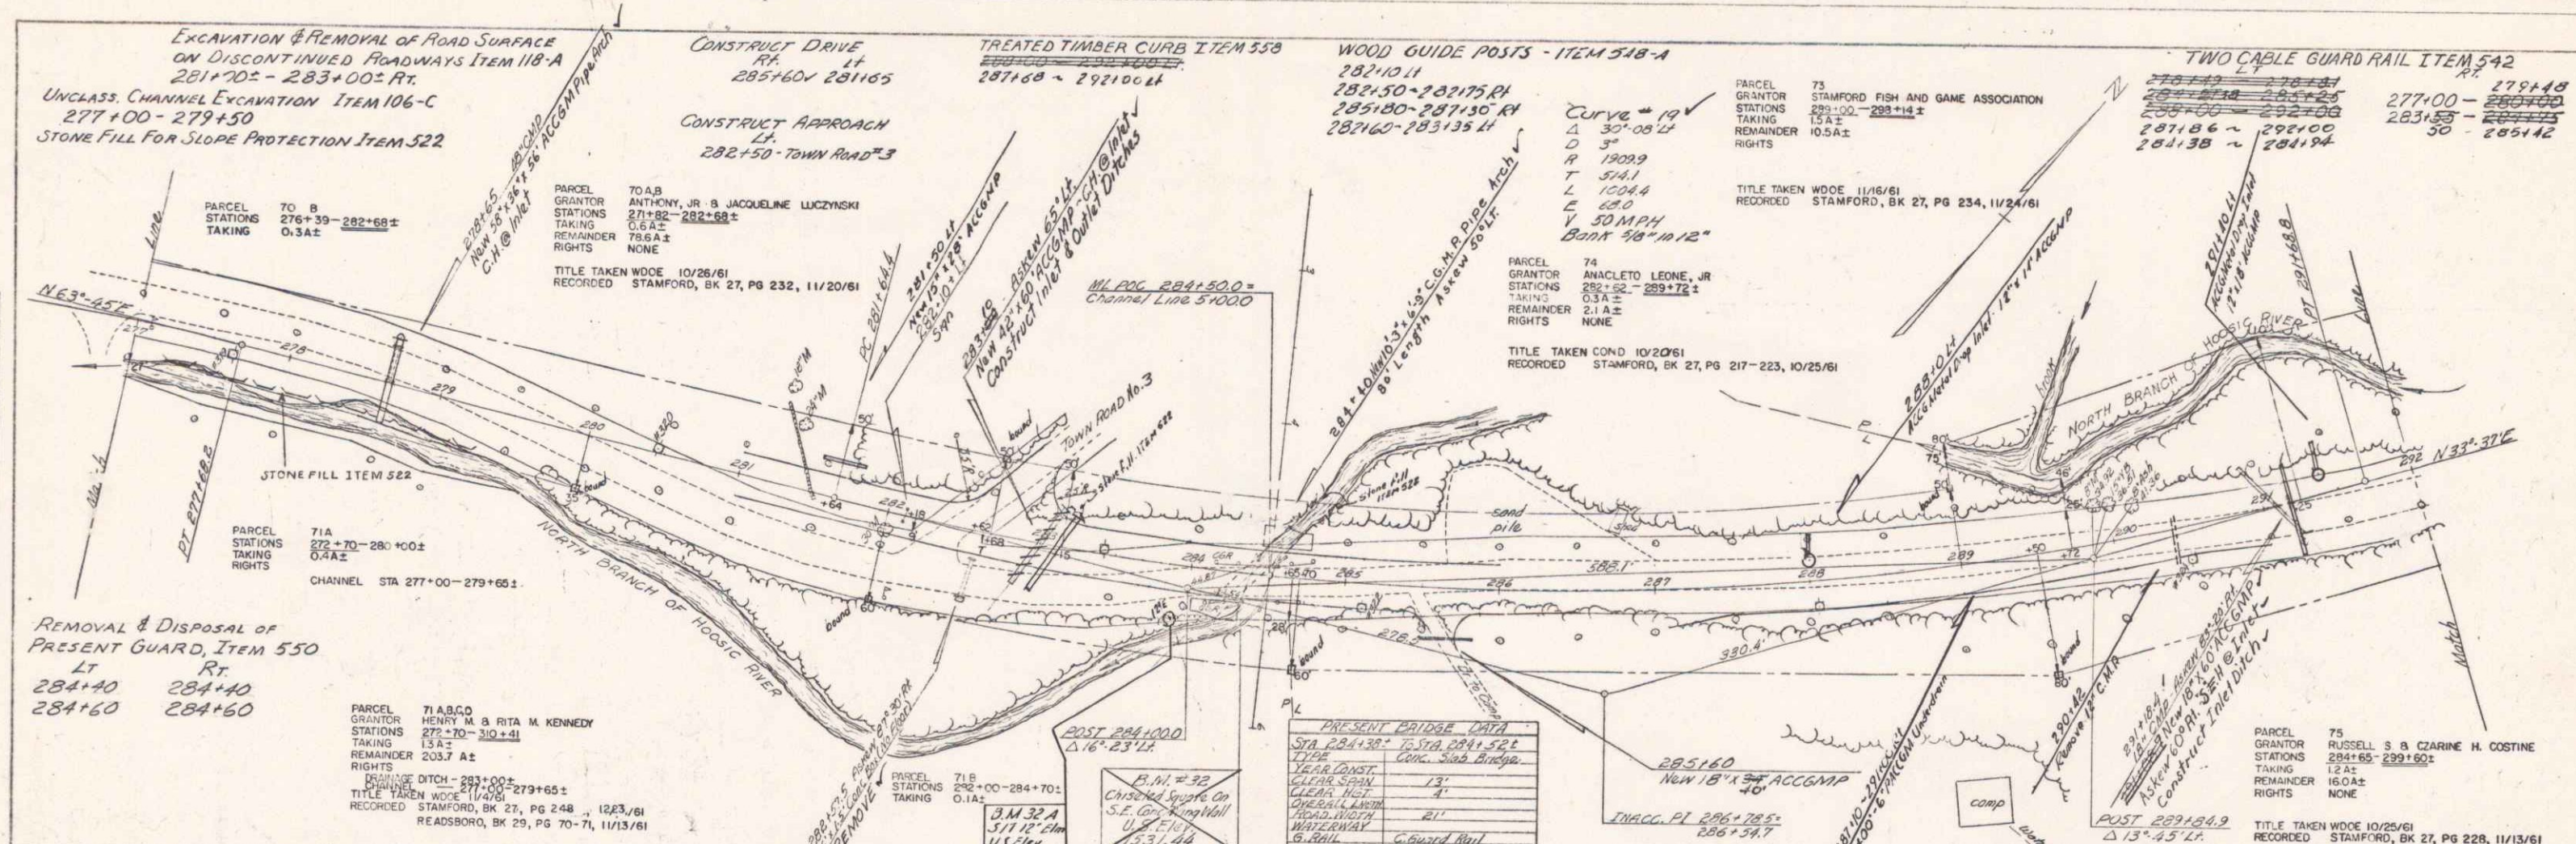

SHEET NO. LIST OF PIPE ARCH SHEETS

1. STANDARD STRUCTURES SB-PA\*1
2. " " " " SB-PA\*2
3. CHANNEL SECTIONS

