

TREATED TIMBER CURBS ITEM 358 TWO CABLE GUARD RAIL ITEM 542  
 333192 ~ 342160 LI  
 334105 ~ 342160 LI  
 WOOD GUIDE POSTS - ITEM 548-A  
 335130 RI (2)



CONSTRUCT TURNOUT  
 STA. 335100 RI - 336150 RI  
 STA. 342100 LI - 346100 RI

CONSTRUCT RAMP TO PARKING AREA  
 STA. 343100 RI - 346100 RI

CURVE #22V  
 Δ 62°15'11"  
 D 57°41'  
 P 1094.3  
 T 661.1  
 L 1829.6  
 E 184.1  
 V 40 MPH  
 DATA 10 10 (hand fed)  
 1/2

PARCEL 78 B  
 342+17 - 351+00 E  
 O.S. A-Z

PLAN  
 1989  
 S. QUINLAN  
 H. COMBES

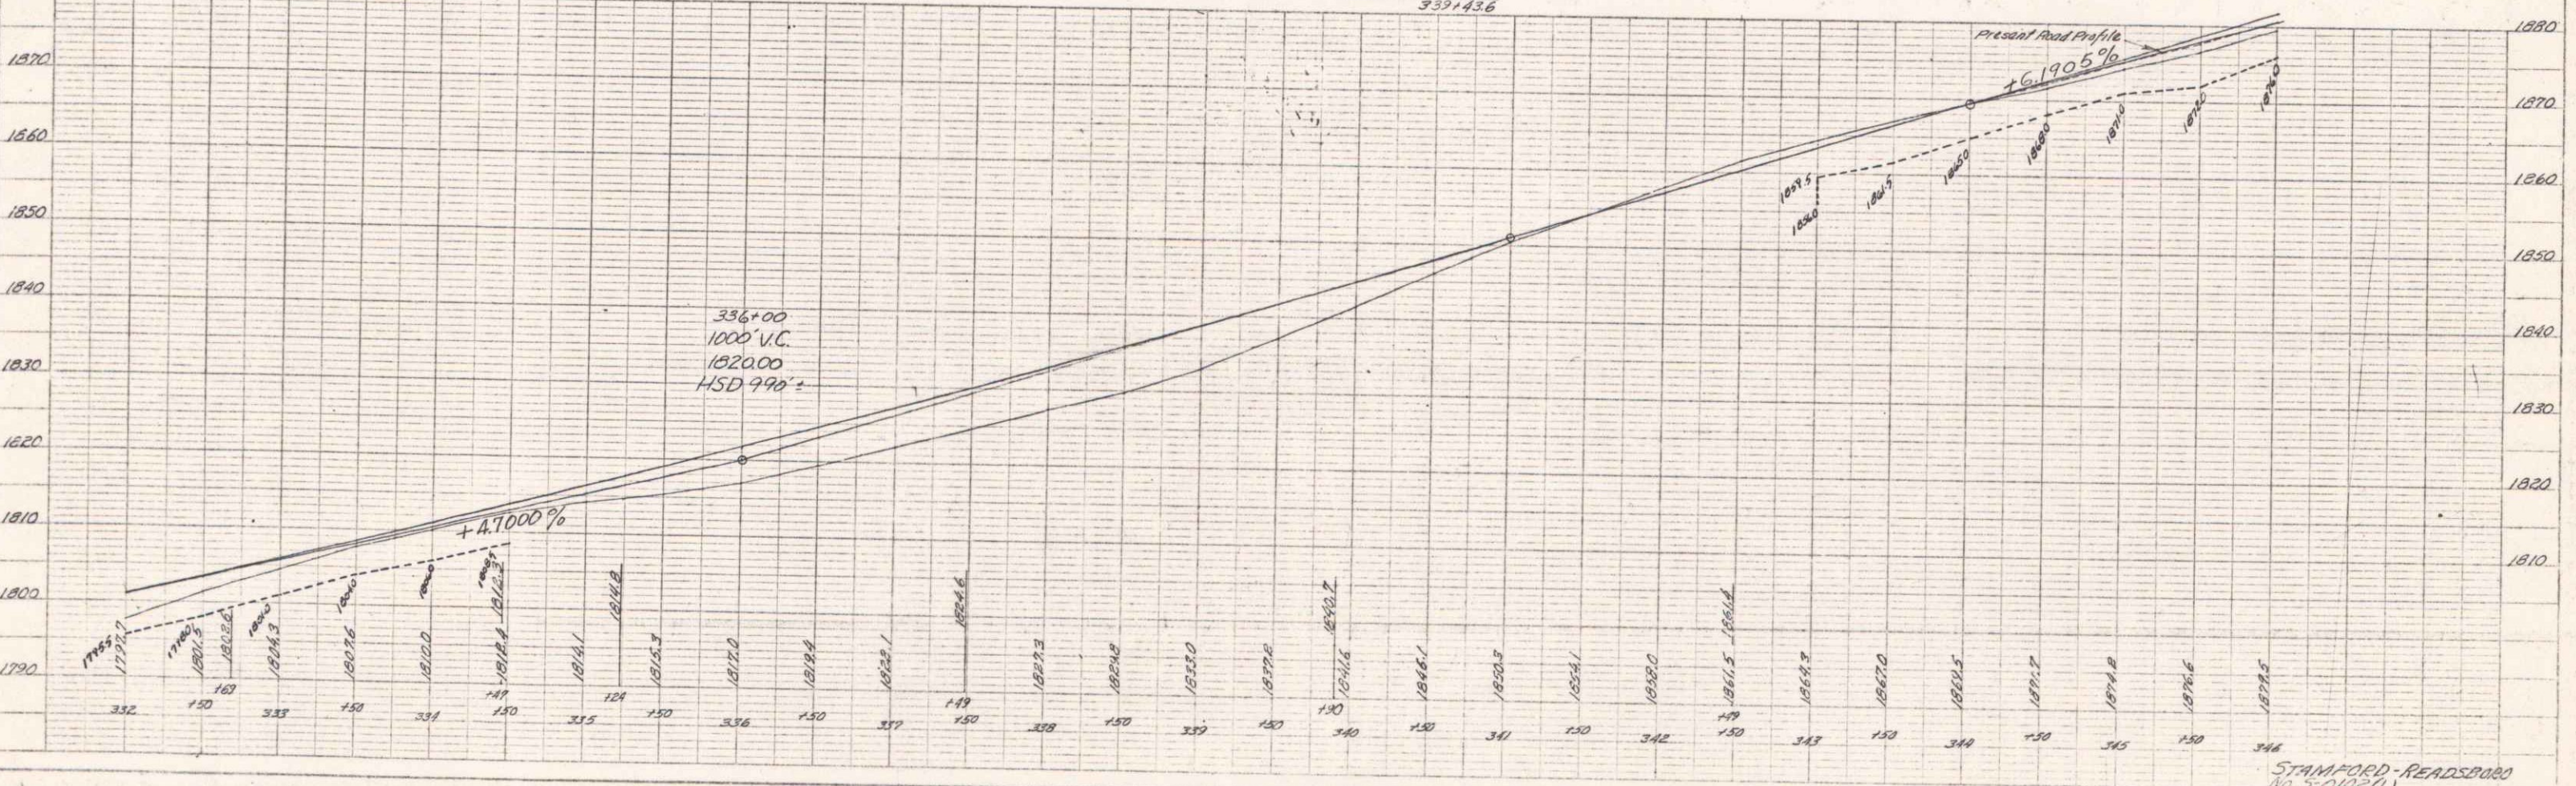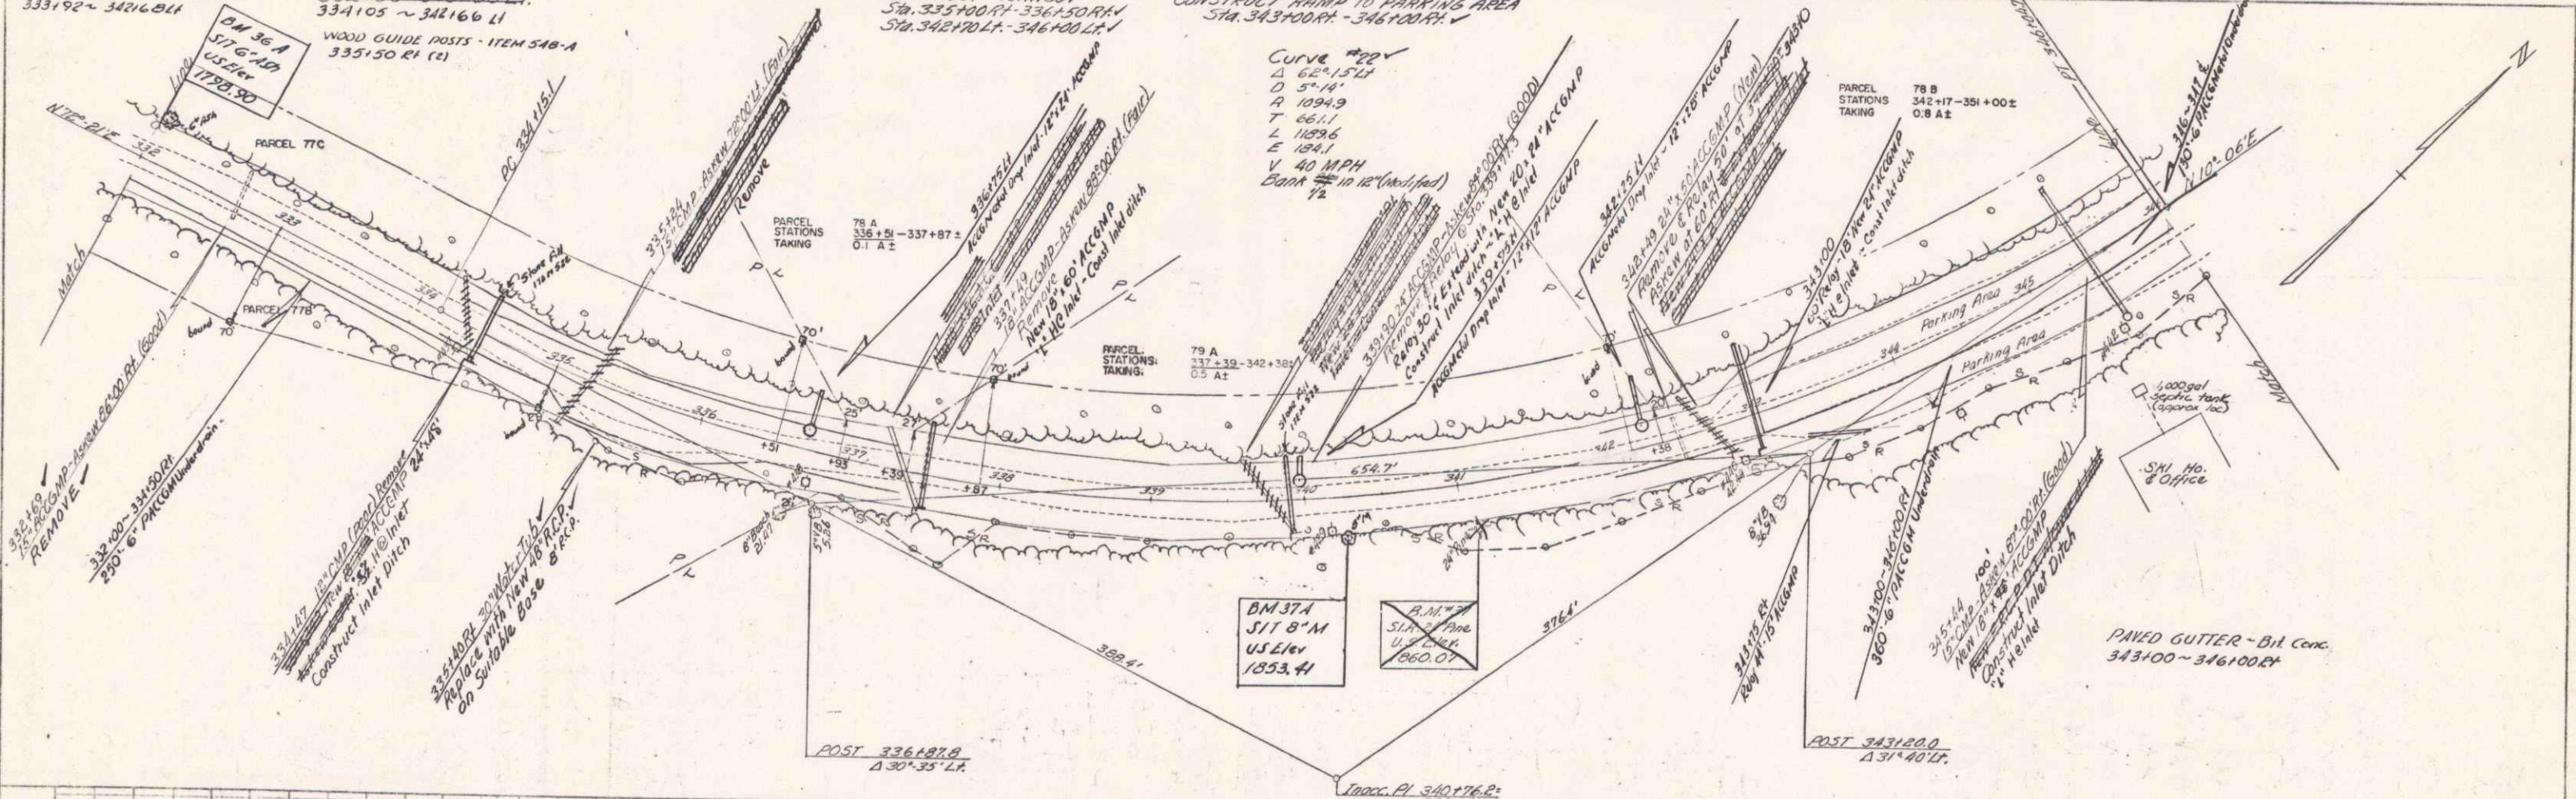

PROFILE  
 1989  
 S. QUINLAN  
 H. COMBES

PLANNED PLAN PROFILE AND ELEVATION  
 STAFFED BY: [unclear]  
 DATE: [unclear]

STAMFORD-READSBORO  
 No. 3-00000  
 Sheet 35 of 83