

TWO CABLE GUARD RAIL ITEM 342
 LT
 393+50-393+90'

WOOD GUIDE POSTS ITEM 348-A
 RT
 399+10 ~ 402+00 RT

CONSTRUCT DRIVES
 LT
 390+50 398+70
 392+35-393+60 Have
 394+00-45
 396+00
 397+40
 398+15
 400+00

CURVE #26
 Δ 20° 03' LT
 D 171.30'
 P 3819.7
 T 625.9
 L 1346.7
 E 59.2
 V 30 MPH
 Remove Crown

PARCEL: 87
 GRANTOR: MERRICK CHAPUT ESTATE
 STATIONS: 402+00-402+50
 TAKING: 50.5 AC
 REMAINDER: 0.5 AC
 RIGHTS: NONE
 TITLE TAKEN: O.C.D. 10/22/61
 RECORDED: READING, BK 29, PG 47, 10/20/61

PARCEL: 85
 GRANTOR: GERALD R. & IRENE G. LUCIA
 STATIONS: 393+57-400+00
 TAKING: 62.5 AC
 REMAINDER: 6.8 AC
 RIGHTS: NONE
 TITLE TAKEN: COND. 10/20/61
 RECORDED: READING, BK 29, PG 48, 10/25/61

PARCEL: 804
 GRANTOR: CHARLES N & CHRISTINE FERRAS
 STATIONS: 390+00-390+00
 TAKING: 0.0 AC
 REMAINDER: 0.0 AC
 RIGHTS: NONE
 DRIVE STA 390+05+L4

PARCEL: 82 A,B,C
 GRANTOR: MELVIN H. & BARBARA L. COE
 STATIONS: 385+18-425+00
 TAKING: 61.1 AC
 REMAINDER: 478.3 AC
 RIGHTS: DRAINAGE DITCH 417+50
 425+37
 432+04
 TITLE TAKEN: COND. 10/20/61
 RECORDED: READING, BK 29, PG 48, 10/25/61

PARCEL: 86
 GRANTOR: WILLIAM C. FLANNETT & LYDA R. ROBBINS
 STATIONS: 398+38-411+50
 TAKING: 12.7 AC
 REMAINDER: 0.5 AC
 RIGHTS: DRAINAGE DITCH 425+00R
 408+90L
 TITLE TAKEN: COND. 10/20/61
 RECORDED: READING, BK 29, PG 48, 10/25/61

PLAN
 DRAWN BY: S. CHAMBERS
 CHECKED BY: S. CHAMBERS
 DATE: 10/25/61

PROFILE
 DRAWN BY: S. CHAMBERS
 CHECKED BY: S. CHAMBERS
 DATE: 10/25/61

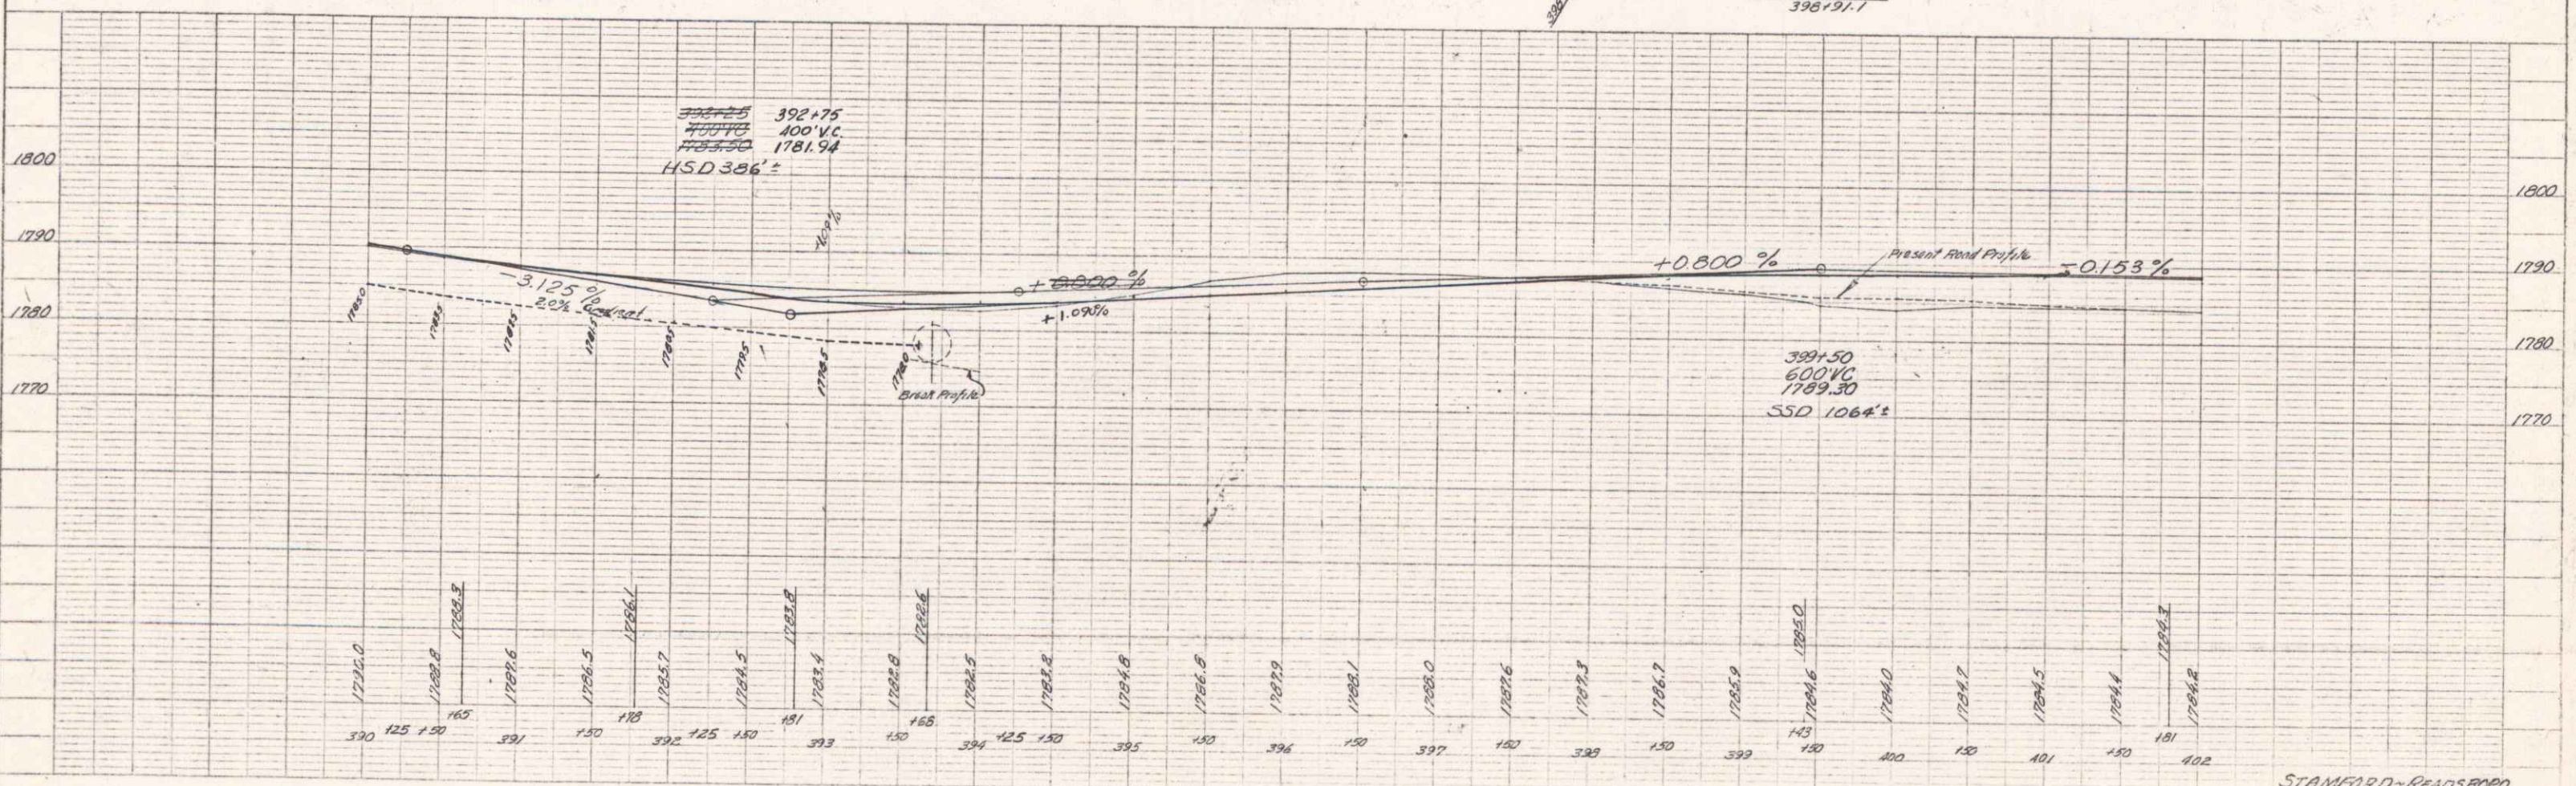


PLATE 1. PLAN PROFILE & P.L. ARE SHOWN
 SCALE: 1" = 100' HORIZ. 1" = 10' VERT.

STAMFORD-READING
 No. 5-0142(1)
 Sheet 39 of 88