

WOOD GUIDE POSTS ITEM 34B-A
~~402100 ~ 405150 RI~~
 402100 ~ 405150 RI

PARCEL: 88 A, B
 GRANTOR: DASY H. CANEY, FLORENCE A. CARRIER, & SARAH A. HAWKS
 STATION: 402+00 ~ 405+00
 TAKING: D1A2
 REMAINDER: 216.9 AC
 RIGHTS: NONE

TITLE TAKEN WOOD 11/6/81
 RECORDED READING, BK 29, PG 89, 12/15/81

PARCEL: 88 A
 STATION: 402+00 ~ 405+00
 TAKING: 216.9 AC

CONSTRUCT DRAIVES


405+20.40
 406+20.75
 409+64
 409+120
 412+100
 407+00

PARCEL: 89
 GRANTOR: DEERFIELD GLASSHE COMPANY, INC.
 STATION: 408+00 ~ 411+00
 TAKING: NONE
 REMAINDER: NONE
 RIGHTS: INLET DITCH - STA 408+90 ±
 STA 411+40 ±

TITLE TAKEN WOOD 9/27/61
 RECORDED READING, BK 29, PG 31, 10/5/61

PARCEL: 88 B
 STATION: 411+00 ~ 413+00
 TAKING: 0.1 AC

PARCEL: 80 B
 GRANTOR: WILLIAM C. PLUNKETT & MARGARET P. LORD
 STATION: 413+00 ±
 TAKING: DRIVE STA 413+00 ± R/L
 RIGHTS: NONE

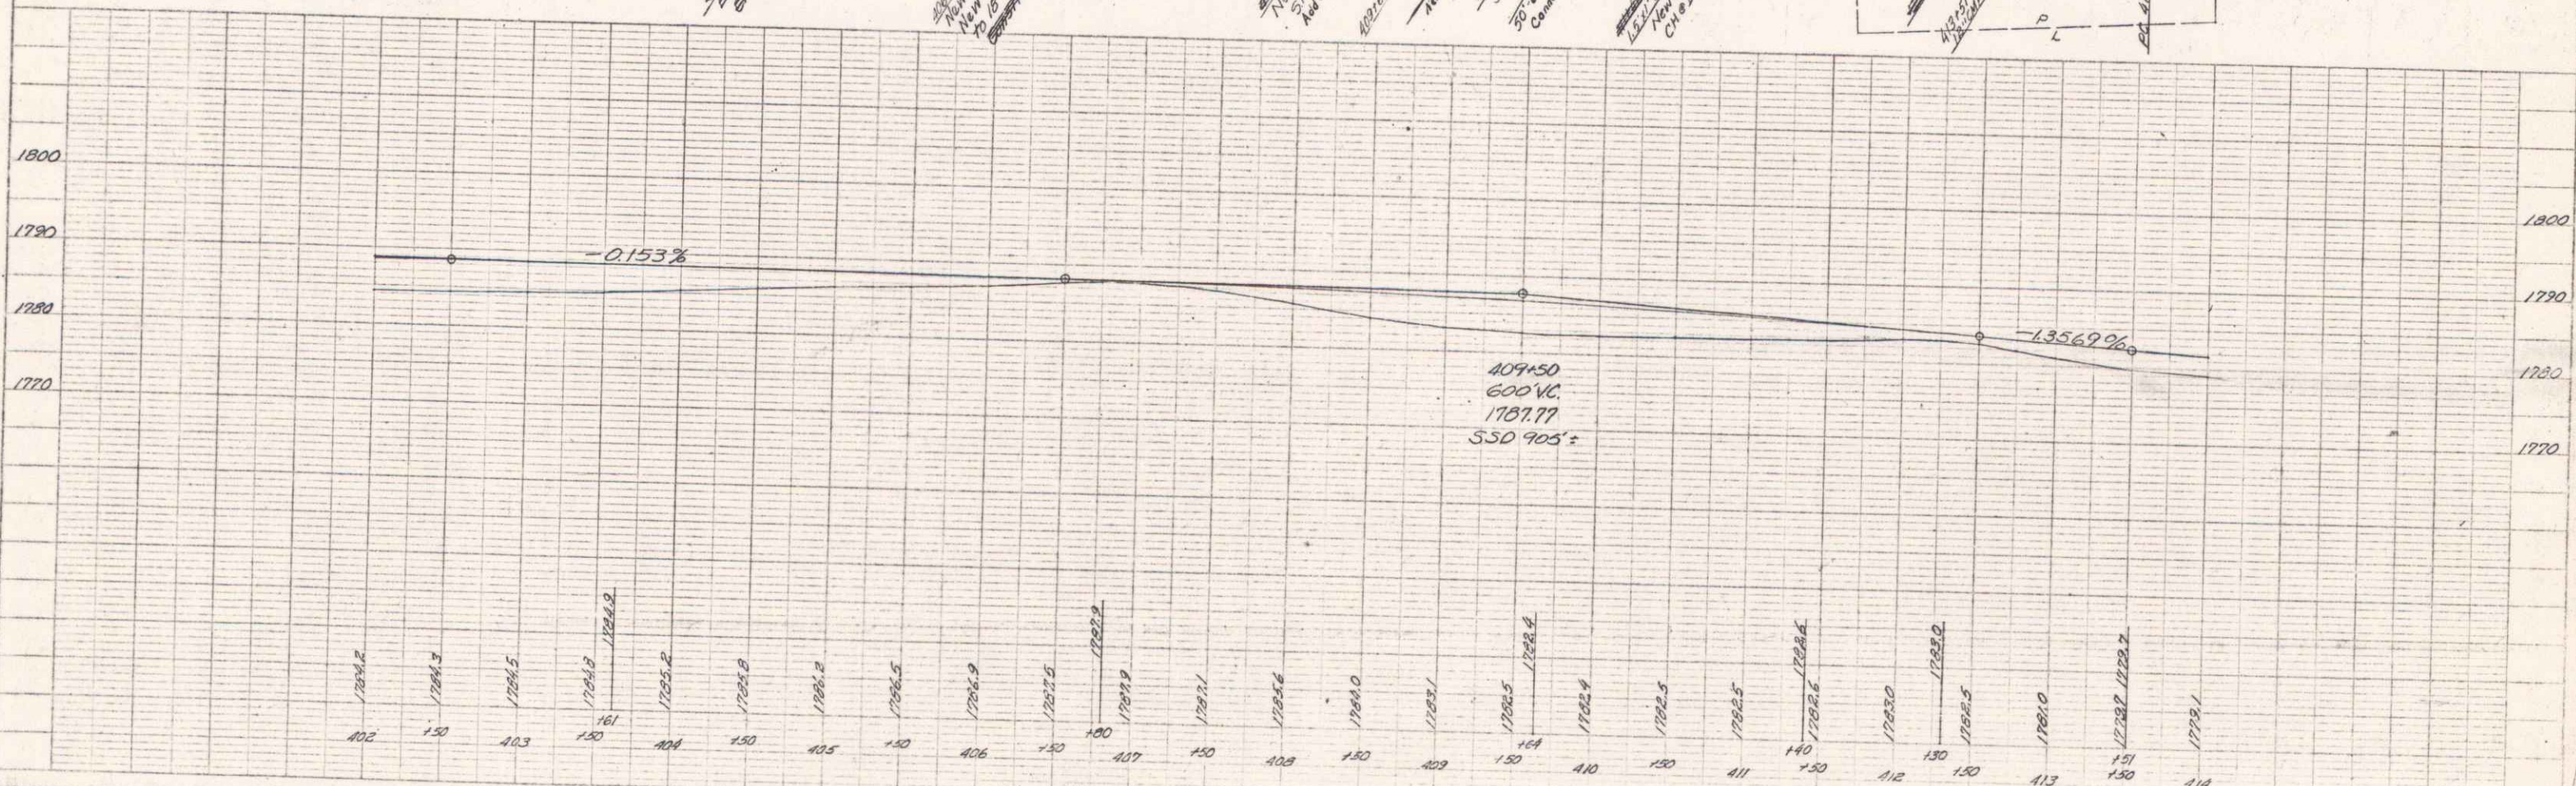

PLANNING
 DESIGN
 CONSTRUCTION
 RECORDING

PROFILE
 STATIONS
 ELEVATIONS