


TWO CABLE GUARD RAIL
LT
155+50 - 171+00

UNCLASSIFIED CHANNEL
EXCAVATION
LT
155+50 - 158+50

STONE FILL FOR SLOPE
PROTECTION (LIGHT TYPE)
LT
155+90 - 158+50

DRILLING & BLASTING OF
SOLID ROCK SUBGRADE
158+25 - 159+75

EXCAVATION & REMOVAL OF ROAD
SURFACES AND/OR PAVEMENTS
LT
155+00 - 155+60

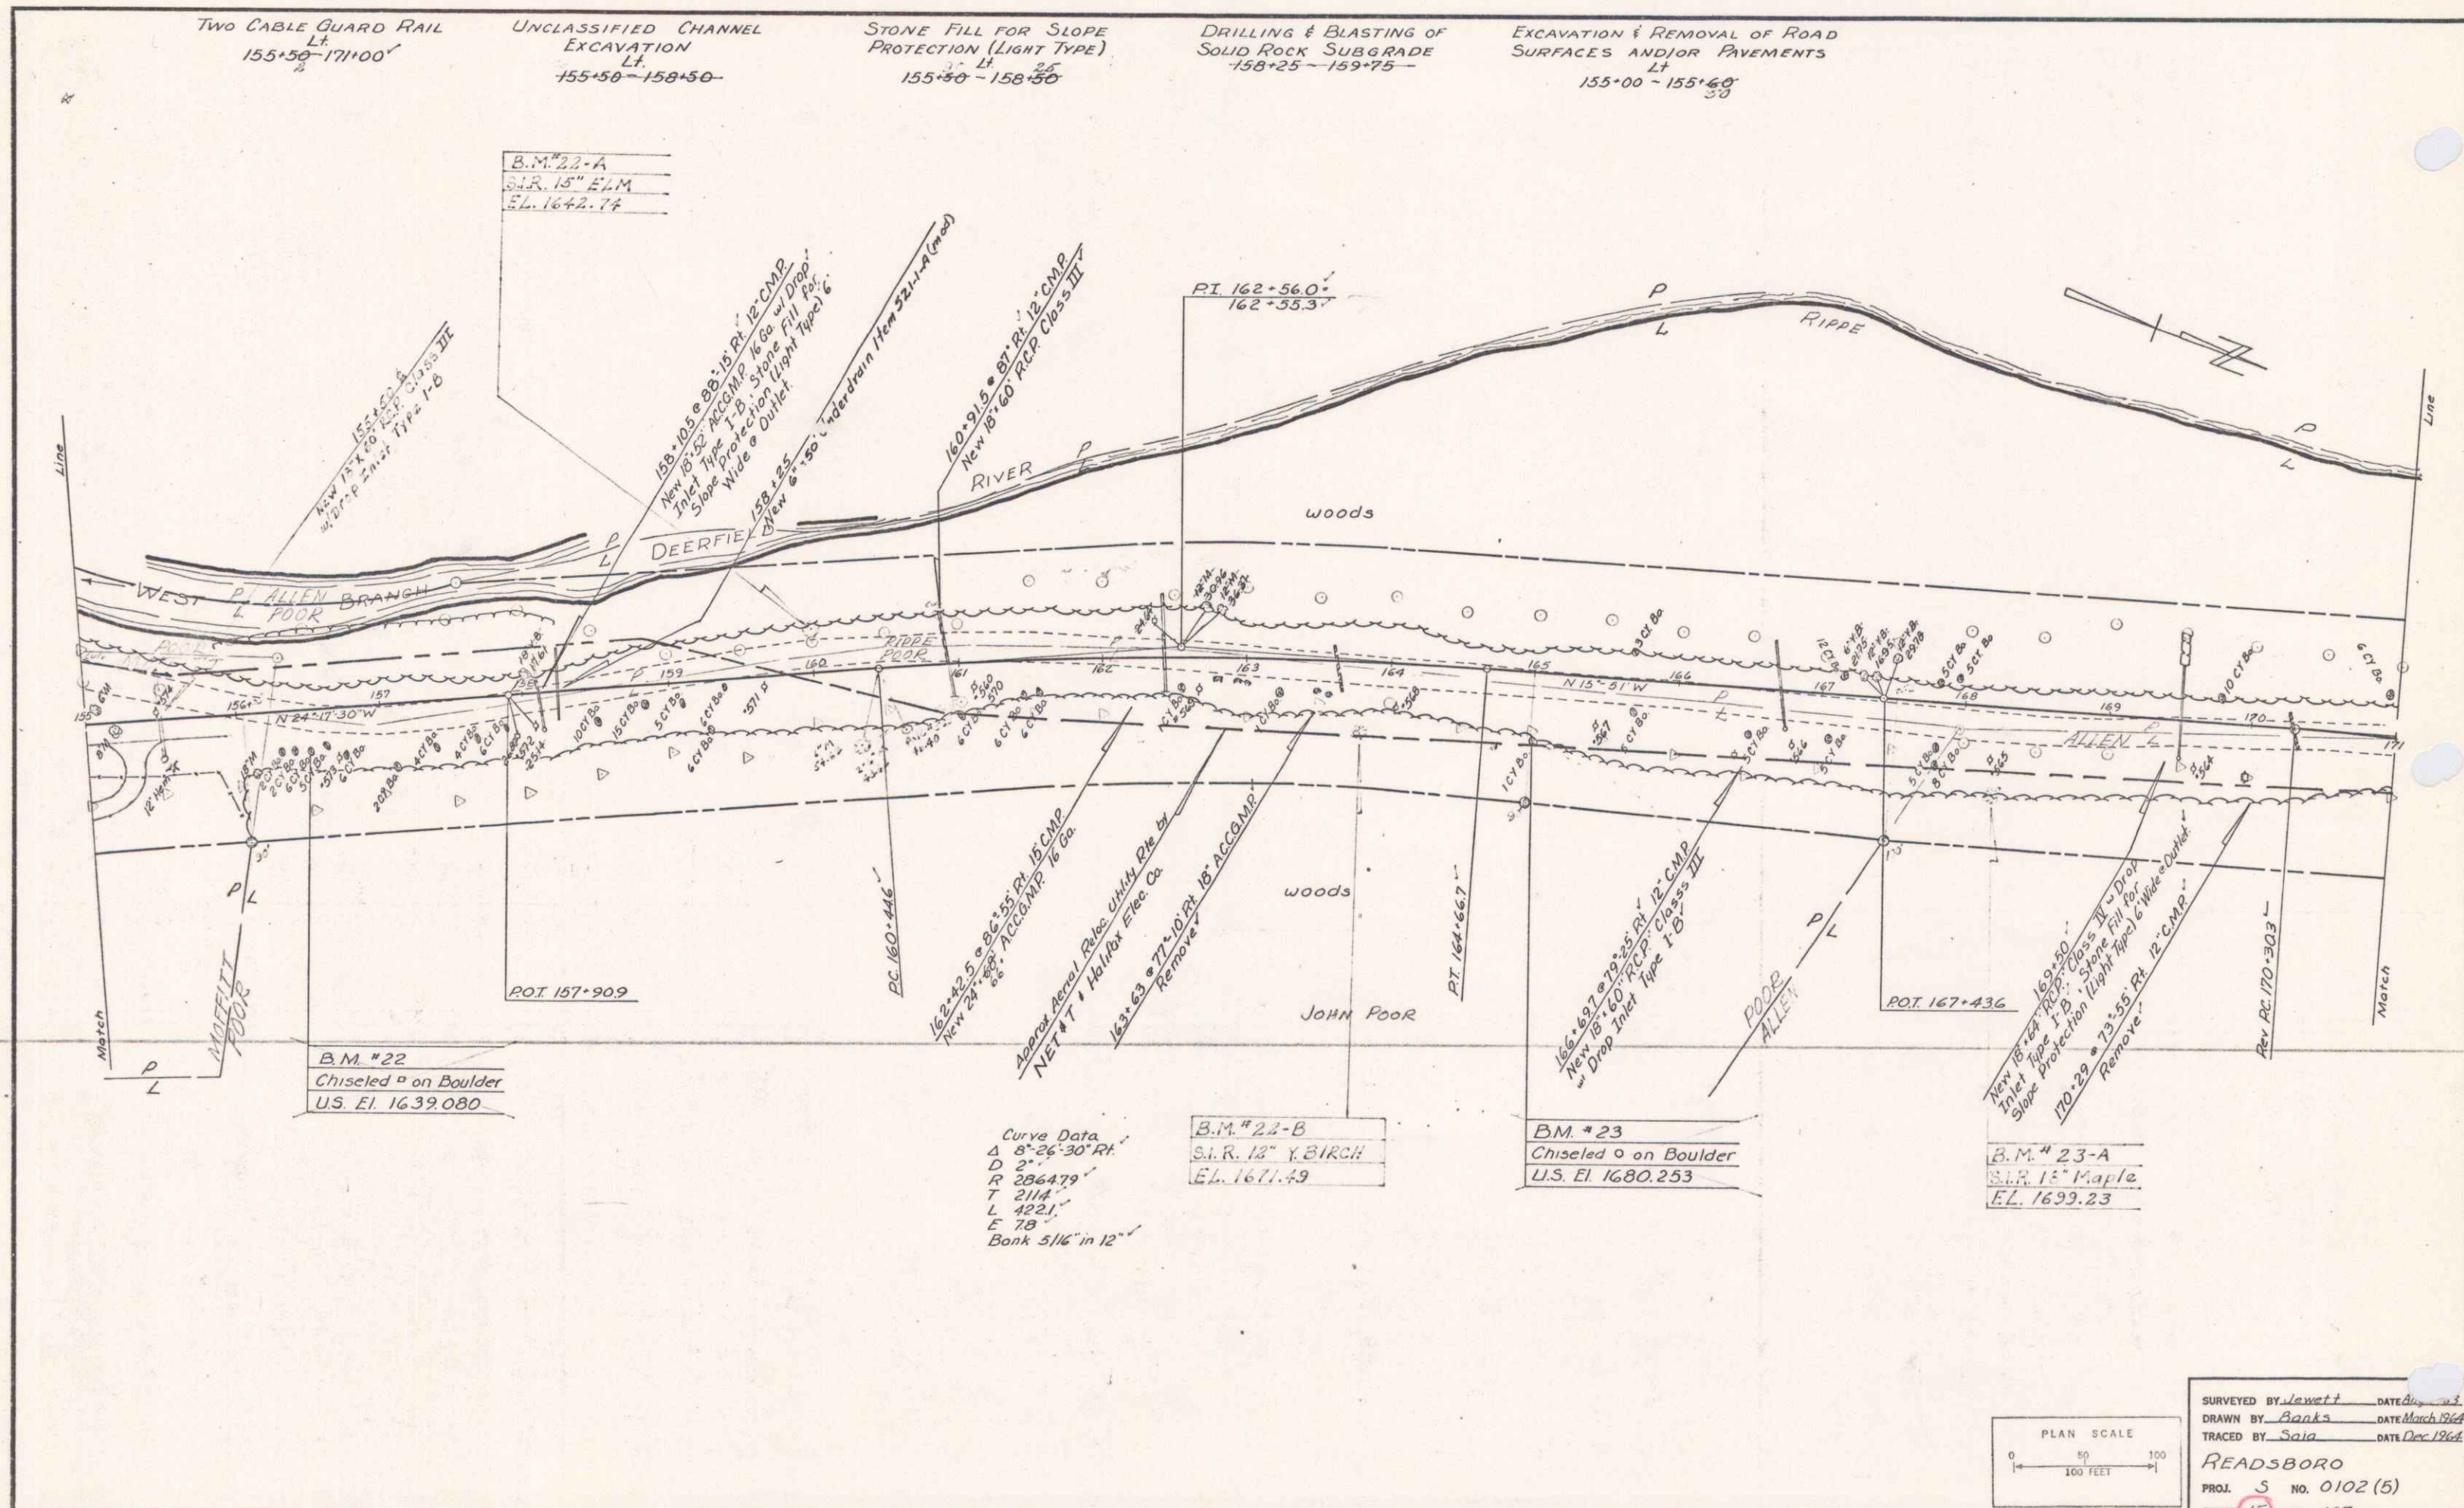

B.M. #22-A
S.I.R. 15" E.L.M.
E.L. 1642.14

PT 162+56.0
162+55.3


B.M. #22
Chiseled o on Boulder
U.S. El. 1639.080

Curve Data
Δ 8°26'30" Rt.
D 2"
R 2864.79'
T 211.4'
L 422.1'
E 79'
Bank 5 1/4" in 12"

B.M. #22-B
S.I.R. 12" Y. BIRCH
E.L. 1671.49

B.M. #23
Chiseled o on Boulder
U.S. El. 1680.253

B.M. #23-A
S.I.R. 15" Maple
E.L. 1693.23

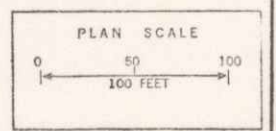

SURVEYED BY Lewett DATE Dec 1964
DRAWN BY Banks DATE March 1964
TRACED BY Sala DATE Dec 1964
READSBORO
PROJ. S NO. 0102 (5)
SHEET 15 OF 103