


DRILLING & BLASTING OF
SOLID ROCK SUBGRADE
235+25-242+25
53-236+25
239+00-243+20

TWO CABLE GUARD RAIL
LT. RT.
235+00-237+50 235+00-235+40
235+50 73


MUCK EXCAVATION
243+50-251+00

EXCAVATION & REMOVAL OF ROAD
SURFACES AND IOR PAVEMENTS
RT.
243+05-251+00

CONSTRUCT DIVE
245+10 RT.

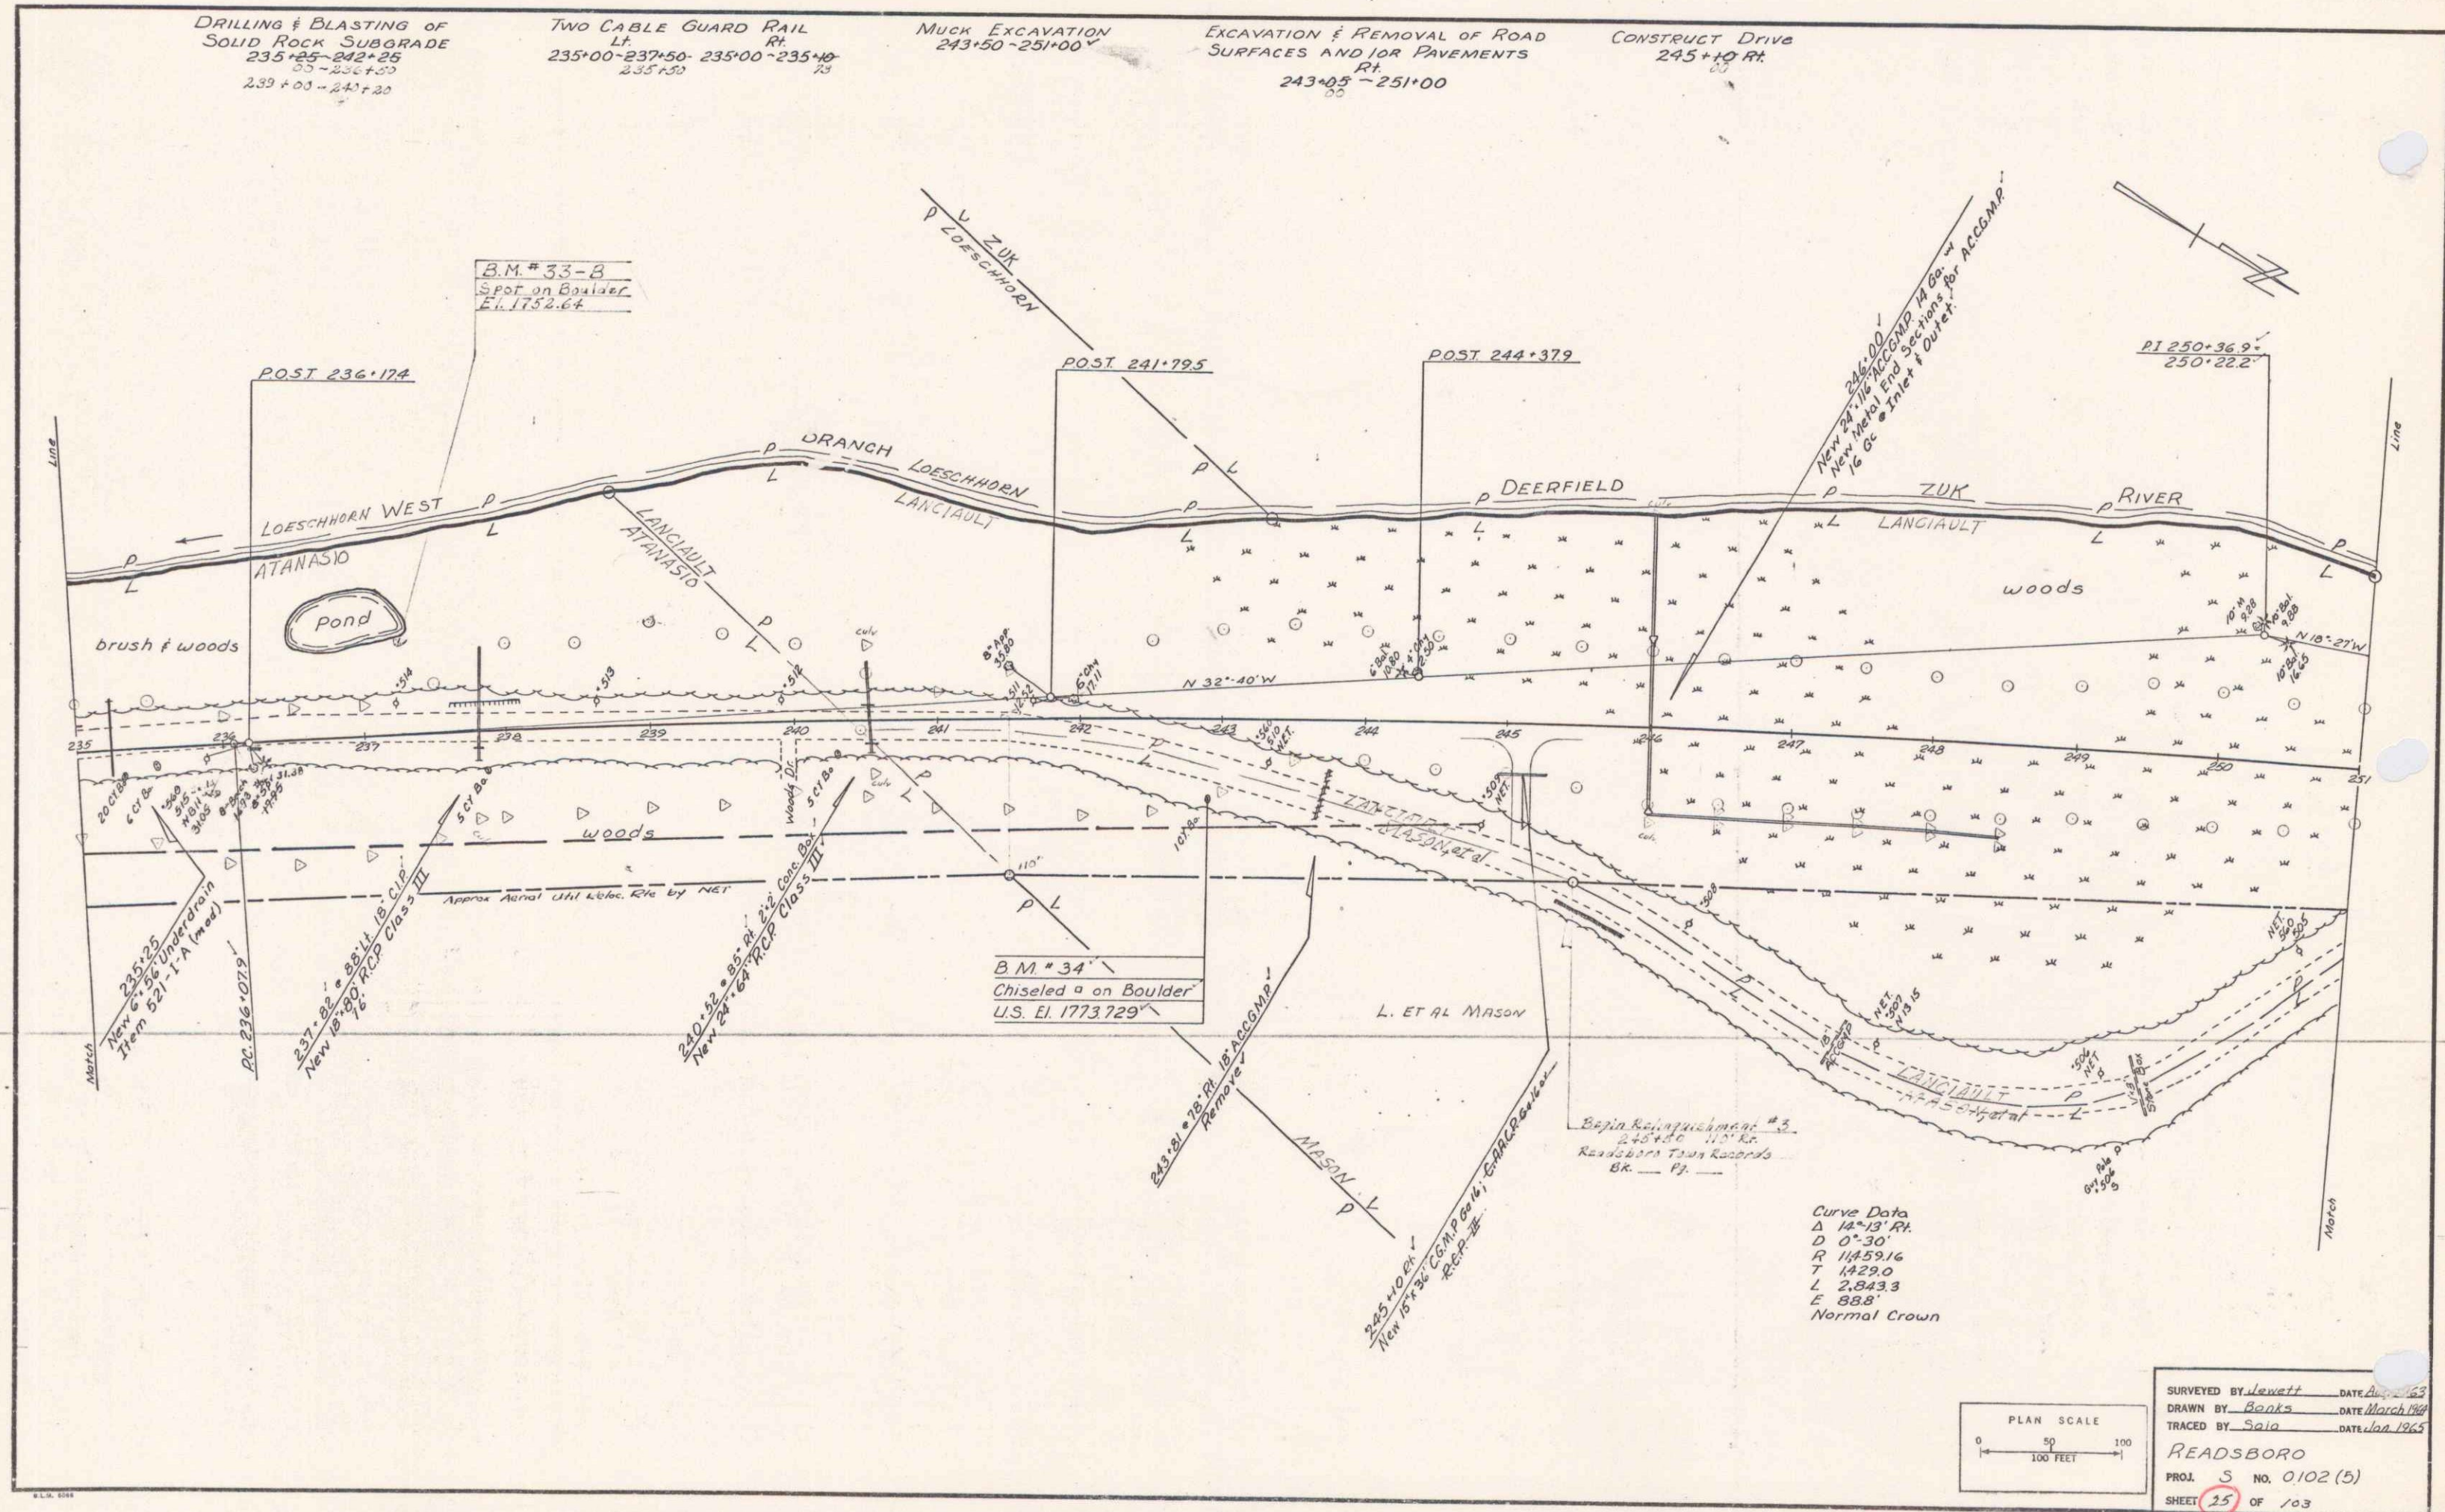

Curve Data
 Δ 14°13' Rt.
 D 0°30'
 R 11459.16
 T 1429.0
 L 2843.3
 E 888'
 Normal Crown

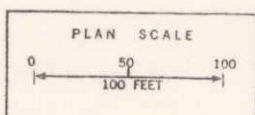

SURVEYED BY *Jewett* DATE *Aug 1963*
 DRAWN BY *Banks* DATE *March 1964*
 TRACED BY *Sala* DATE *Jan 1965*
 READSBORO
 PROJ. S NO. 0102 (5)
 SHEET 15 OF 103