

DRILLING & BLASTING
SOLID ROCK SUBGRADE
203+00 - 206+75
213+75 - 219+00

TWO CABLE GUARD RAIL
LI
207+00+15+00 - 209+25 - 209+00
208+52 - 213+00

CONSTRUCT APPROACH
RI
209+00

CONSTRAINT DRIVE
RI
211+00

WOOD GUIDE POSTS 5%
RI
211+00.25+1 - 215+70 (42+00)

UNCLASSIFIED CHANNEL
EXCAVATION
LI
207+75 - 213+00

STONE FILL FOR SLOPE
PROTECTION (LIGHT TYPE)
LI
207+75 - 213+00

EXCAVATION & REMOVAL OF ROAD
SURFACES AND ICR PAVEMENT
LI
203+00 - 207+45
213+00 - 219+00

CONSTRUCT SPECIAL DITCH
(to be paid for under item 103-A1)
RI
210+00 - 211+00

BM 231
STW 13+M
U.S. 21 1936 265

END RELINQUISHMENT #2
STA. 207+22 - 113' LI

206+85
70'

207+52
145'

208+36
63'

635'

213+85
135'

213+85
11'

213+75
85'

823'

1027'

9

712'

8

203+00
140'


553'

208+50
180'

535'

388'

217+52
170'

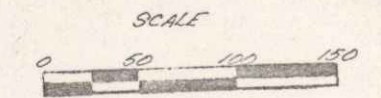

VERMONT DEPARTMENT OF HIGHWAYS
RIGHT-OF-WAY PLANS
PROJECT: READSBORO
NO: 30102(5)
SHEET: 10 OF 21

14