
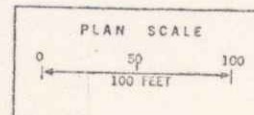


DEMOLITION & DISPOSAL OF BUILDING RT #1 @ 61+75'
 STONE FILL FOR SLOPE PROTECTION (LIGHT TYPE) LT 63+25 ~ 74+25'
 CHANNEL EXCAVATION ITEM LT 63+25 ~ 66+40 108-C
 EXCAVATION & REMOVAL OF ROAD SURFACES AND/OR PAVEMENTS RT 63+63 ~ 66+93 70+00 ~ 73+30'
 TREATED TIMBER CURB LT 66+50 ~ 74+74 45
 CONSTRUCT PAVED SHOULDER (WITH ITEM 361 (Mod)) LT 66+50 ~ 74+74

TWO CABLE GUARD RAIL LT 61+00 ~ 77+00 60+30

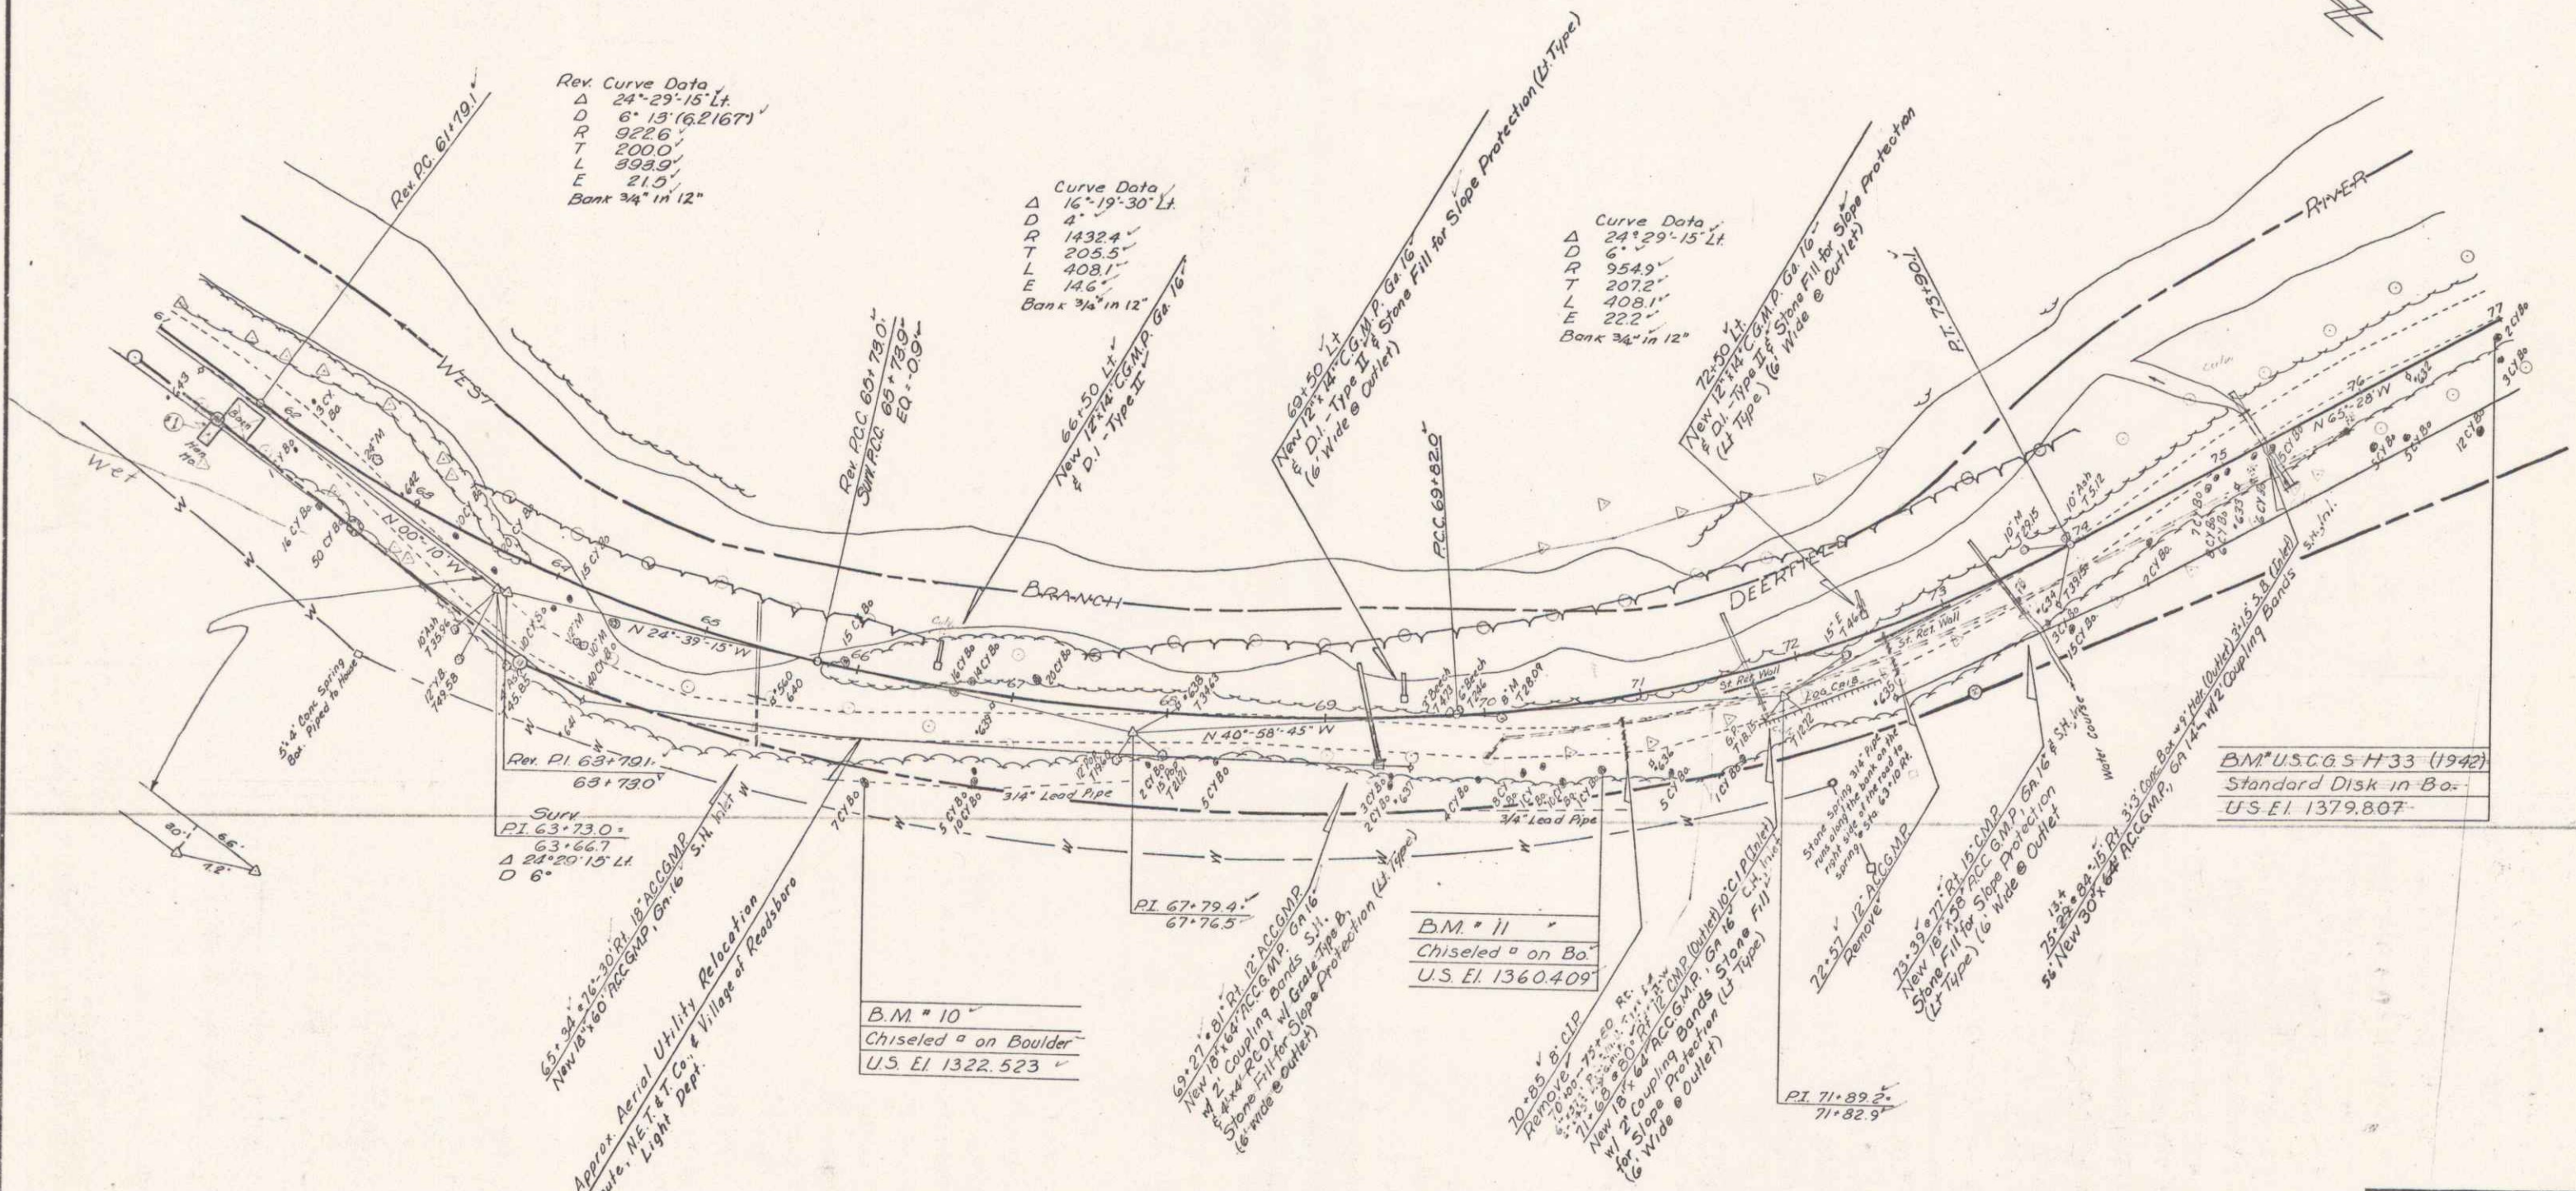

SURVEYED BY *Lawth* DATE 4-66
 DRAWN BY *Sain* DATE 5-66
 TRACED BY *Sain* DATE 5-66
 READSBORO
 PROJ. 5 NO. 0102 (6)
 SHEET 13 OF 133