


CONSTRUCT METAL BIN TYPE RETAINING WALL LT 93100-93120  
 CONSTRUCT SPECIAL DITCH (PAVE WITH ITEM 534 Mod) LT 93100-100+80  
 CONSTRUCT PAVED SHOULDERS (WITH ITEM 361 Mod) LT 93100-100+80 RT 93100-93+60 108+75-109100  
 TREATED TIMBER CURB RT 93100-93+60 108+75-109100  
 TWO CABLE GUARD RAIL RT 93100-109100  
 EXCAVATION & REMOVAL OF ROAD SURFACES AND/OR PAVEMENTS LT 103+18-104+00  
 DRILLING & BLASTING OF SOLID ROCK SUBGRADE 102+10 - 104+25

STONE FILL FOR SLOPE PROTECTION (LIGHT TYPE) RT 100+50-102+90 105+50-109100  
 CHANNEL EXCAVATION ITEM 108-C RT 93105-94+65 97+05-100+20 100+55.5-102+70 105+50-107+00  
 CONSTRUCT SPECIAL DITCH (to be paid for under Item 106-A) LT 105+50+LT-106+00+LT  
 CONSTRUCT DRIVE LT 104+00-107+00 (To be paid for under the item of Bulldozer Logging Road 150+11 107+00)

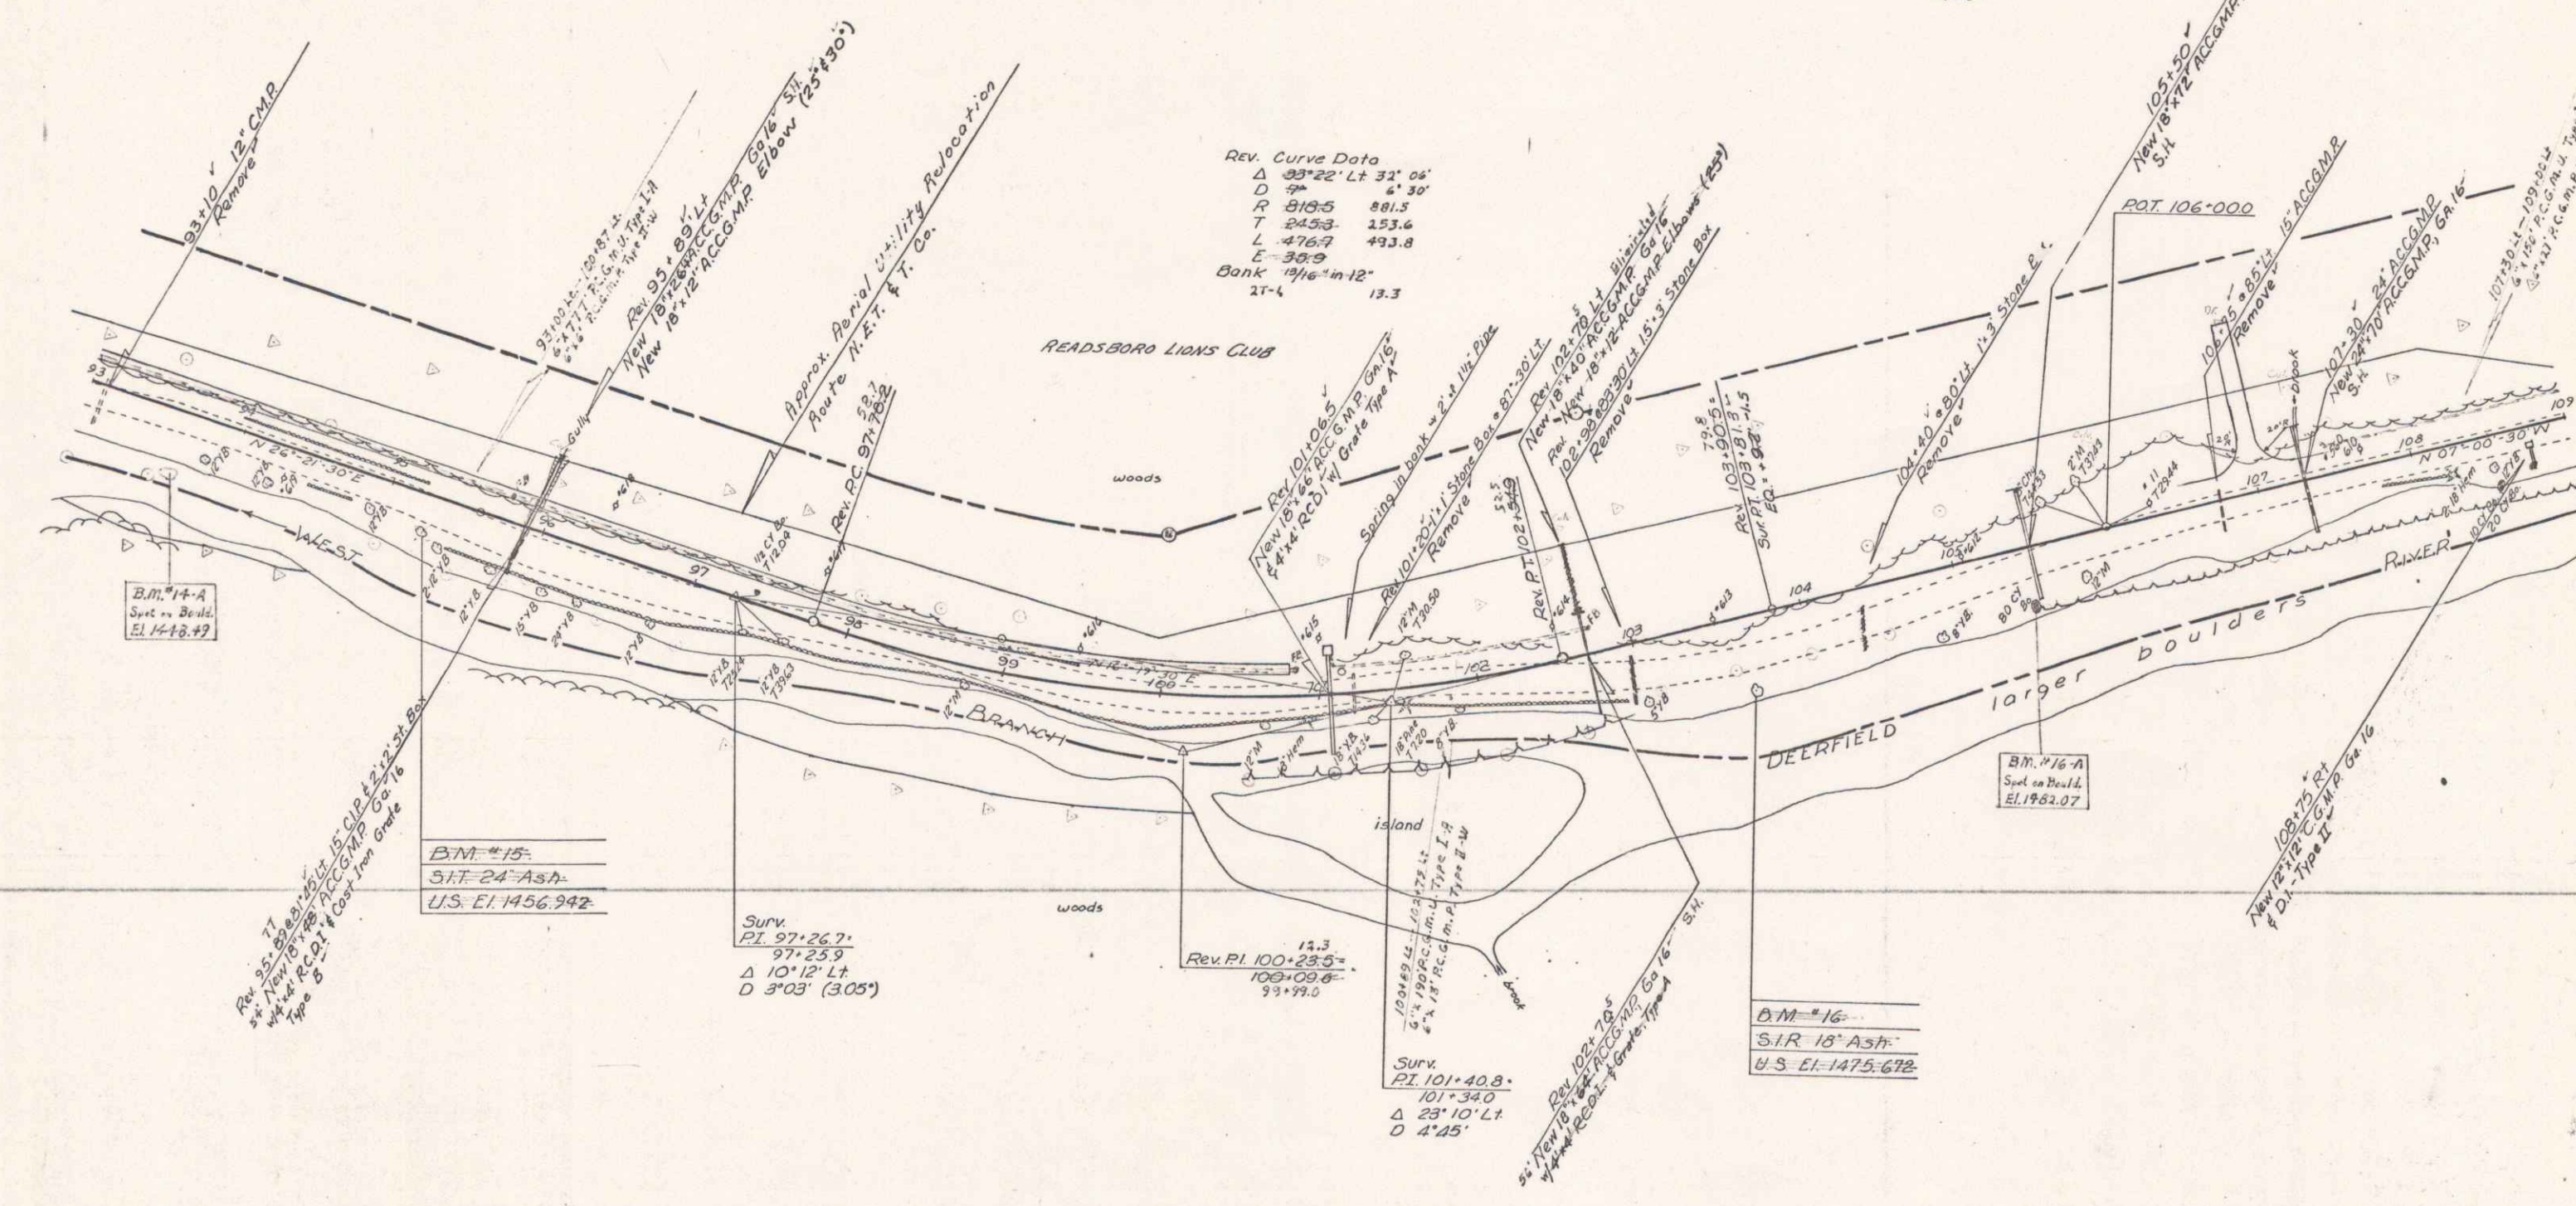

B.M. #14-A  
 Spt. on Bould. EL 1478.47  
 B.M. #15  
 Spt. 24' Ash U.S. EL 1456.942  
 Surv. PI 97+26.7 97+25.9 Δ 10°12' Lt D 3°03' (3.05)  
 Rev. PI 100+23.5 100+09.6 93+99.0  
 Surv. PI 101+40.8 101+34.0 Δ 23°10' Lt D 4'45"  
 B.M. #16-A  
 Spt. on Bould. EL 1482.07  
 B.M. #16  
 Spt. 18' Ash U.S. EL 1475.672  
 PLAN SCALE  
 0 50 100  
 100 FEET  
 SURVEYED BY Jewett DATE 4-66  
 DRAWN BY Saja DATE 5-66  
 TRACED BY Saja DATE 5-66  
 READSBORO  
 PROJ. S NO. 0102 (6)  
 SHEET 17 OF 133