

EXCAVATION & REMOVAL OF ROAD SURFACES
AND/OR PAVEMENTS
LT.
140163-141100

TWO CABLE GUARD RAIL
LT.
140196-144100
1-21-67

STONE FILL FOR SLOPE PROTECTION
(LIGHT TYPE)
LT.
142110-144100

UNCLASSIFIED CHANNEL EXCAV.
LT.
142110-144100

DRILLING & BLASTING OF
SOLID ROCK SUB-GRADE
140102.5-142175



CONSTRUCT TURNOUT
LT.
140102.5-140175

POOR ORIGINAL COPY

DM #21
SIP 15' Patch
U.S. E1 1529 688

PT. 140163-
140102.5
EQ #101.6

STA. 144+00.0
END PROJECT S-0102(6)
Construct. Sub-factory Appr.
PROJECT S-0102(5) (1968)
BEGINS

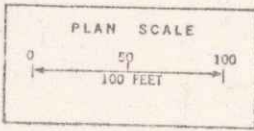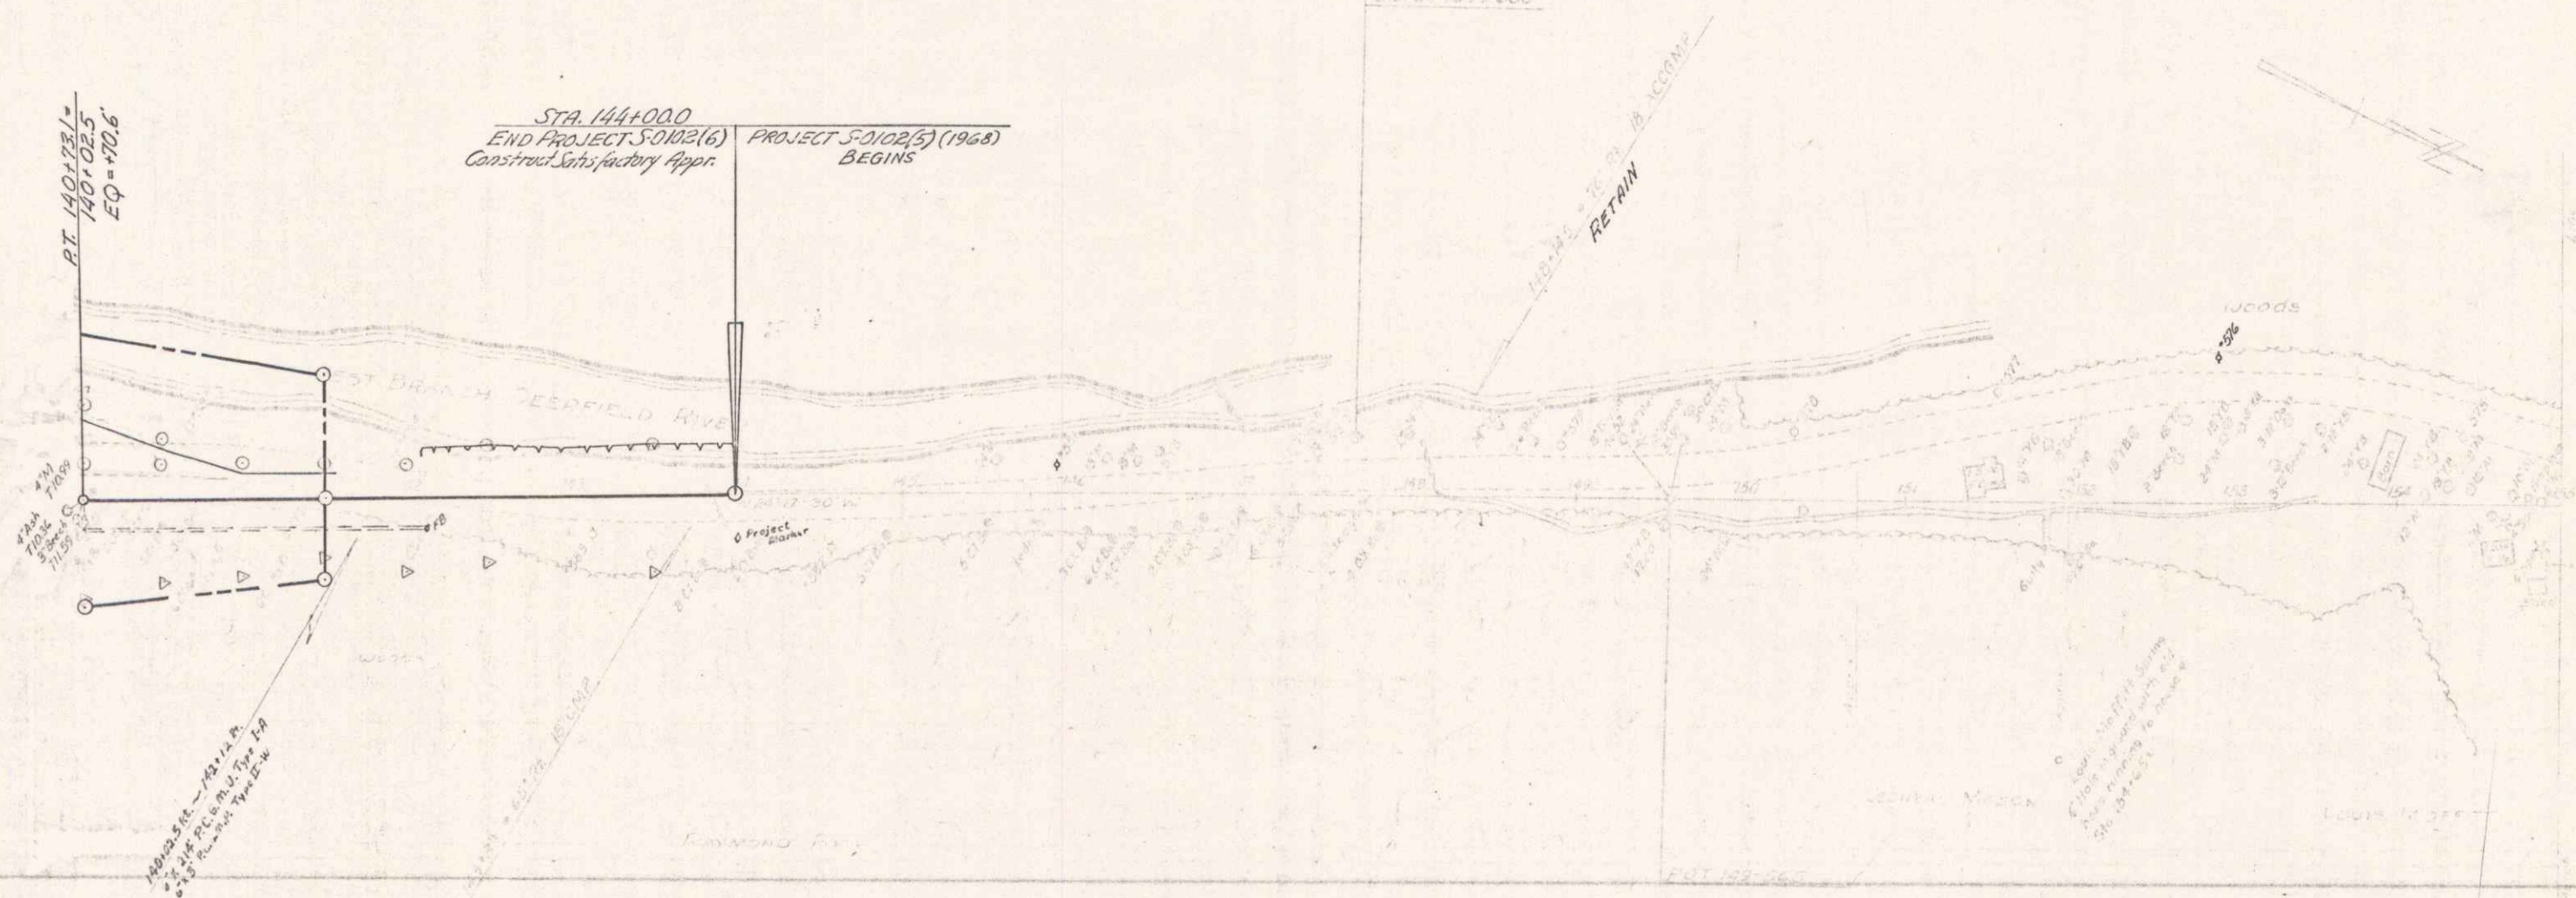

Revised 5-10-66 BPS
23 133 6

8