


Vermont Department of Highways
 State Engineer
 State Capitol Building
 Montpelier, Vermont
 1930-1935
 1935-1940
 1940-1945
 2095-2100

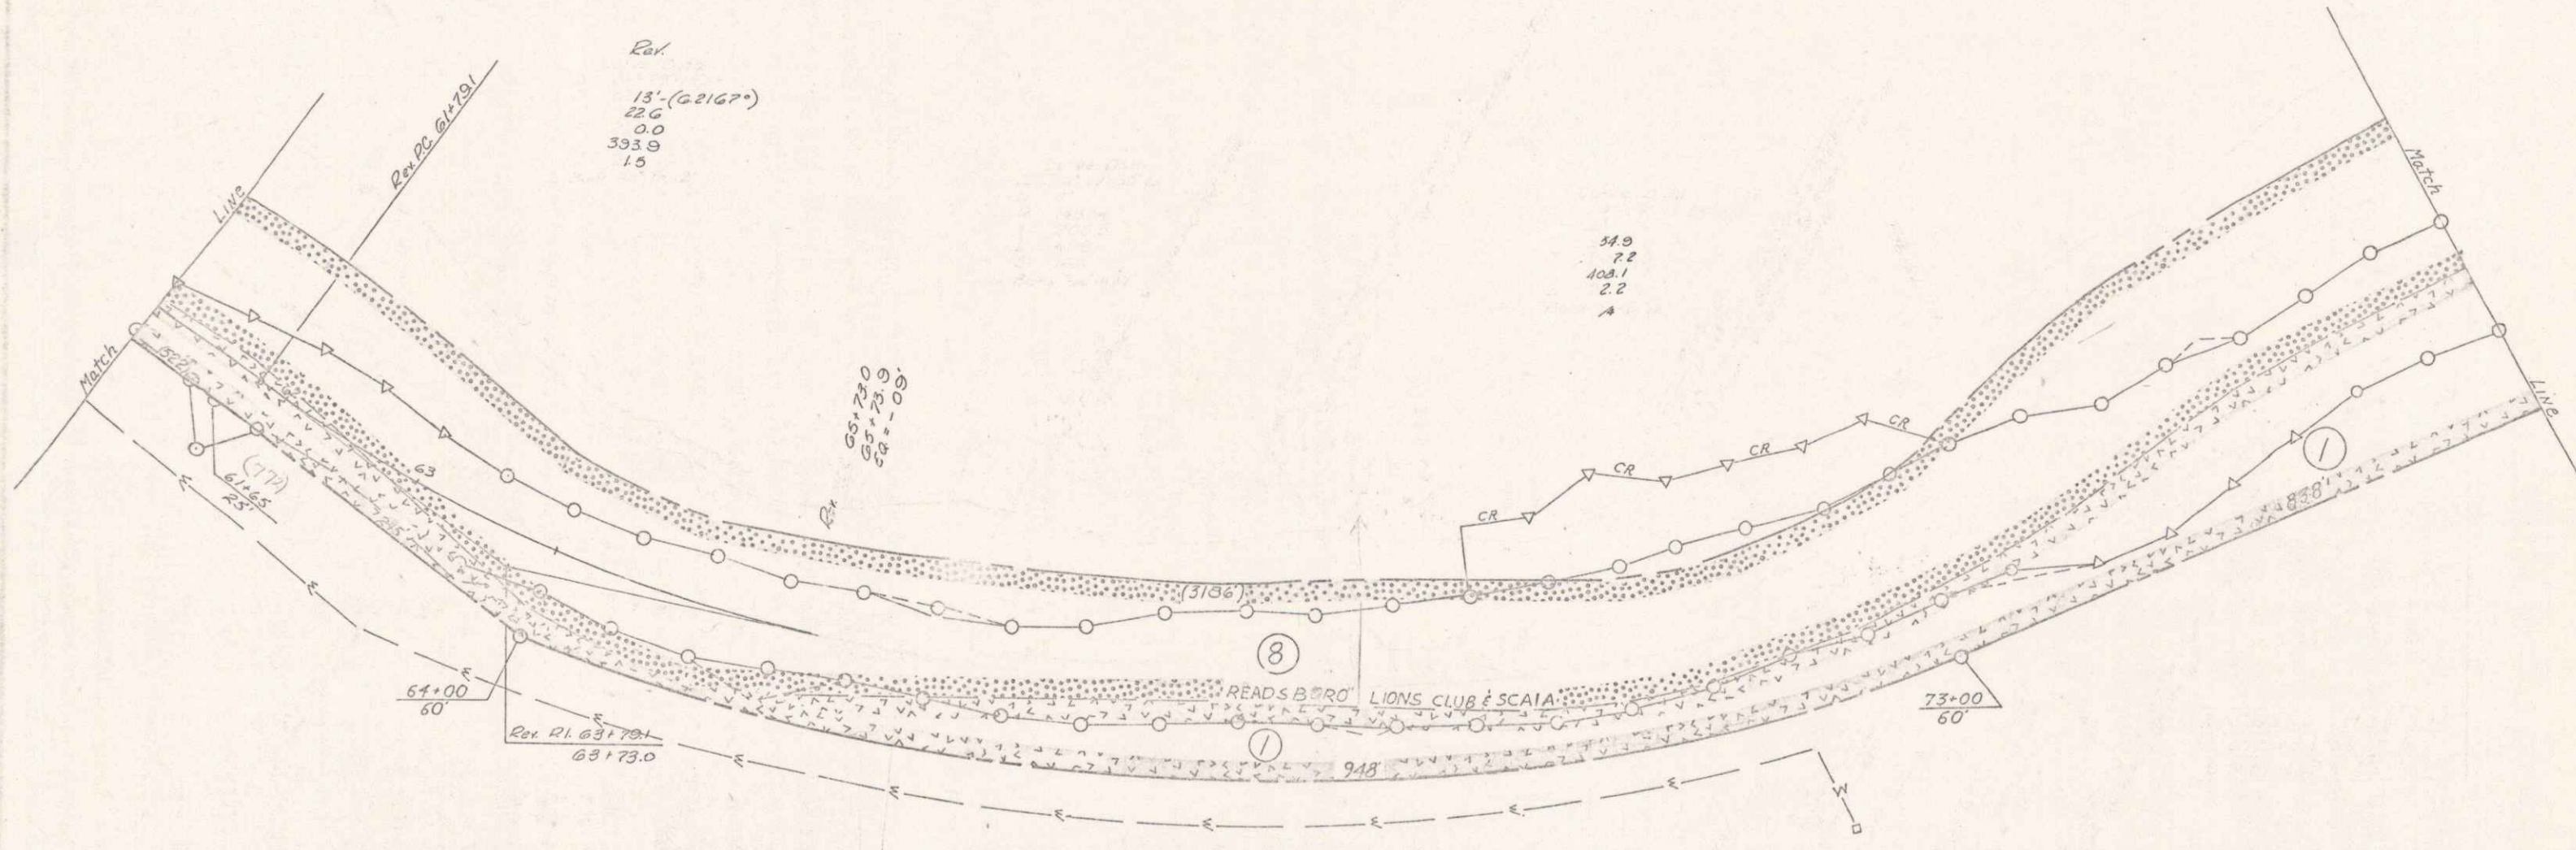

Elev
 13' (22167)
 22.6
 0.0
 393.9
 1.5

54.9
 7.2
 108.1
 2.2
 A

65+72.0
 65+70.9
 68+1+09

VERMONT DEPARTMENT OF HIGHWAYS
 RIGHT-OF-WAY PLANS
 PROJECT READSBORO
 NO 50102(6)
 SHEET 6 OF 67