


REV. CURVE  
 $\Delta 32^{\circ}50' 27''$   
 $D 42^{\circ}35'$   
 $E 1273.6$   
 $T 875.1$   
 $L 729.6$   
 $E 54.1$

Red - from plan of  
 Town Clerk's Office  
 6/6/75

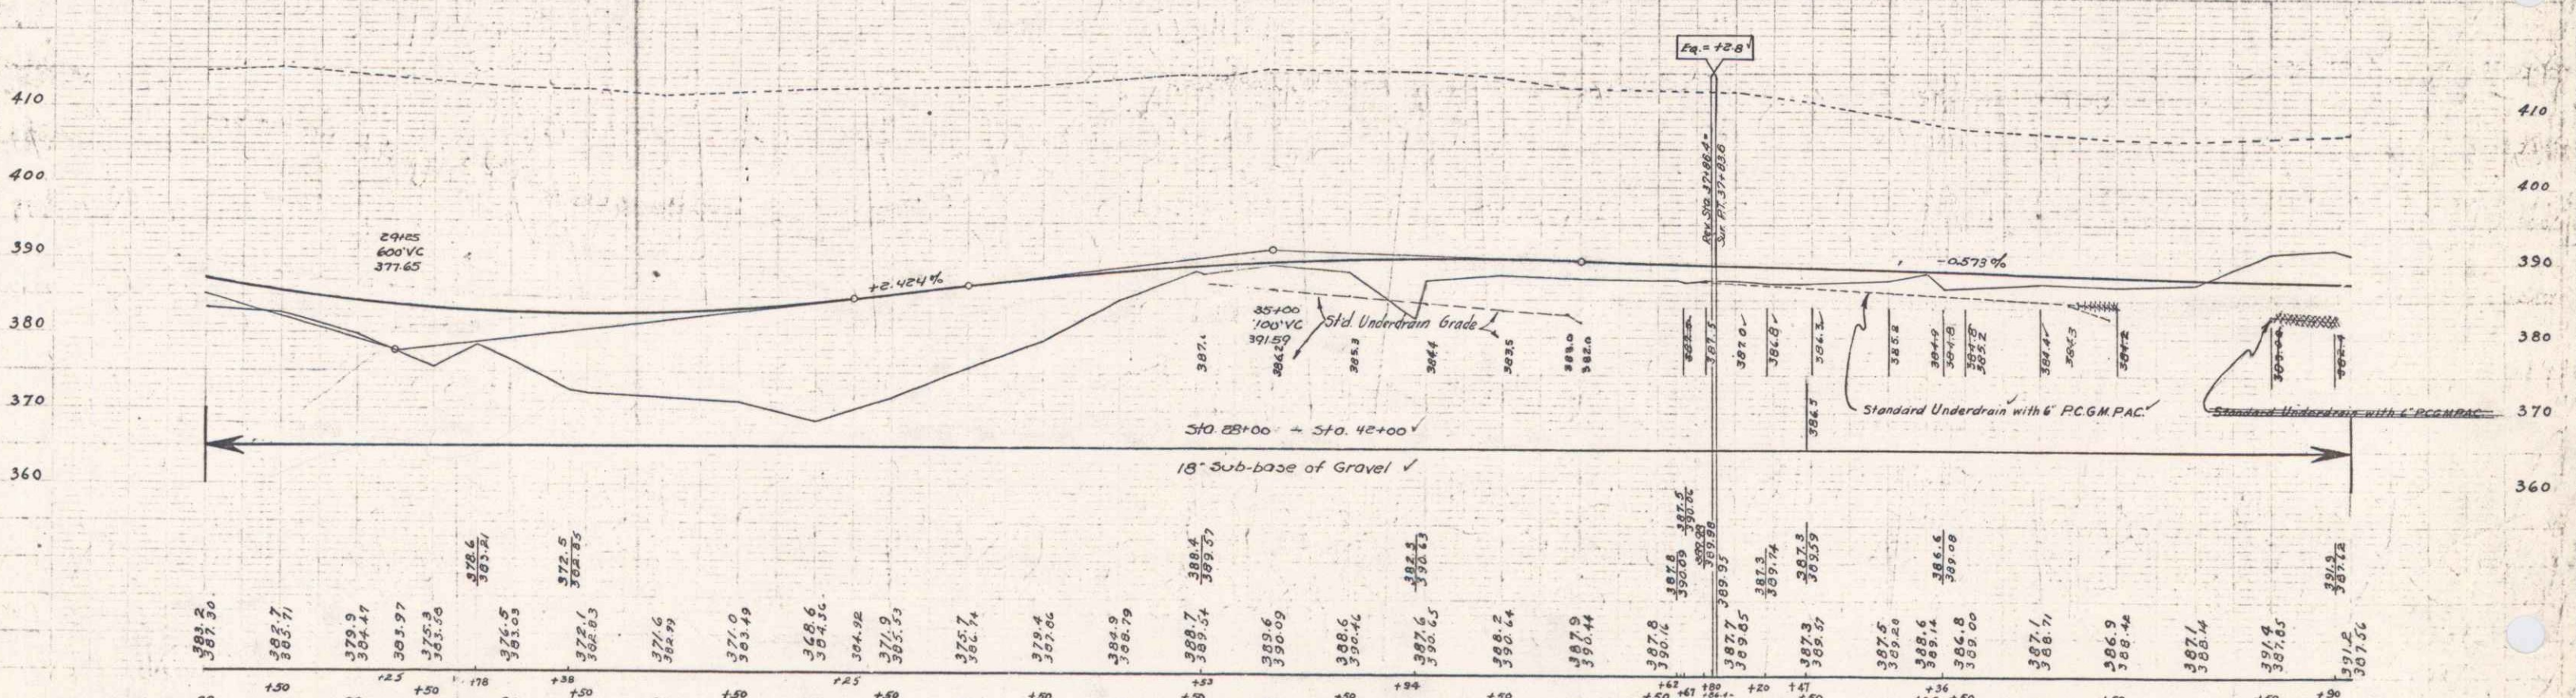

B.M. #7 SPOT ON BOULDER 57' LT STA 33+17 ELEV. 410.28  
 B.M. #8 SPOT ON LEDGE 74' LT STA 40+23 ELEV. 409.72