


PLAN
SITE PLAN
DATE

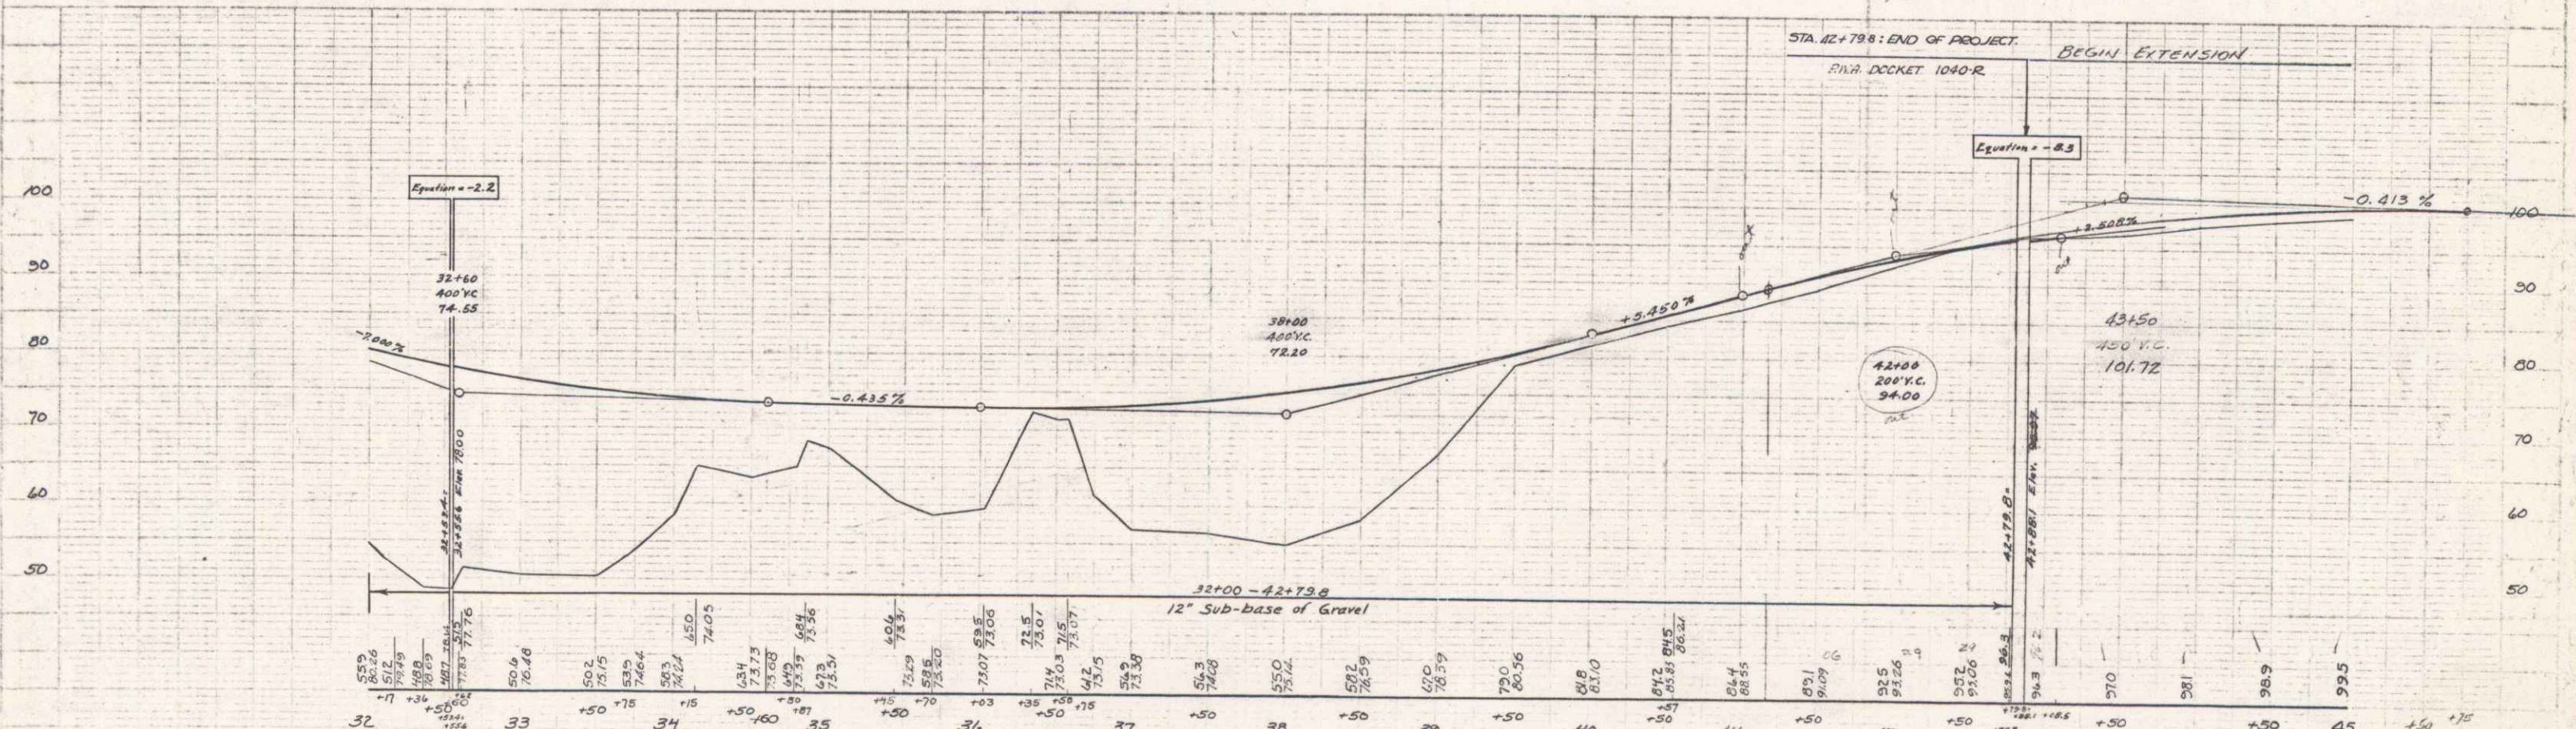

32+00 - 42+75.0
12" Sub-base of Gravel

Sheet 8 of 27

6