
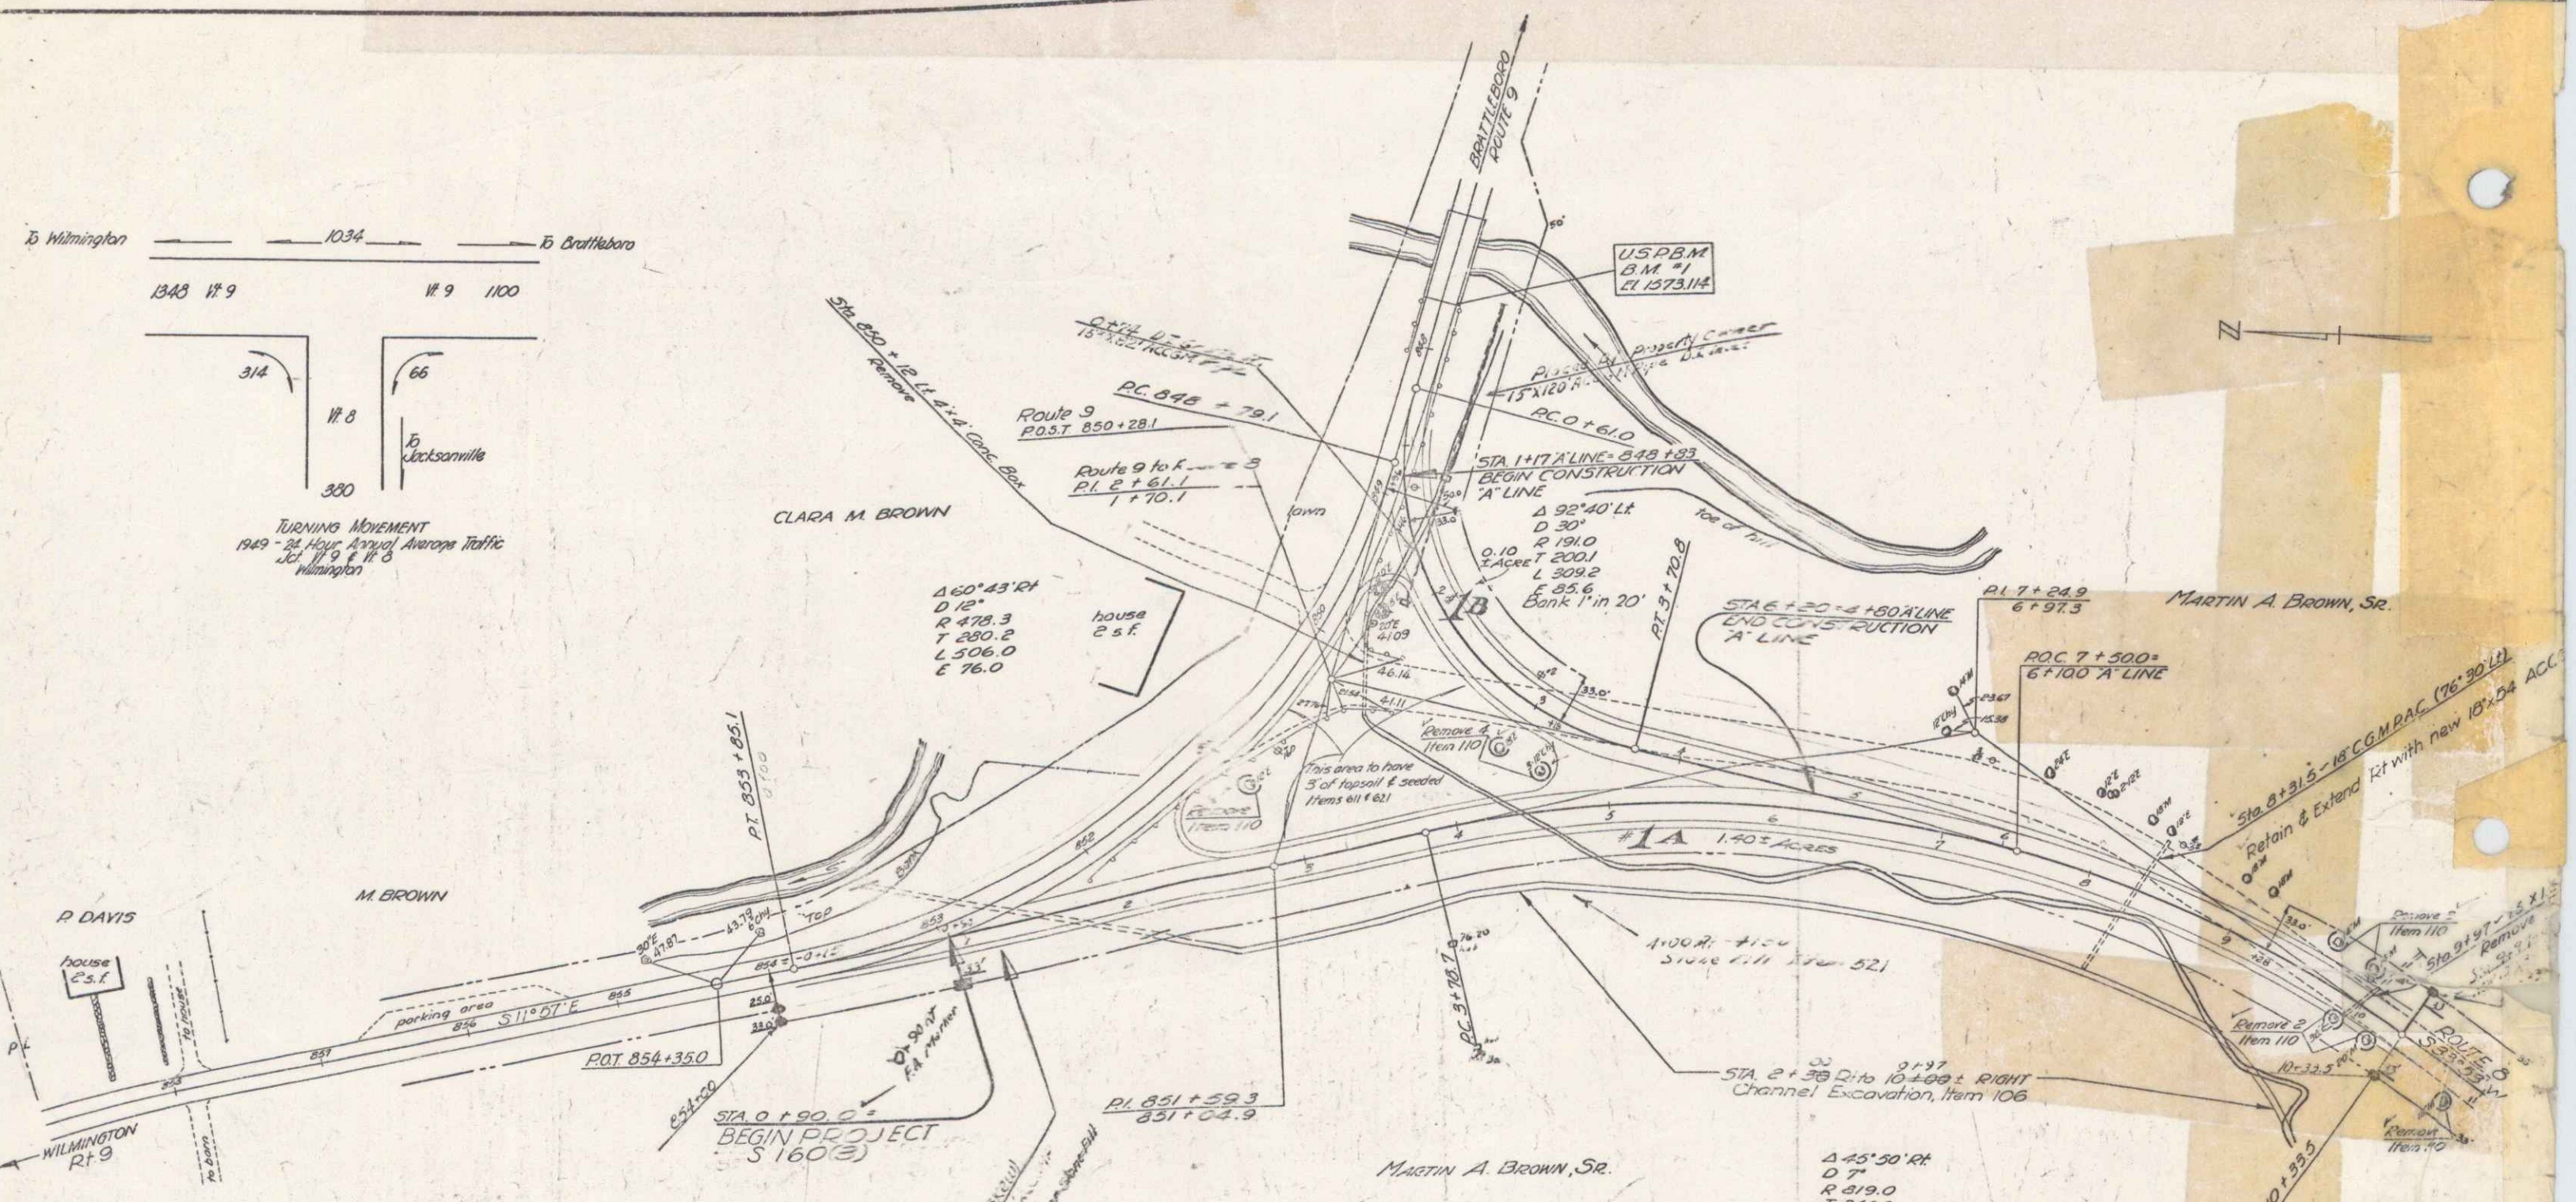


To Wilmington 1034
 1343 Rt 9
 To Brattleboro 1100
 Rt 9

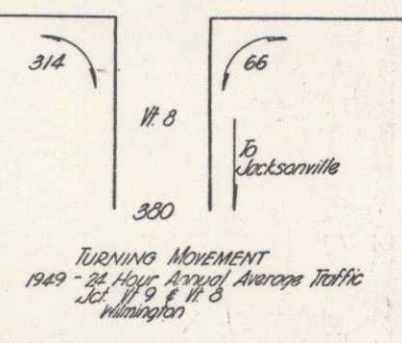

PARCEL # 1, B, 40
 INSTRUMENT N.D.O.E.
 DATE 11-10-49
 GRANTOR Martin A. Brown, Sr.
 GRANTEE ST. of Vr.
 RECORDED WILMINGTON
 BOOK 33
 PAGE 295-296
 DATE 11-23-49
 REMARKS # 1 C ON SHEET 29

Wood Guide Post	LF	HT
1+45	1	1
3+31.5	1	1
4+00	3	3
4+20	4	
4+27	1	1

NOTE: STA 0+20-12+00
 All Row Slopes To Be Seeded
 Item 611

ESTIMATED QUANTITIES

Item	Quantity
Excavation	
Retaining Wall	
Channel Excavation	
Seeding	
Other	