


PLAN
 DATE 5-28
 DRAWN BY H. H. Houghton
 CHECKED BY

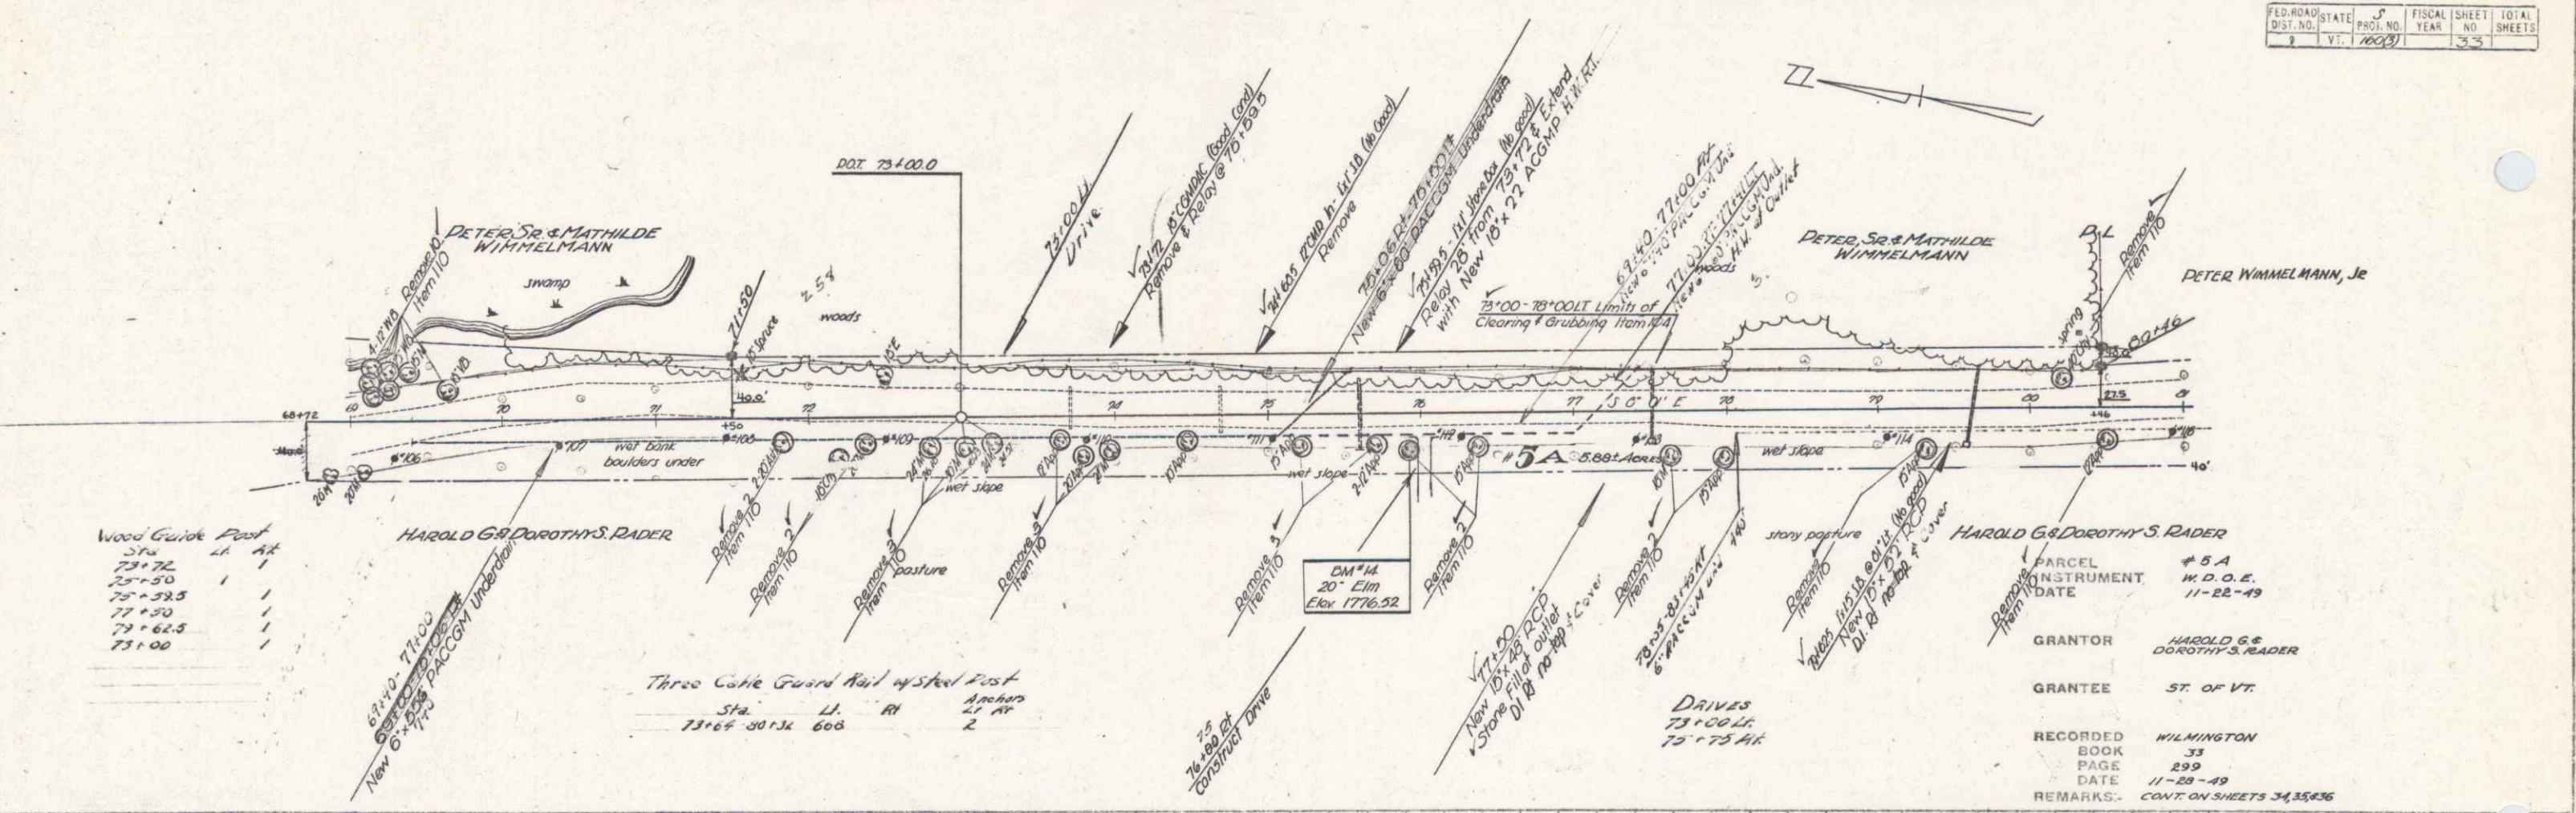

Wood Guide Post


Sta.	LA	AK
73+72		
74+50		
75+33.3		
77+50		
79+62.3		
79+00		

Three Cable Guard Rail w/ Steel Post

Sta.	LI	RI	Spacers
73+64	50+34	608	2

PARCEL # 5 A
 INSTRUMENT W. O. O. E.
 DATE 11-22-49
 GRANTOR HAROLD G. & DOROTHY S. RADER
 GRANTEE ST. OF VT.
 RECORDED WILMINGTON
 BOOK 33
 PAGE 299
 DATE 11-29-49
 REMARKS- CONT. ON SHEETS 34, 35 & 36

PROFILE
 DATE 5-28
 DRAWN BY H. H. Houghton
 CHECKED BY

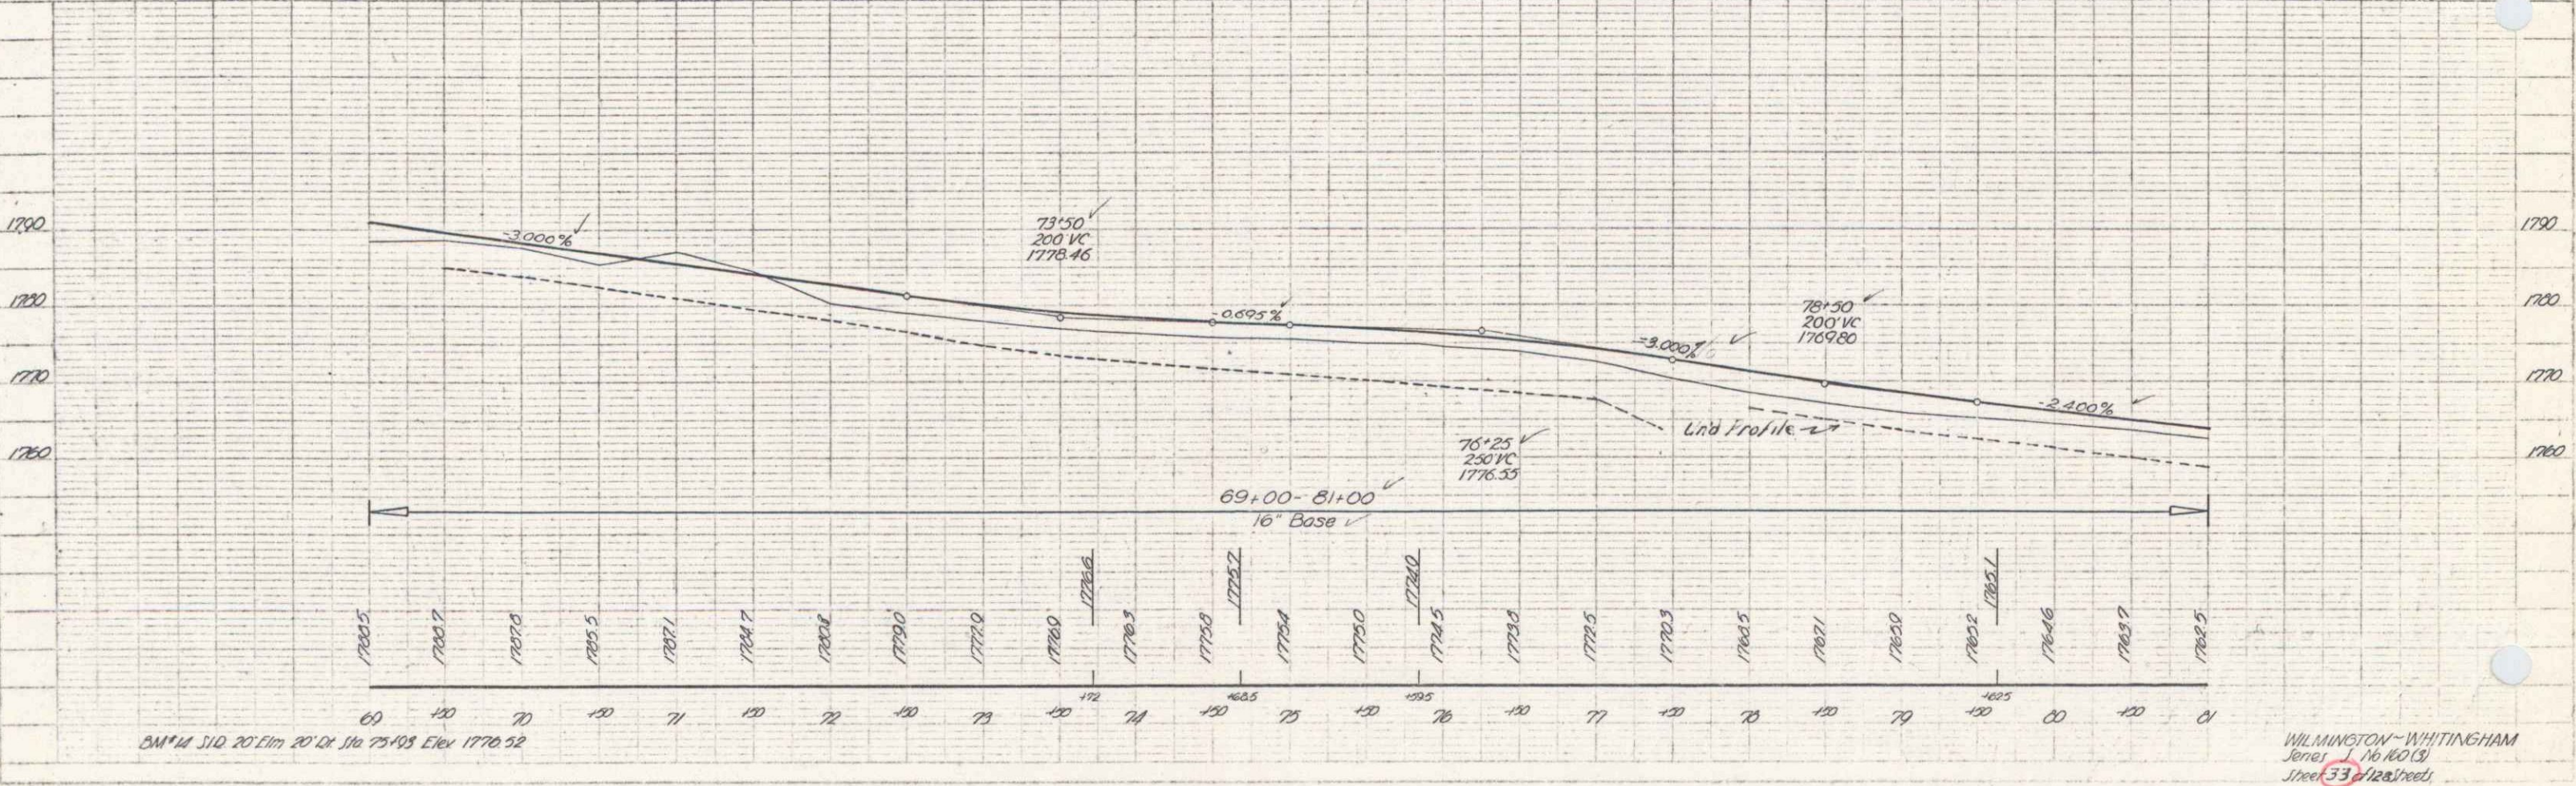

DM #14 20" Lim 20' Sta 75+05 Elev 1776.32

WILMINGTON-WHITINGHAM
 Series 16 R.O.S.
 Sheet 33 of 36 sheets