


PLAN
 DATE
 DRAWN BY
 CHECKED BY
 SCALE
 SHEET NO.
 TOTAL SHEETS

PLAN
 DATE
 DRAWN BY
 CHECKED BY
 SCALE
 SHEET NO.
 TOTAL SHEETS

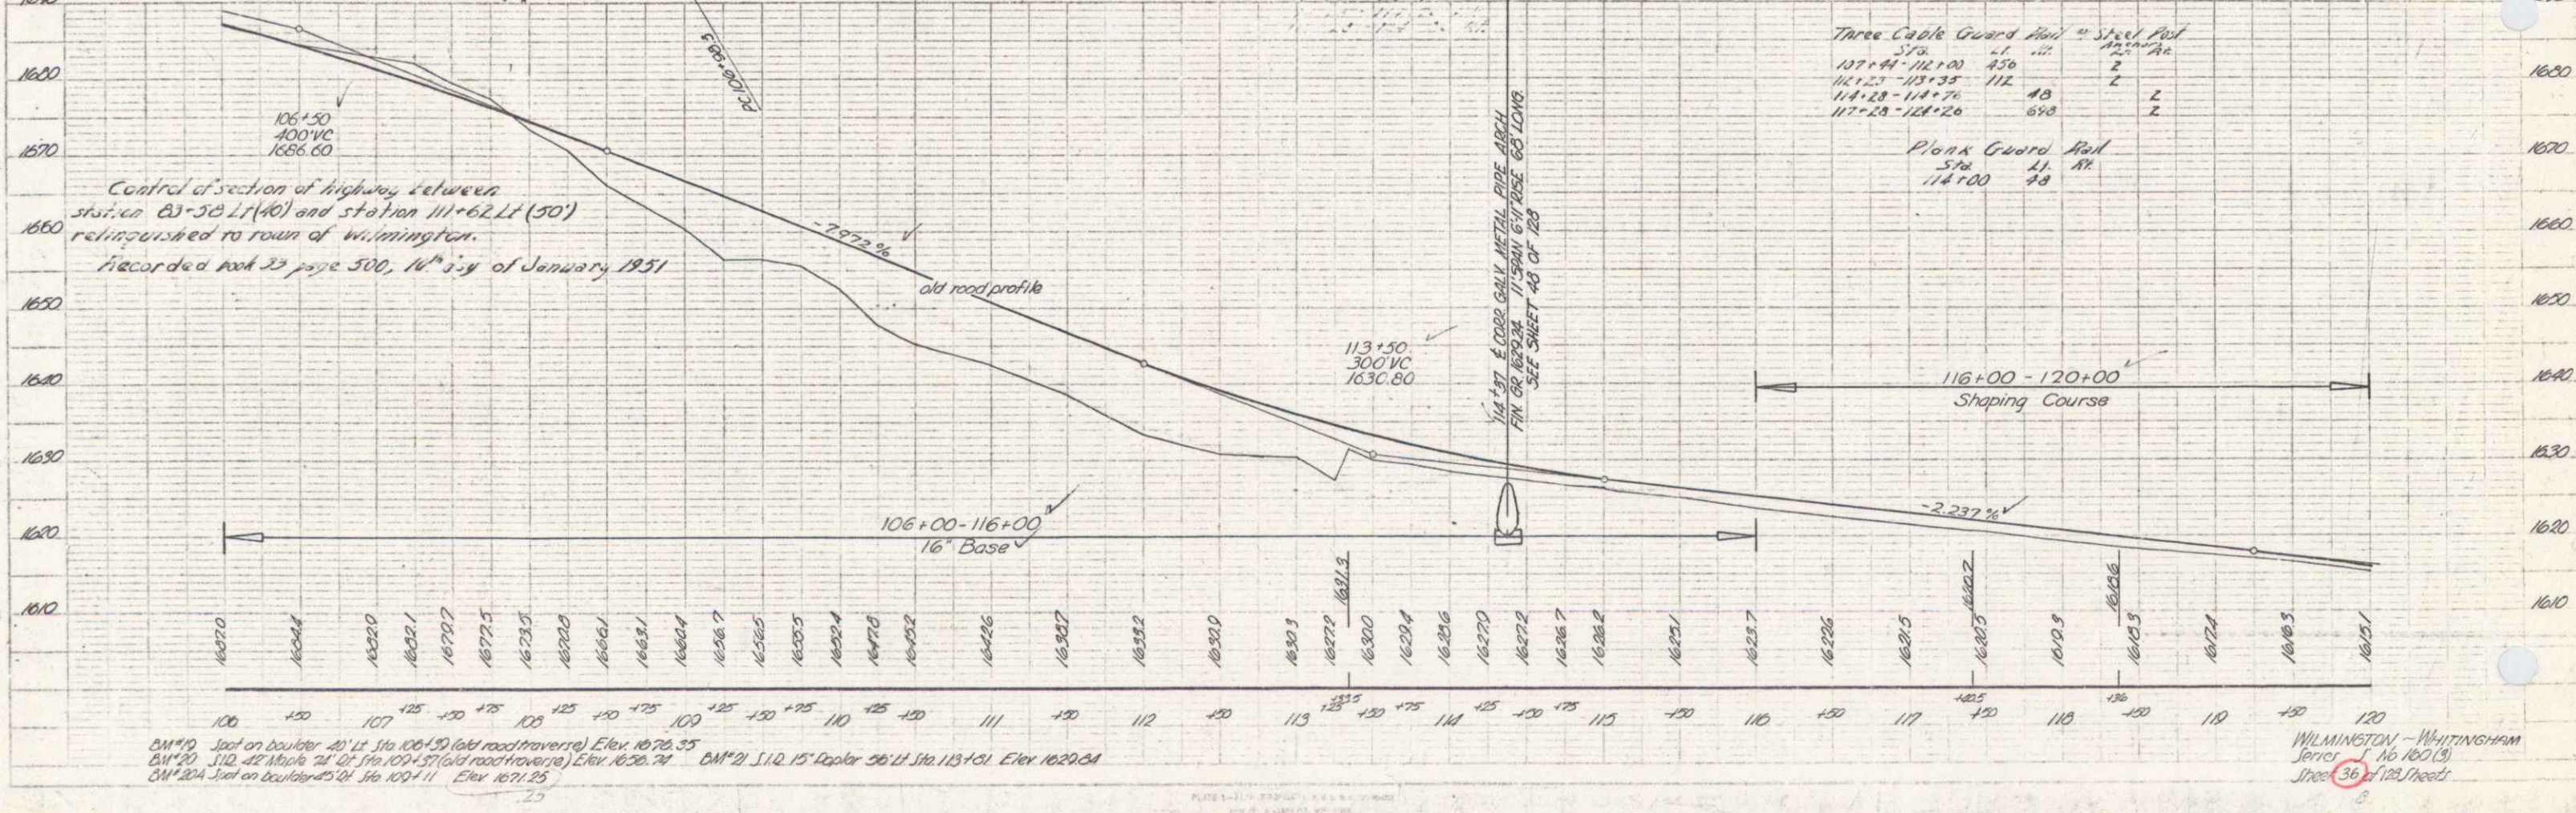

BM 19 Spot on boulder 40' W. Sta. 106+50 (old road traverse) Elev. 1676.35
 BM 20 S.W. 1/4 of Sec. 10, T. 10N, R. 10W Elev. 1656.74
 BM 21 S.W. 1/4 of Sec. 10, T. 10N, R. 10W Elev. 1629.84

PARCEL INSTRUMENT	#7 A&B
DATE	11-10-49
GRANTOR	LESLIE E. & GRACE GREEN
GRANTEE	ST OF VT
RECORDED BOOK	WILMINGTON 33
PAGE	289-290
DATE	11-16-49
REMARKS	

Three Code Guard Post	Steel Post
Sta. 107+94	112+00
112+23	113+33
114+28	114+76
117+24	118+20

Plank Guard Post	Steel Post
Sta. 114+00	114+00

woods	Sta.	Lt.	Ac.
	116+50	1	1
	118+36	1	1
	112+27	1	1
	114+74	1	1
	114+28	1	1
	117+70	1	1

PLANNING SHEET
 DIST. NO. 1003
 SHEET NO. 36