


PARCEL INSTRUMENT NO. 48-A
 DATE 11-9-49
 GRANTEE LESLIE E. & GRACE GREEN
 GRANTEE ST. OF VT.
 RECORDED WILMINGTON
 BOOK 33
 PAGE 297
 DATE 11-16-49
 REMARKS:

Station	Left	Right
120+00	1	1
121+00	1	1
122+00	1	1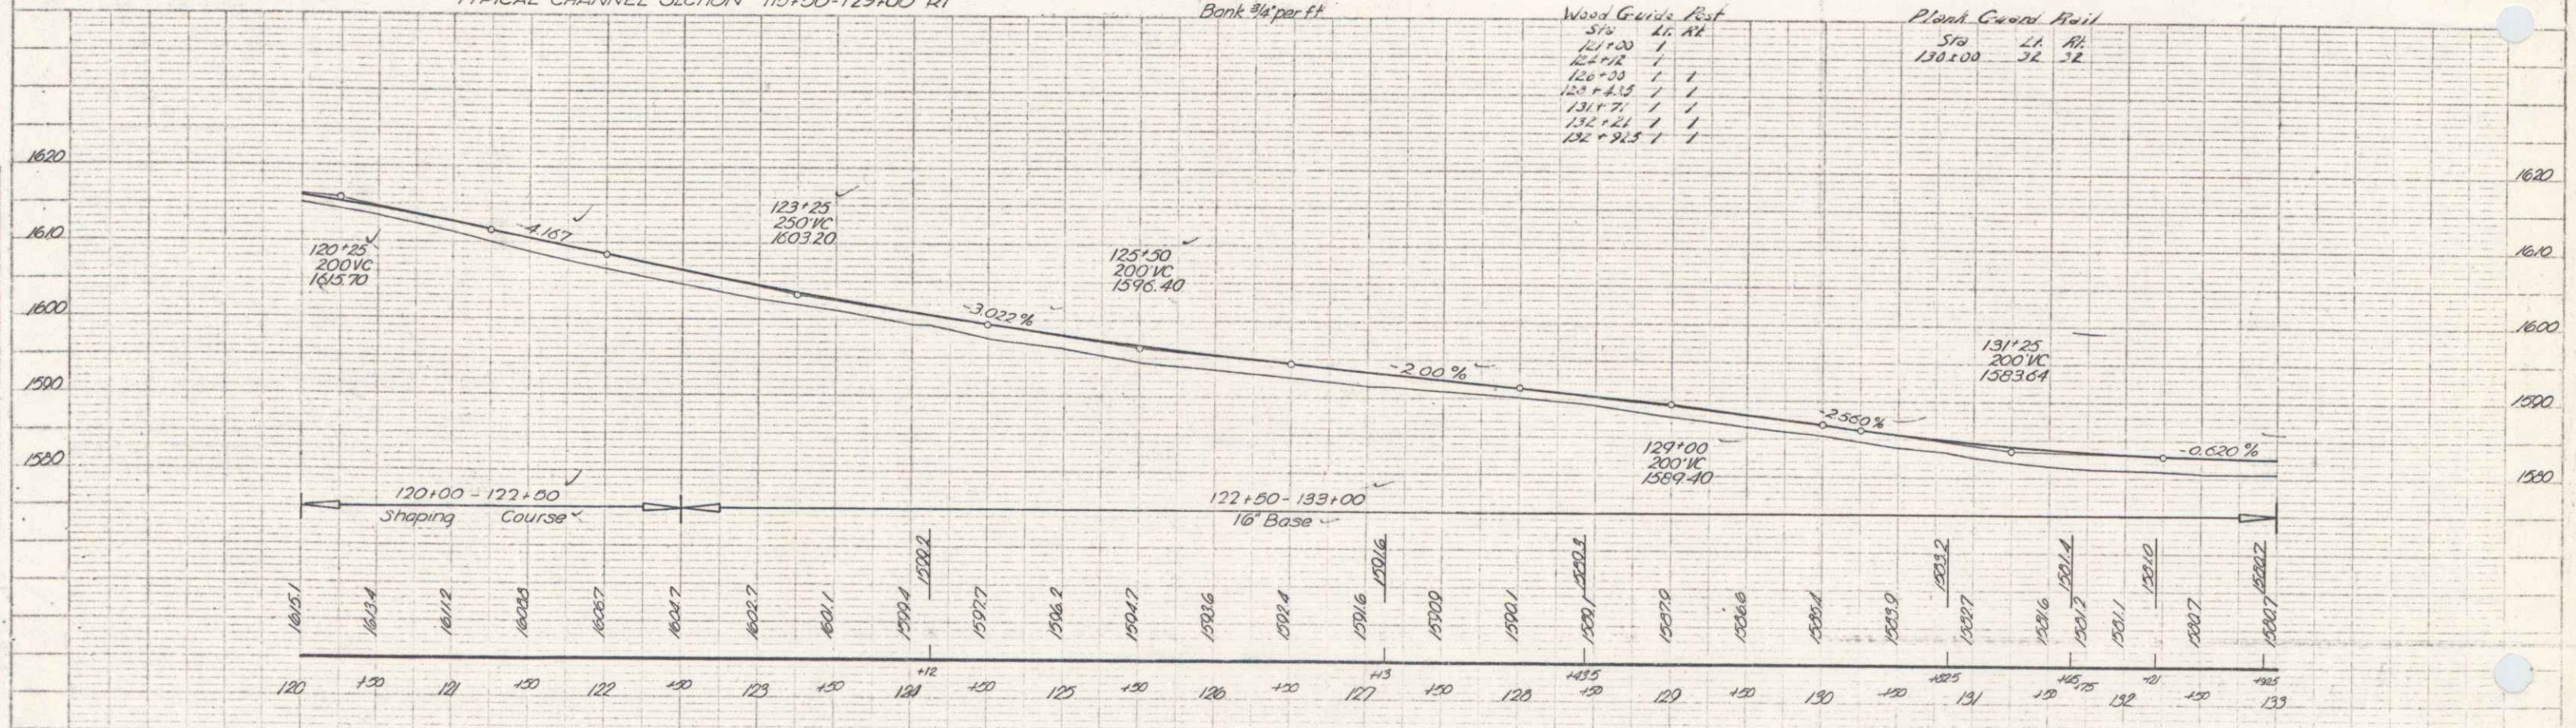
BM 22 5.10 12' Service 35' Pt. Sta. 122+45 Elev. 1602.52
 BM 23 110.5 12' SW Orange table in boulder 776.6 (1622) 53' Lt. Sta. 131+54 Elev. 1506.476

WILMINGTON-WHITTINGHAM
 June 1, 1949 (3)
 Street 37 1/2 West Street