

PARCEL INSTRUMENT DATE 11-29-49

GRANTOR ELAINE B. BROWN ORESTE A. & ELAINE B. BAKER EVRIL L. BONTEMPO

GRANTEE ST. OF VT. ST. OF VT. ELAINE BAKER & ELSIE BROWN

RECORDED BOOK PAGE DATE 12-6-49


REMARKS:

Wood Guard Post

514	Li	At
151+38	1	
153+52	1	
155+57.5	1	
157+54.5	1	
159+44.5	1	
161+33	1	

Three Curve Guard Post of Steel Post

Sta	Li	At	Angle
149+30	170	74	114
			114
			114

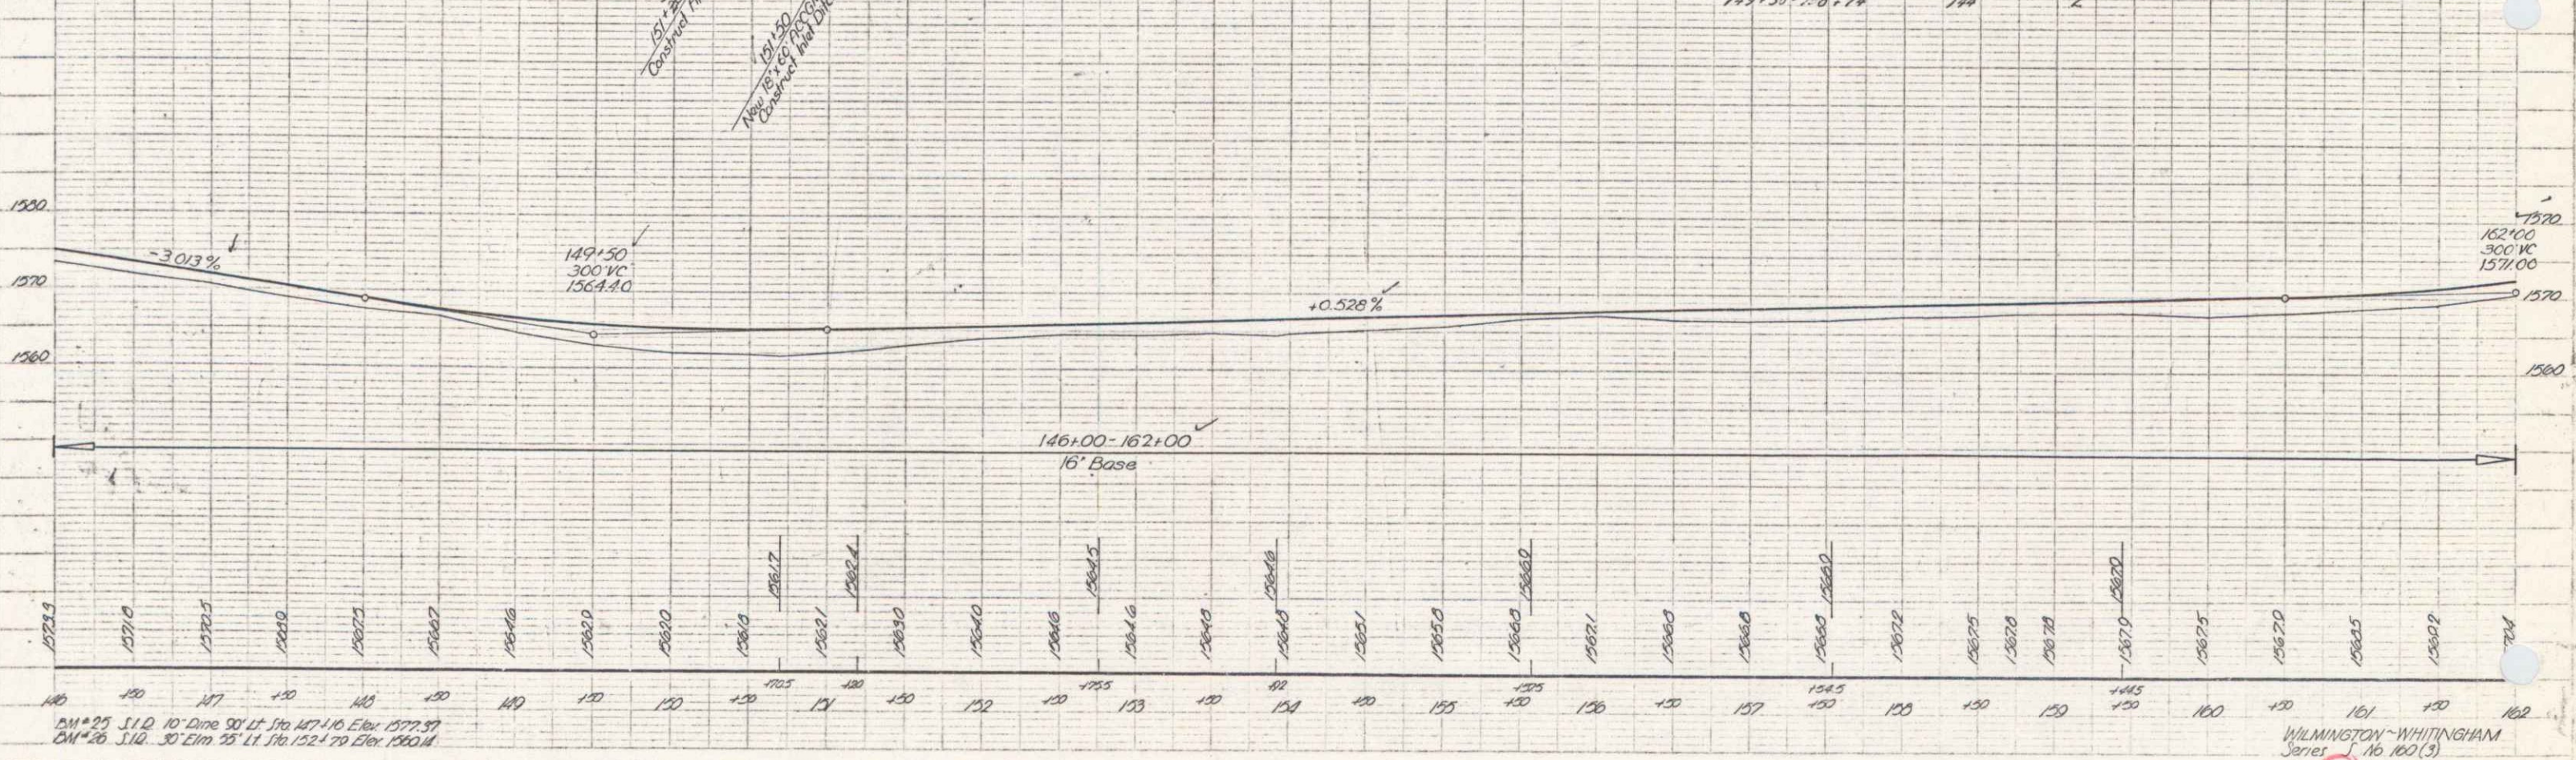

DM #25 S.I.D. 10' D.M.E. 30' L.T. 170' 140' ELEV. 1577.57

DM #26 S.I.D. 30' ELEV. 25' L.T. 170' 120' ELEV. 1560.14

WILMINGTON-WHITINGHAM Series 10, 100(5) Sheet 59 of 128 Sheets