


PARCEL INSTRUMENT DATE
GRANTOR
GRANTEE
RECORDED BOOK PAGE DATE
REMARKS

PLAN
DATE
BY
CHECKED
DATE

PLAN
DATE
BY
CHECKED
DATE

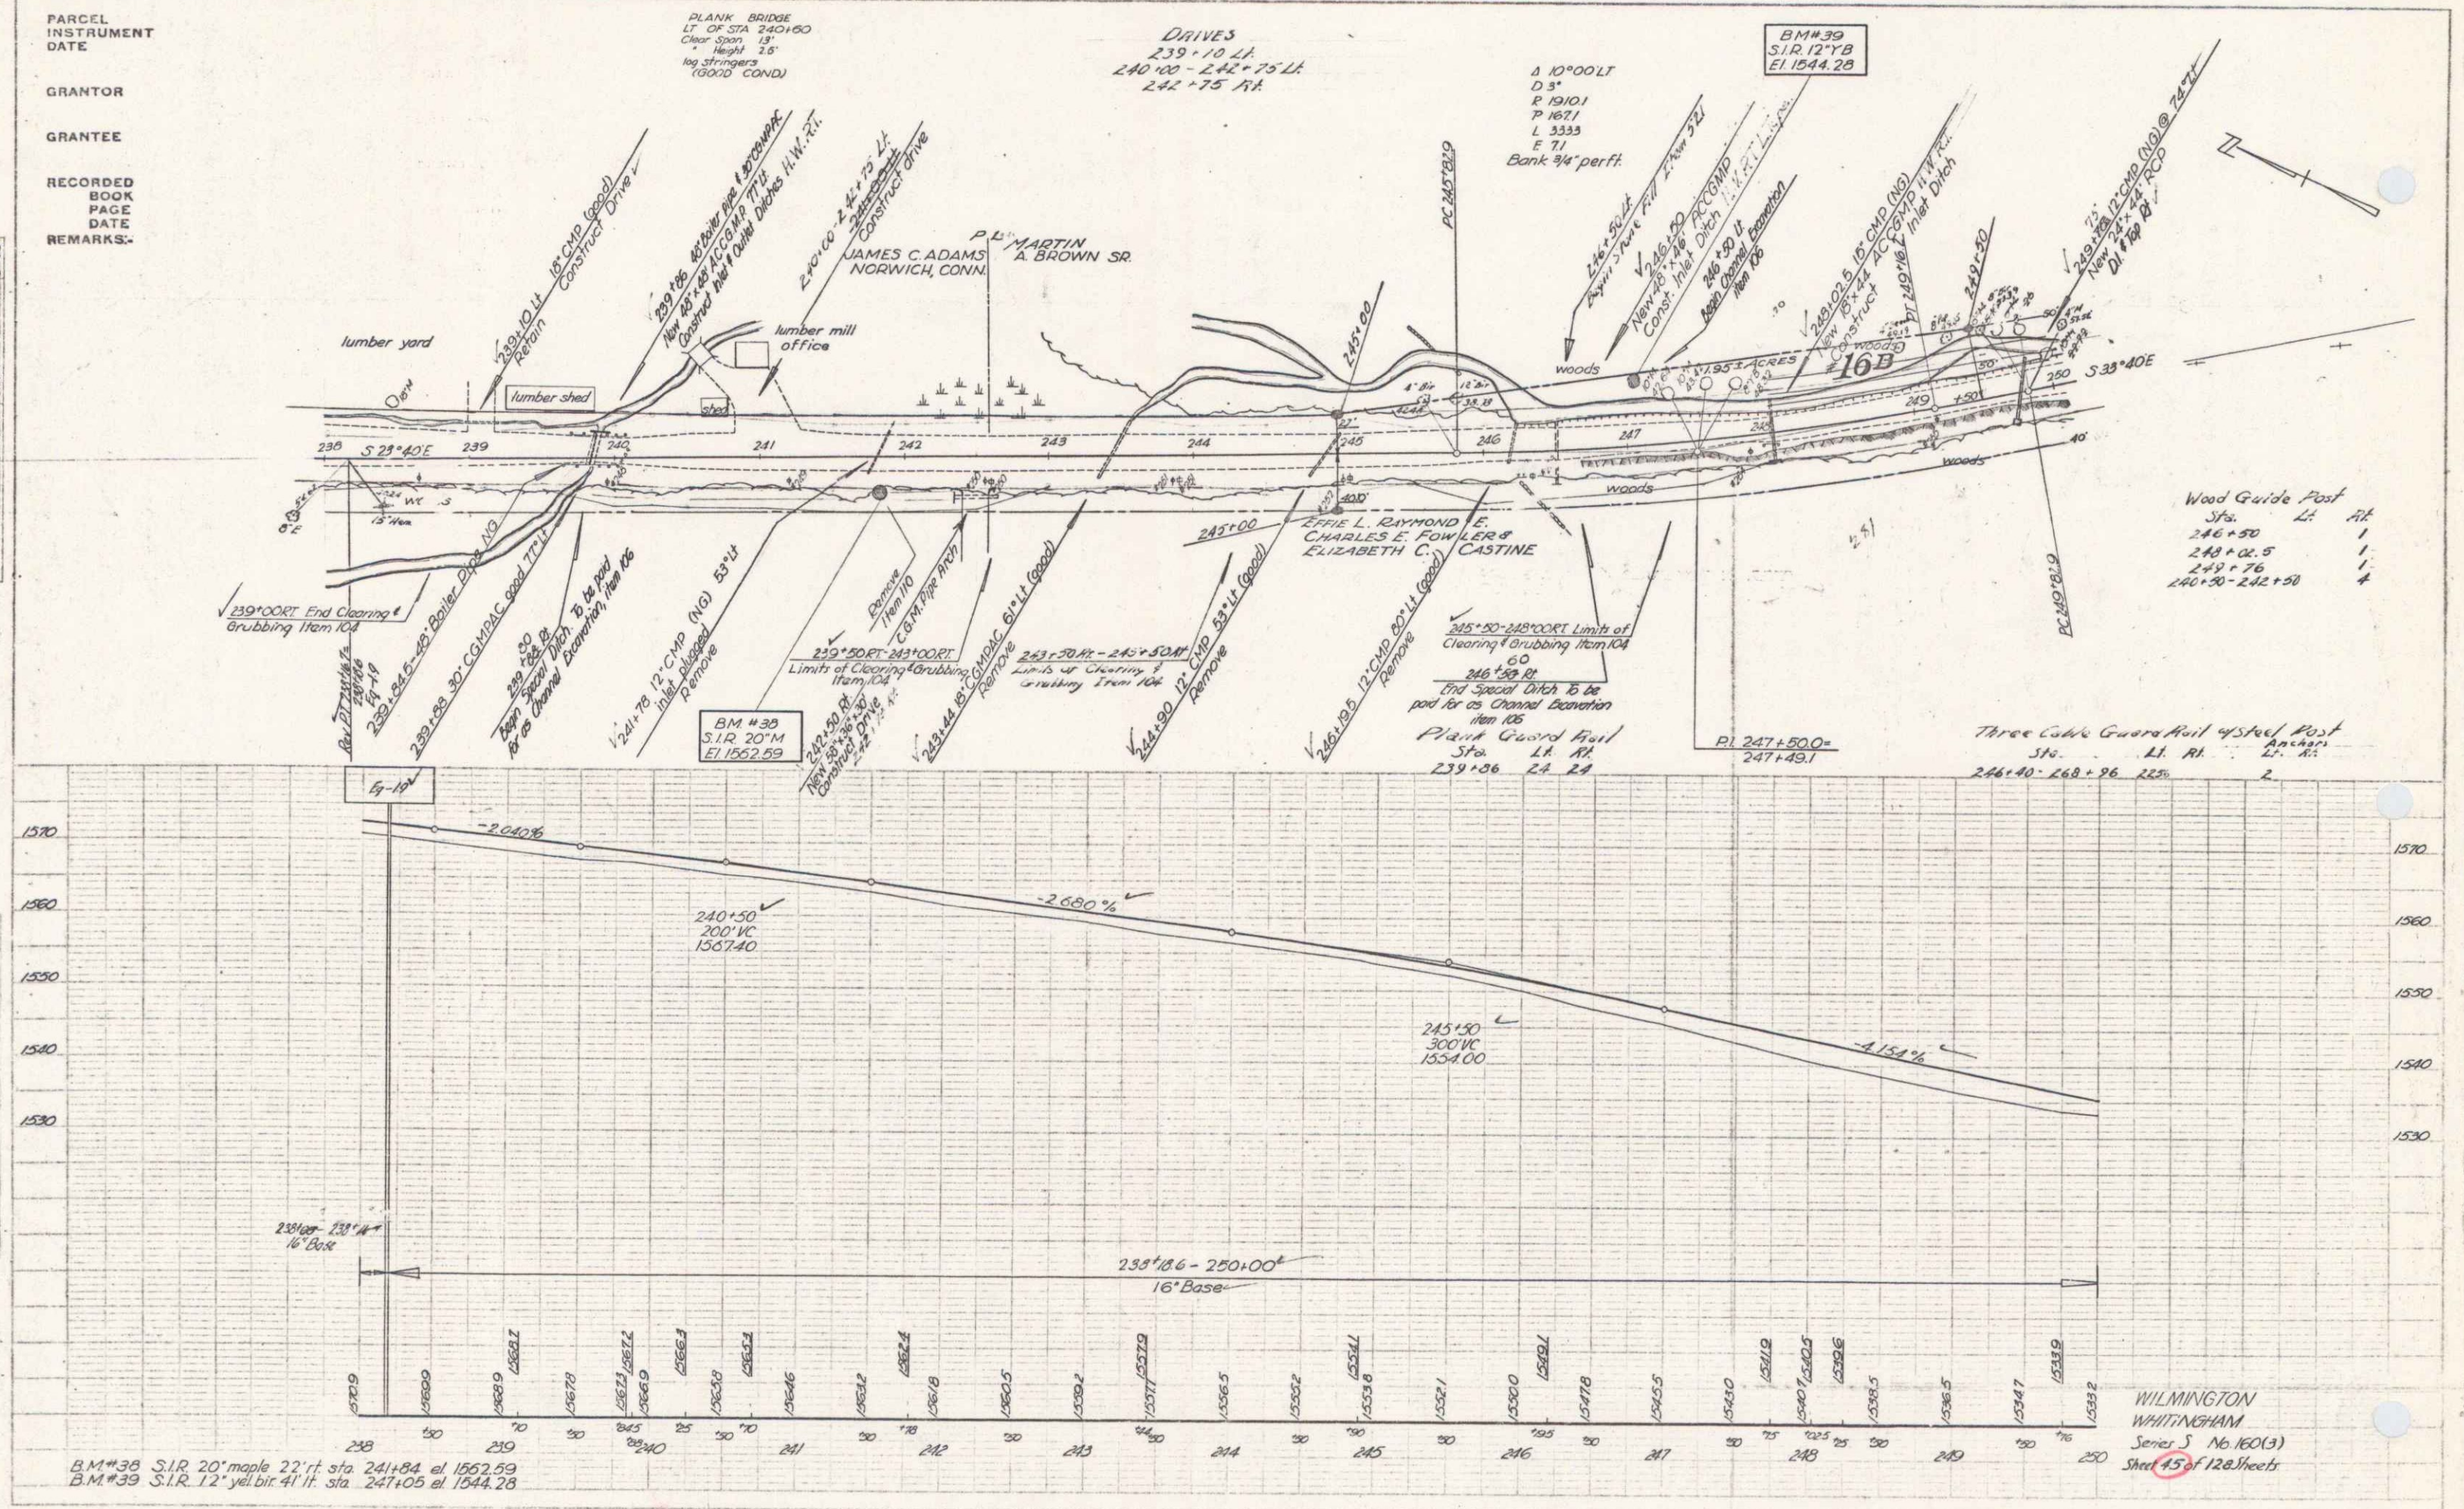

BM #30 S.I.R. 20' maple 22' ft sta 241+84 el 1562.59
BM #39 S.I.R. 12' yell bir 41' ft sta 247+05 el 1544.28

WILMINGTON
WHITTINGHAM
Series S No. 160(3)
Sheet 45 of 128 sheets

Wood Guide Post

Sta.	Lt.	Ht.
246+80	1	1
248+02.5	1	1
249+76	1	1
240+50-242+50	4	

Three Cable Guard Rail of Steel Post

Sta.	Lt.	Ht.
246+40	2	2