
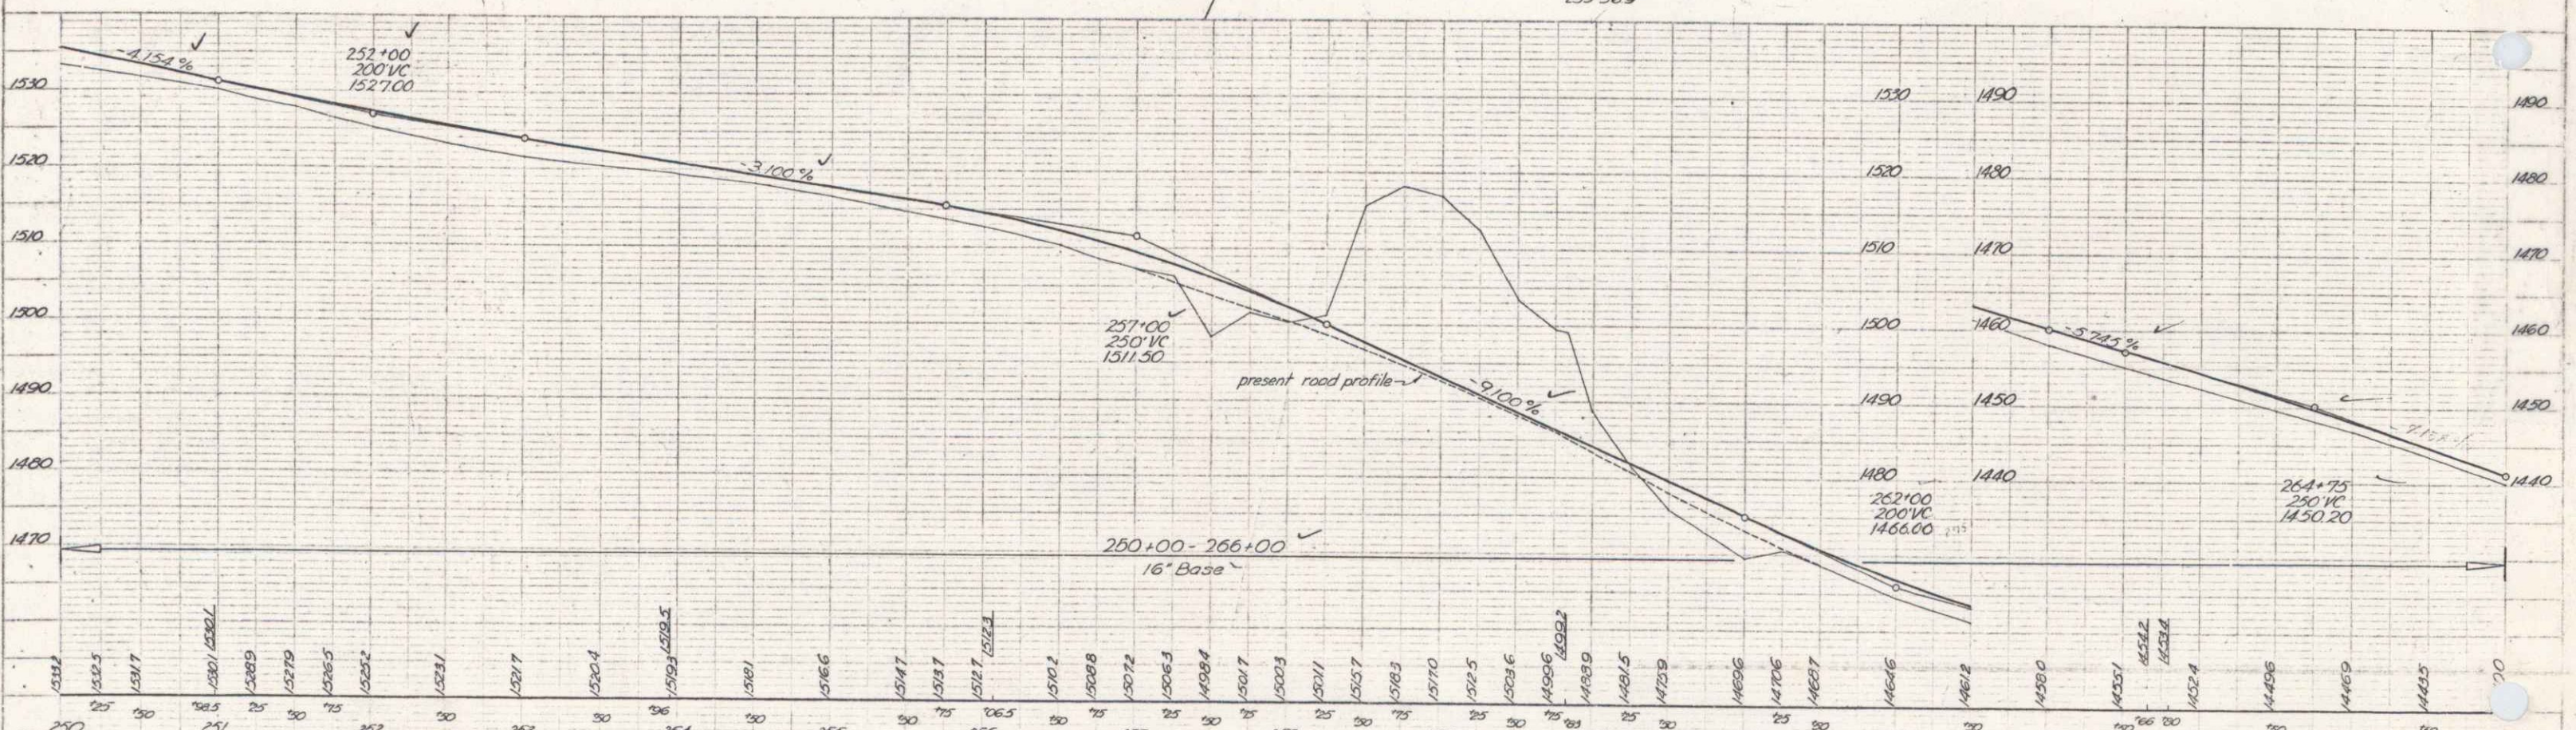


PLAN
 PROJECT: 13-48
 SHEET: 9-49
 JOC & M.S.J.
 DATE: 1-23-50

PROFILE
 PROJECT: 13-48
 SHEET: 9-49
 JOC & M.S.J.
 DATE: 1-23-50

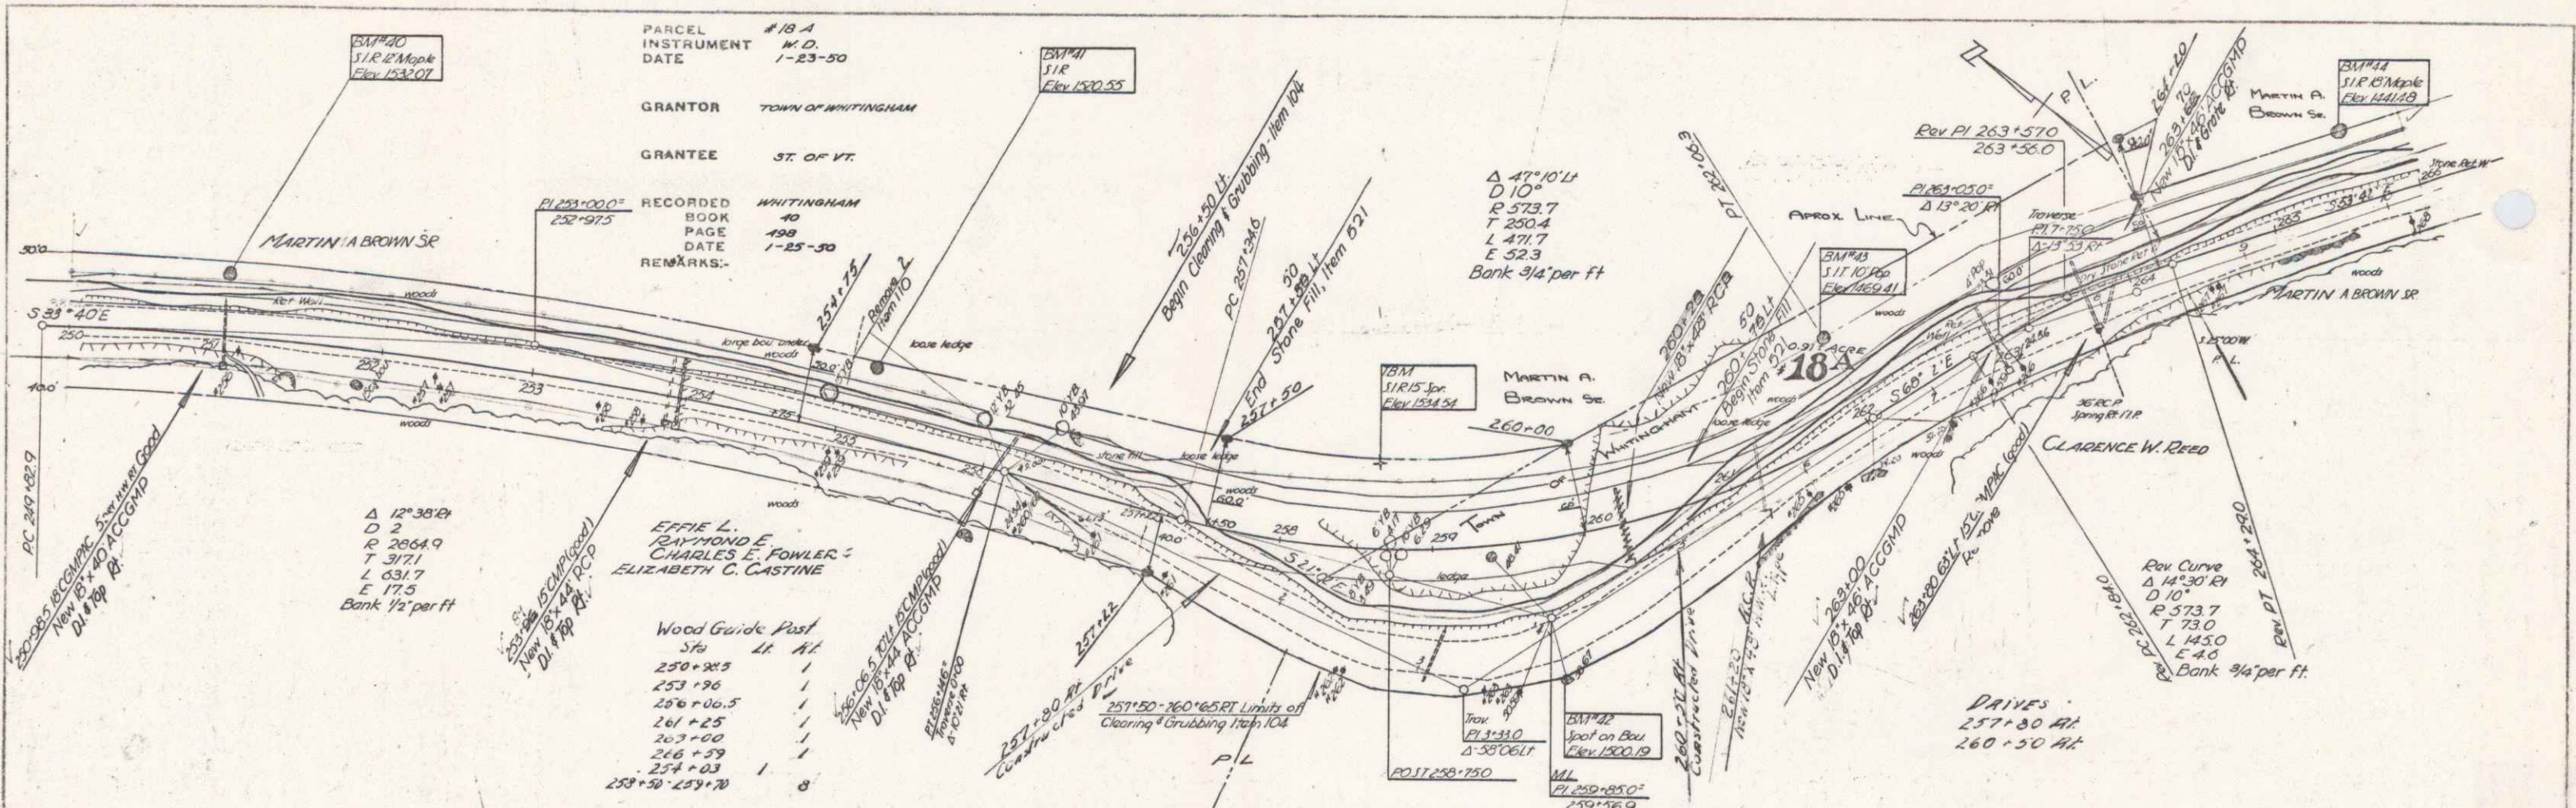

B.M. #40 S.I.R. 12" maple 36" ft sta 250+97 el. 1532.07
 B.M. #41 S.I.R. 15" yel bir. 42" ft sta. 255+16 el. 1520.55
 T.B.M. S.I.R. 15" spr. 57" ft sta. 258+60 el. 1534.54
 B.M. #42 Spot on boulder 251+sta. 3+94 (trav) 1500.19
 B.M. #43 S.I.T. 10" pop. 60" ft sta. 261+95 el. 1469.41
 B.M. #44 S.I.R. 15" maple 52" ft. sta. 265+53 el. 1441.40

WILMINGTON-WHITINGHAM
 No. 160 (3)
 Series 45 of 123 sheets