



POOR ORIGINAL COPY

PLAN	DATE	BY
SITE		
NO.		
REVISED		
APPROVED		
DATE		
BY		
NO.		

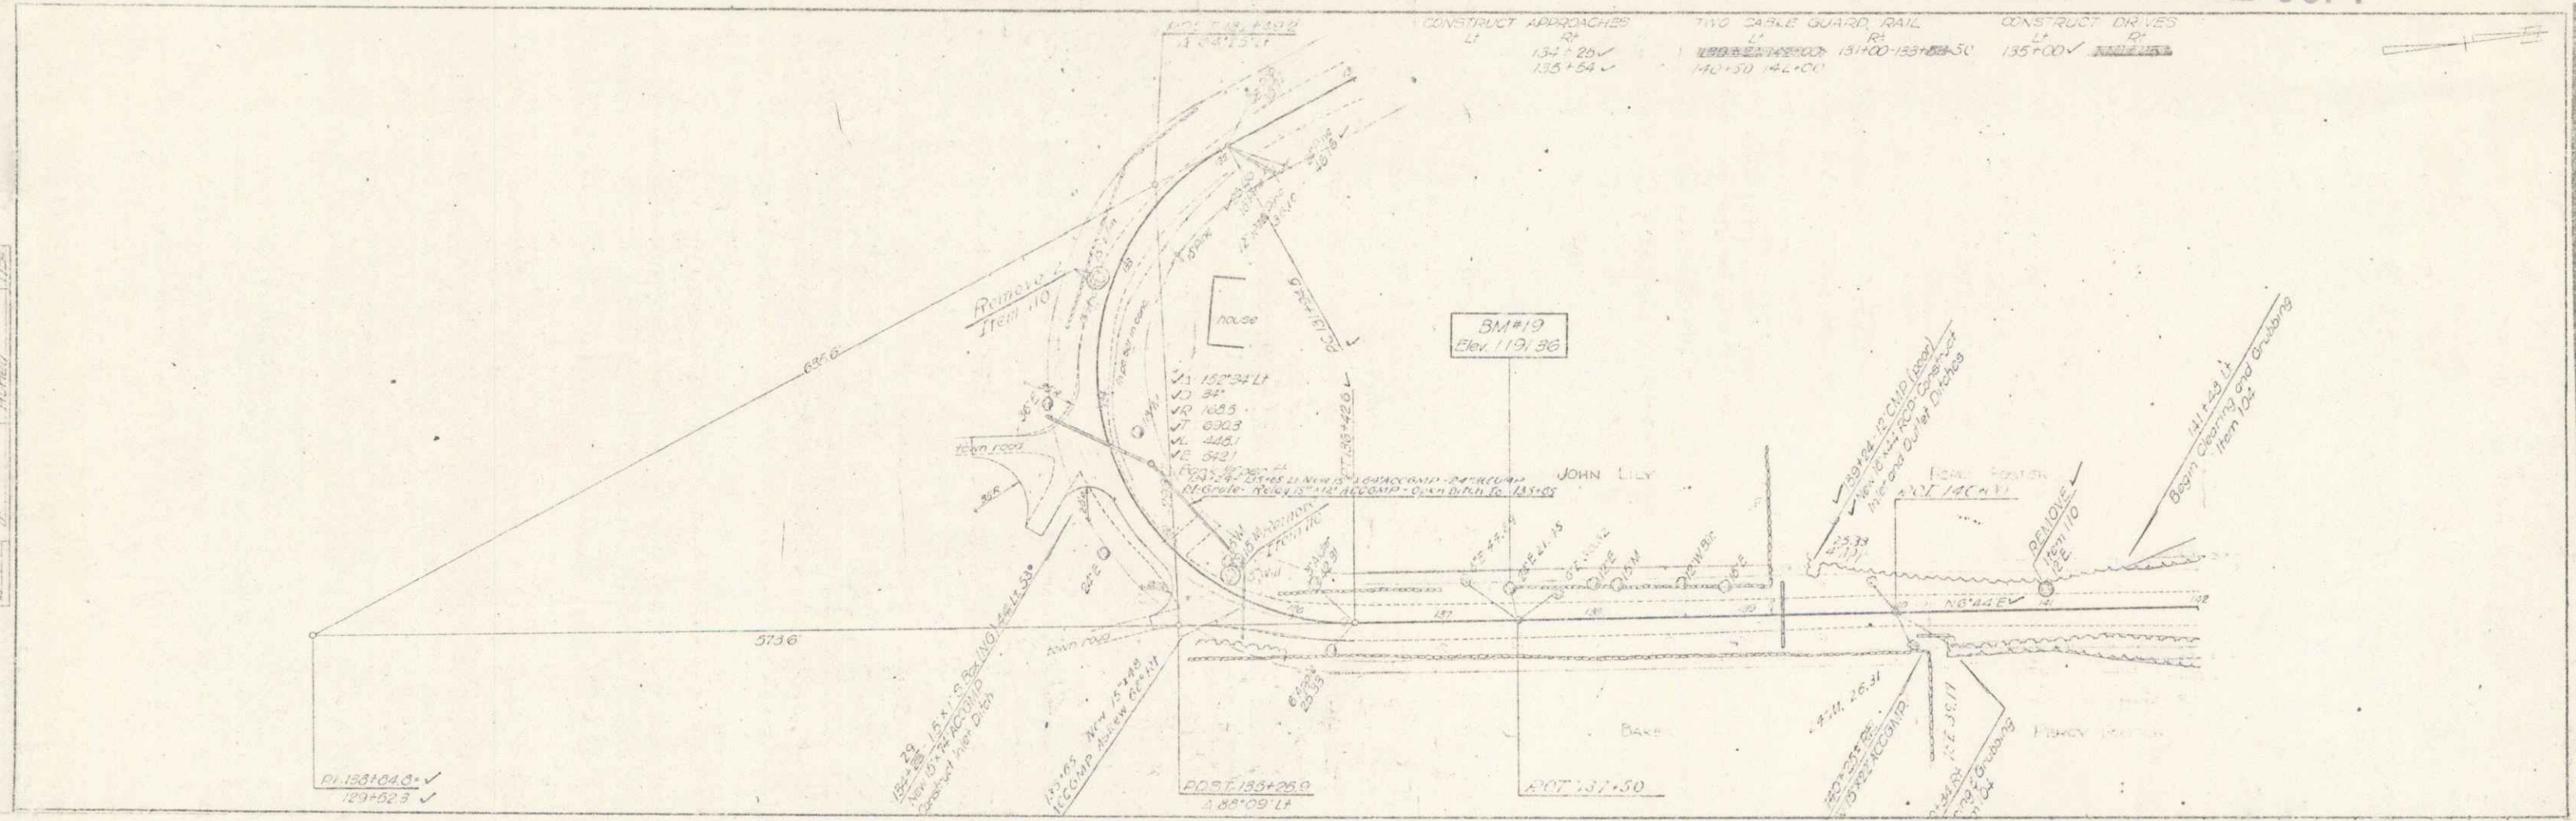

PLAN	DATE	BY
SITE		
NO.		
REVISED		
APPROVED		
DATE		
BY		
NO.		

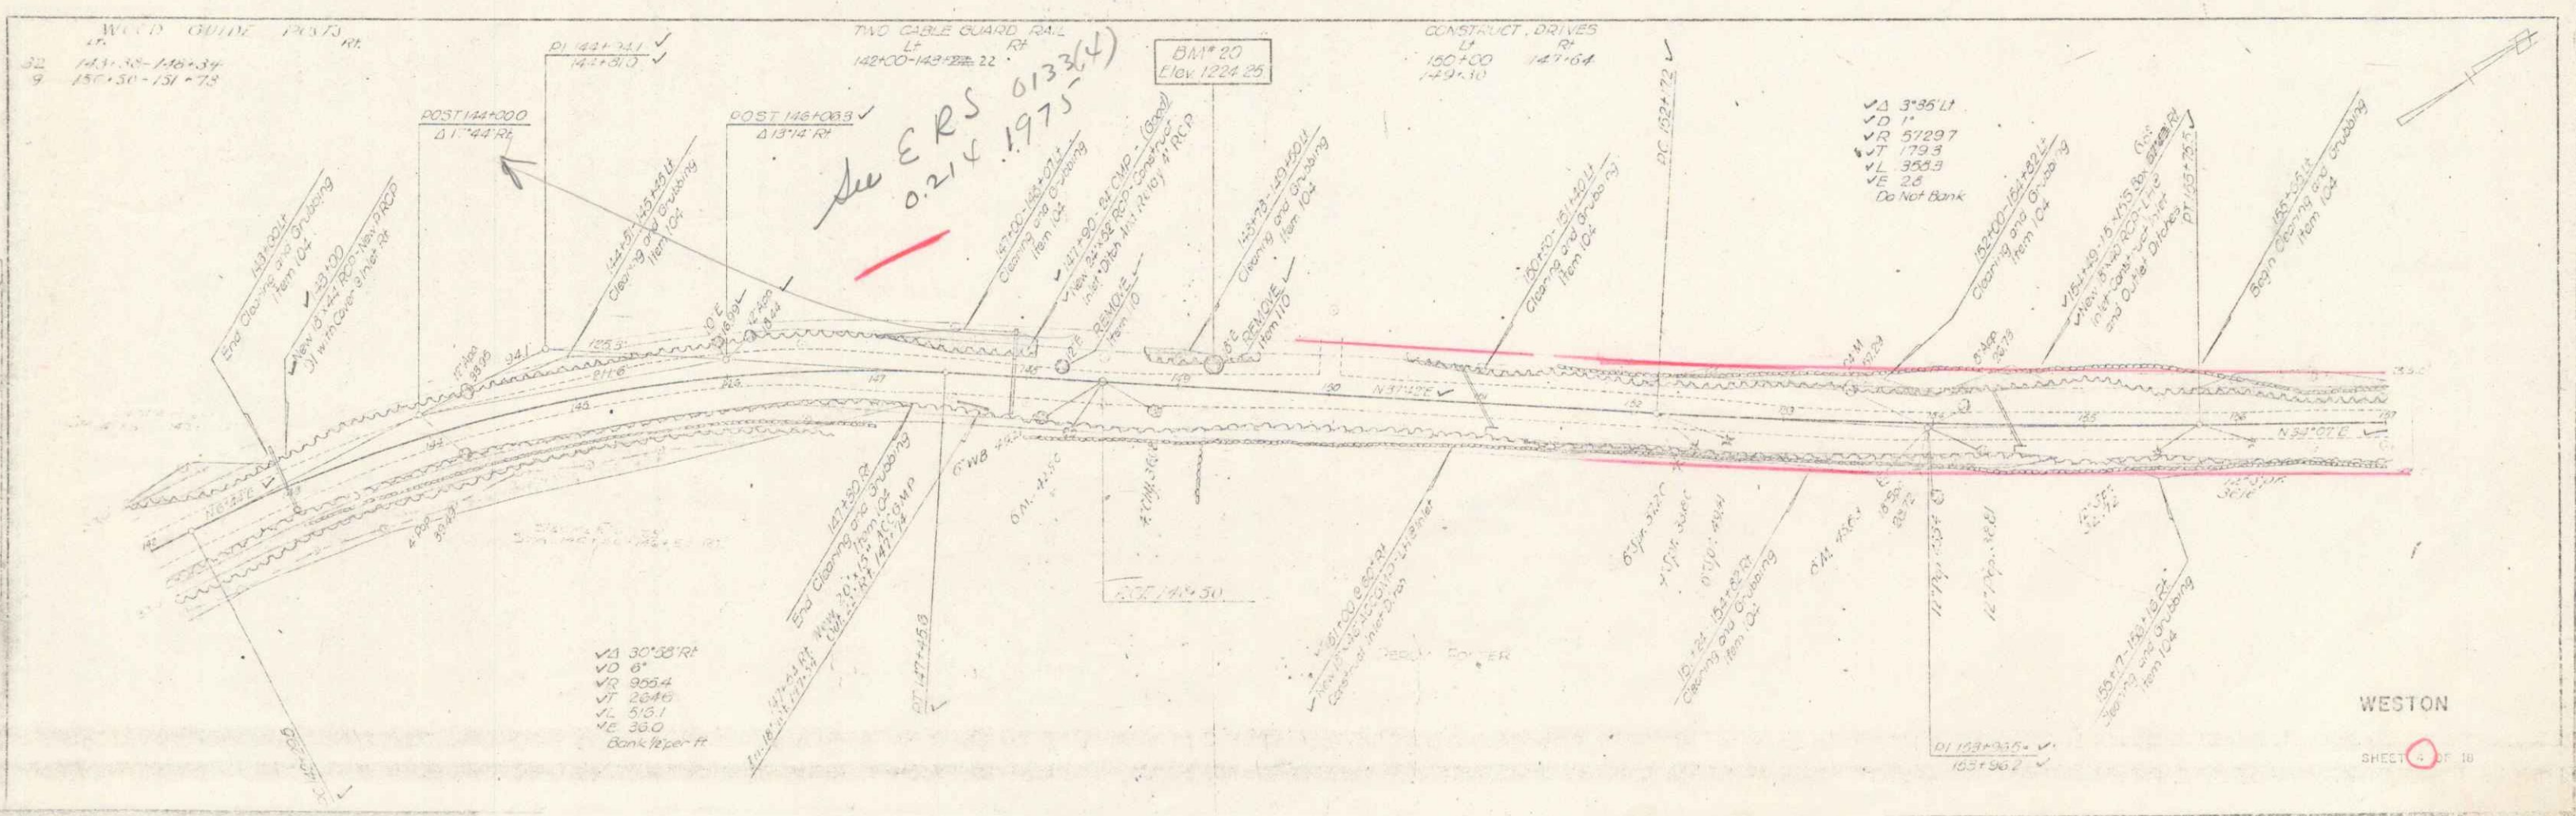

WESTON
SHEET 1 OF 10