


PLAN	DATE	BY
REVISED		
NOTE NO.		
DATE		
BY		

PROFILE	DATE	BY
REVISED		
NOTE NO.		
DATE		
BY		

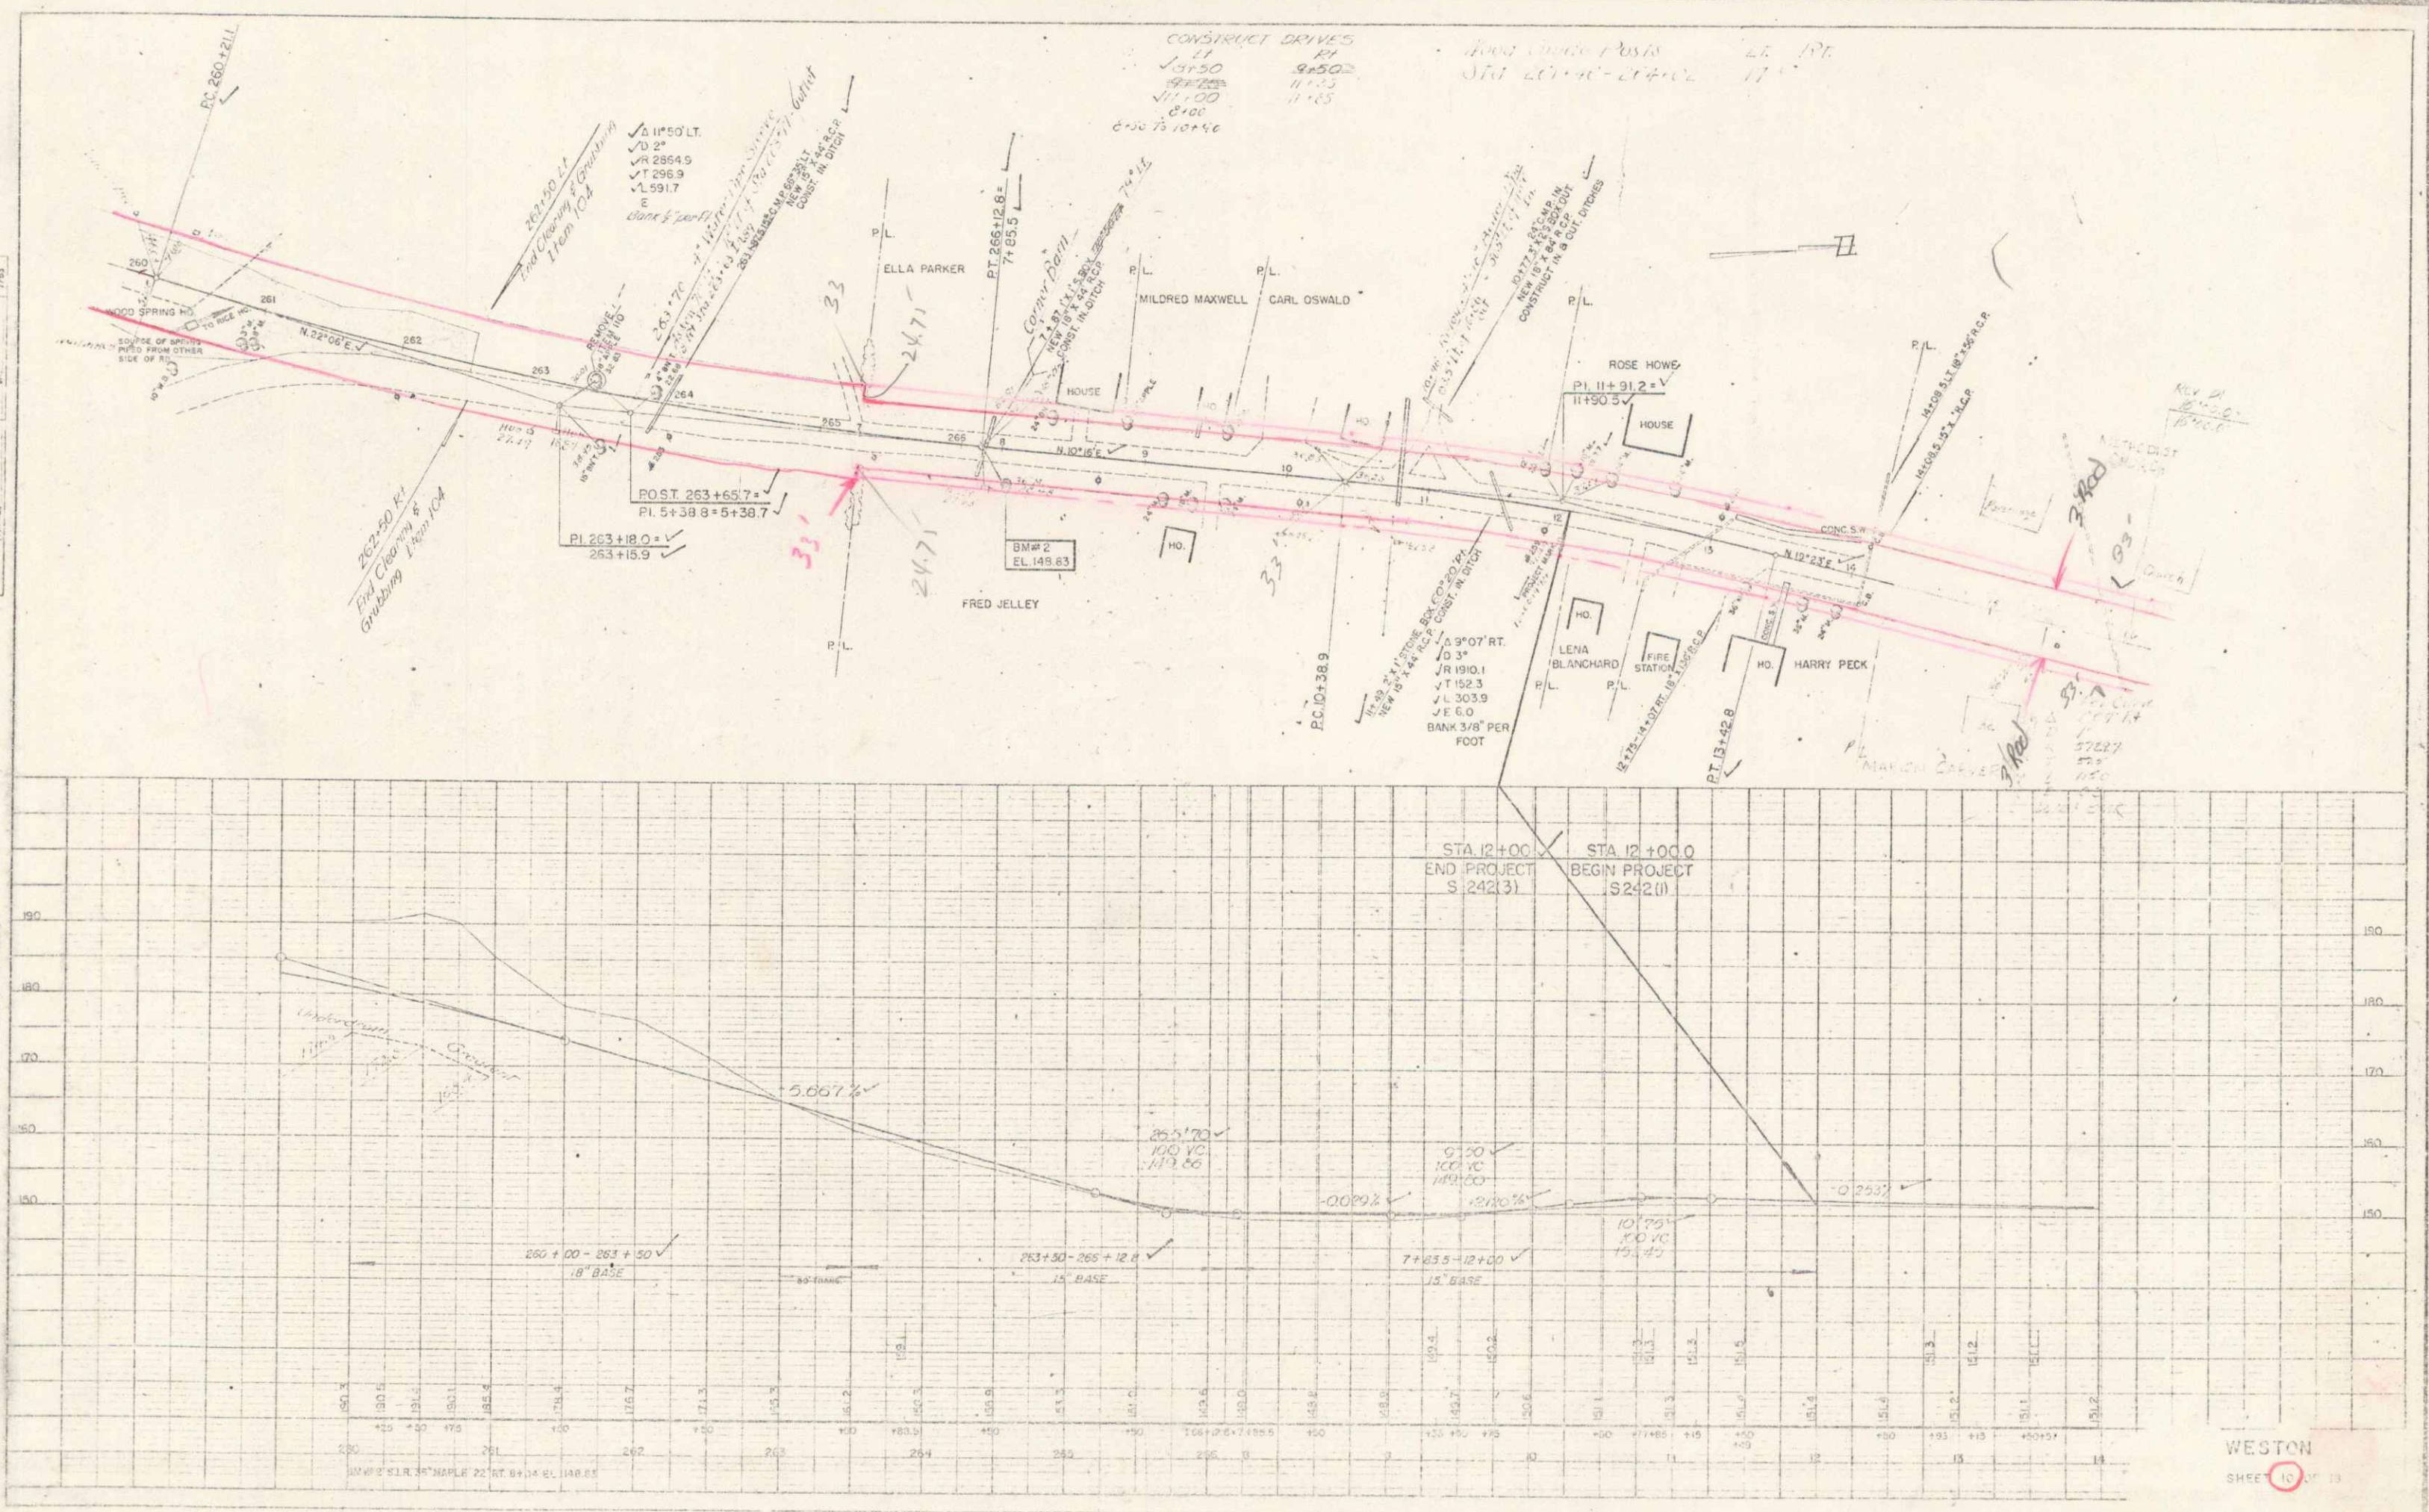

WESTON
SHEET 10 OF 13