


PLAN
 DATE 1908
 BY [unclear]
 CHECKED [unclear]



PLAN
 DATE 1908
 BY [unclear]
 CHECKED [unclear]

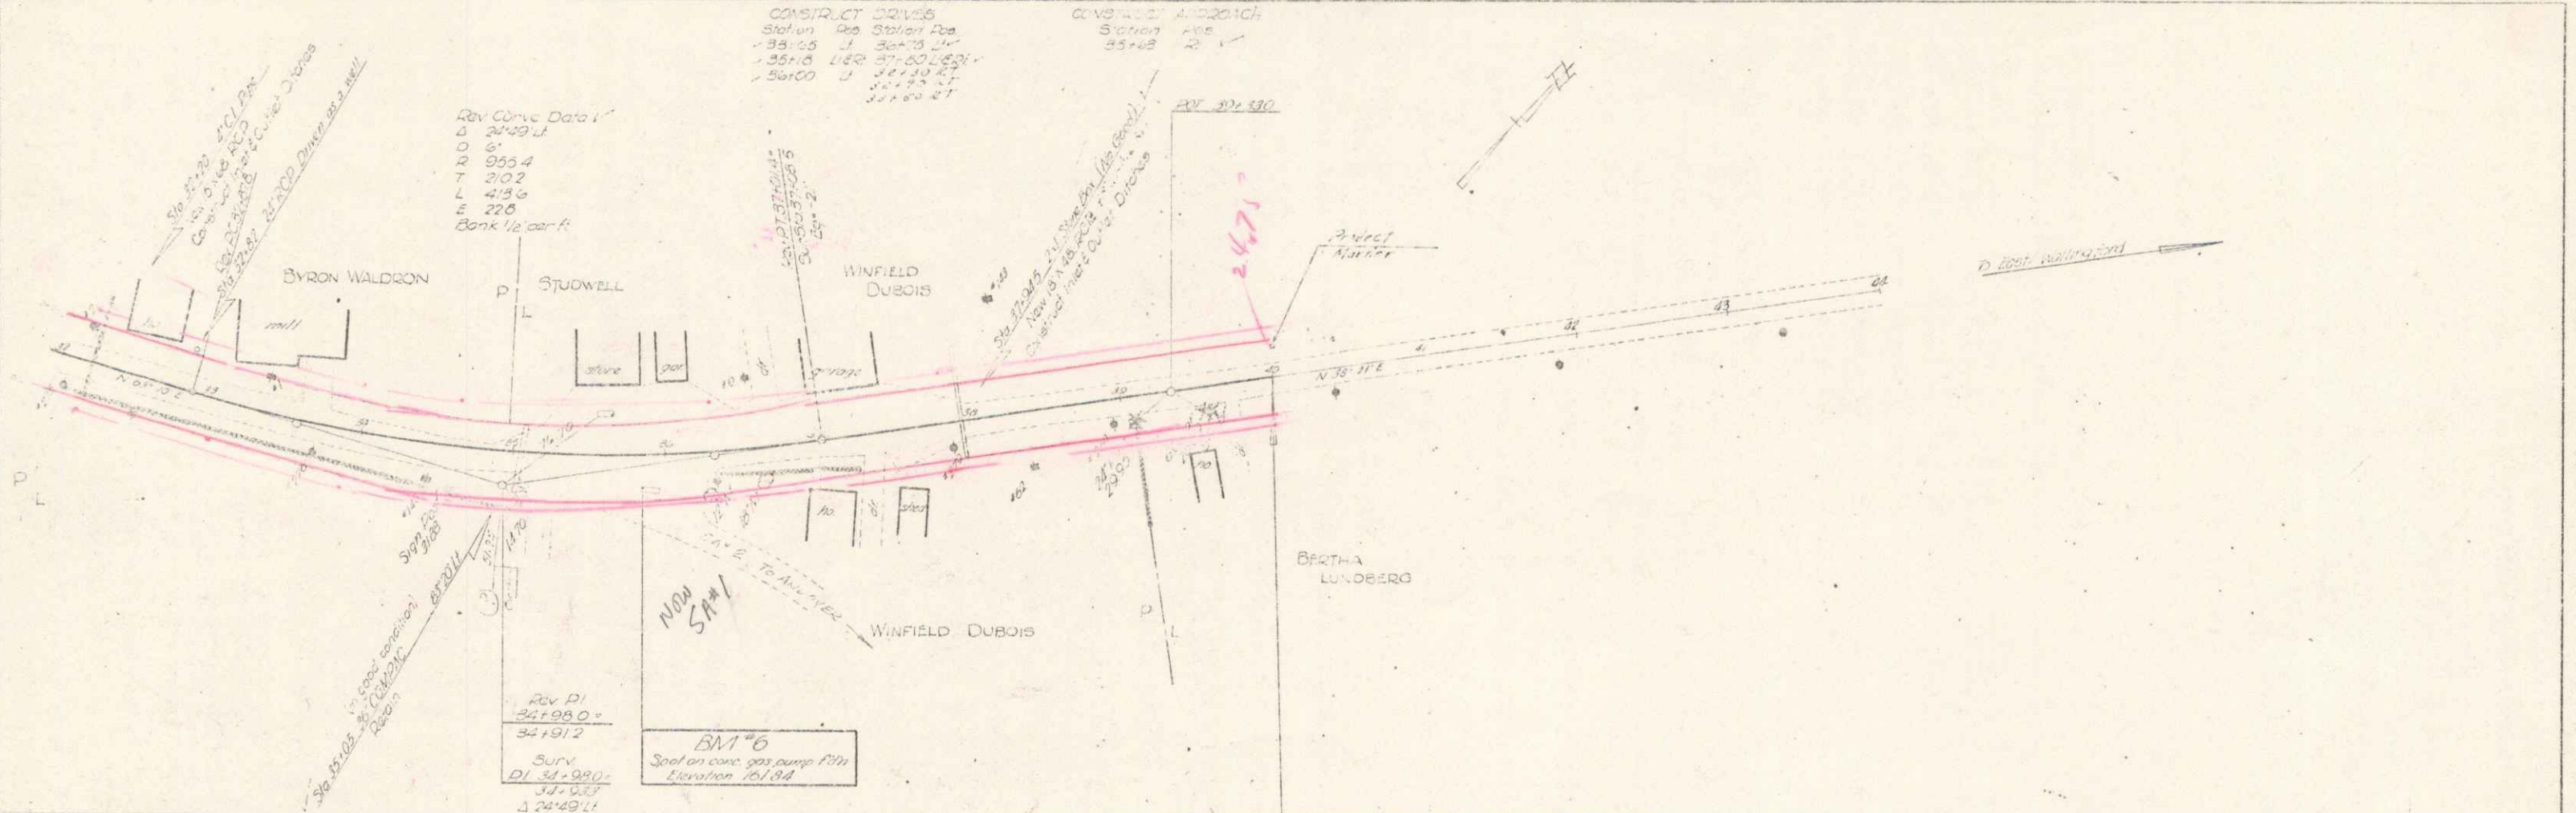