



Construct Drives  
 LI RT  
 105+50-105+50  
 107+25-107+25  
 111+55-113+25  
 108+58

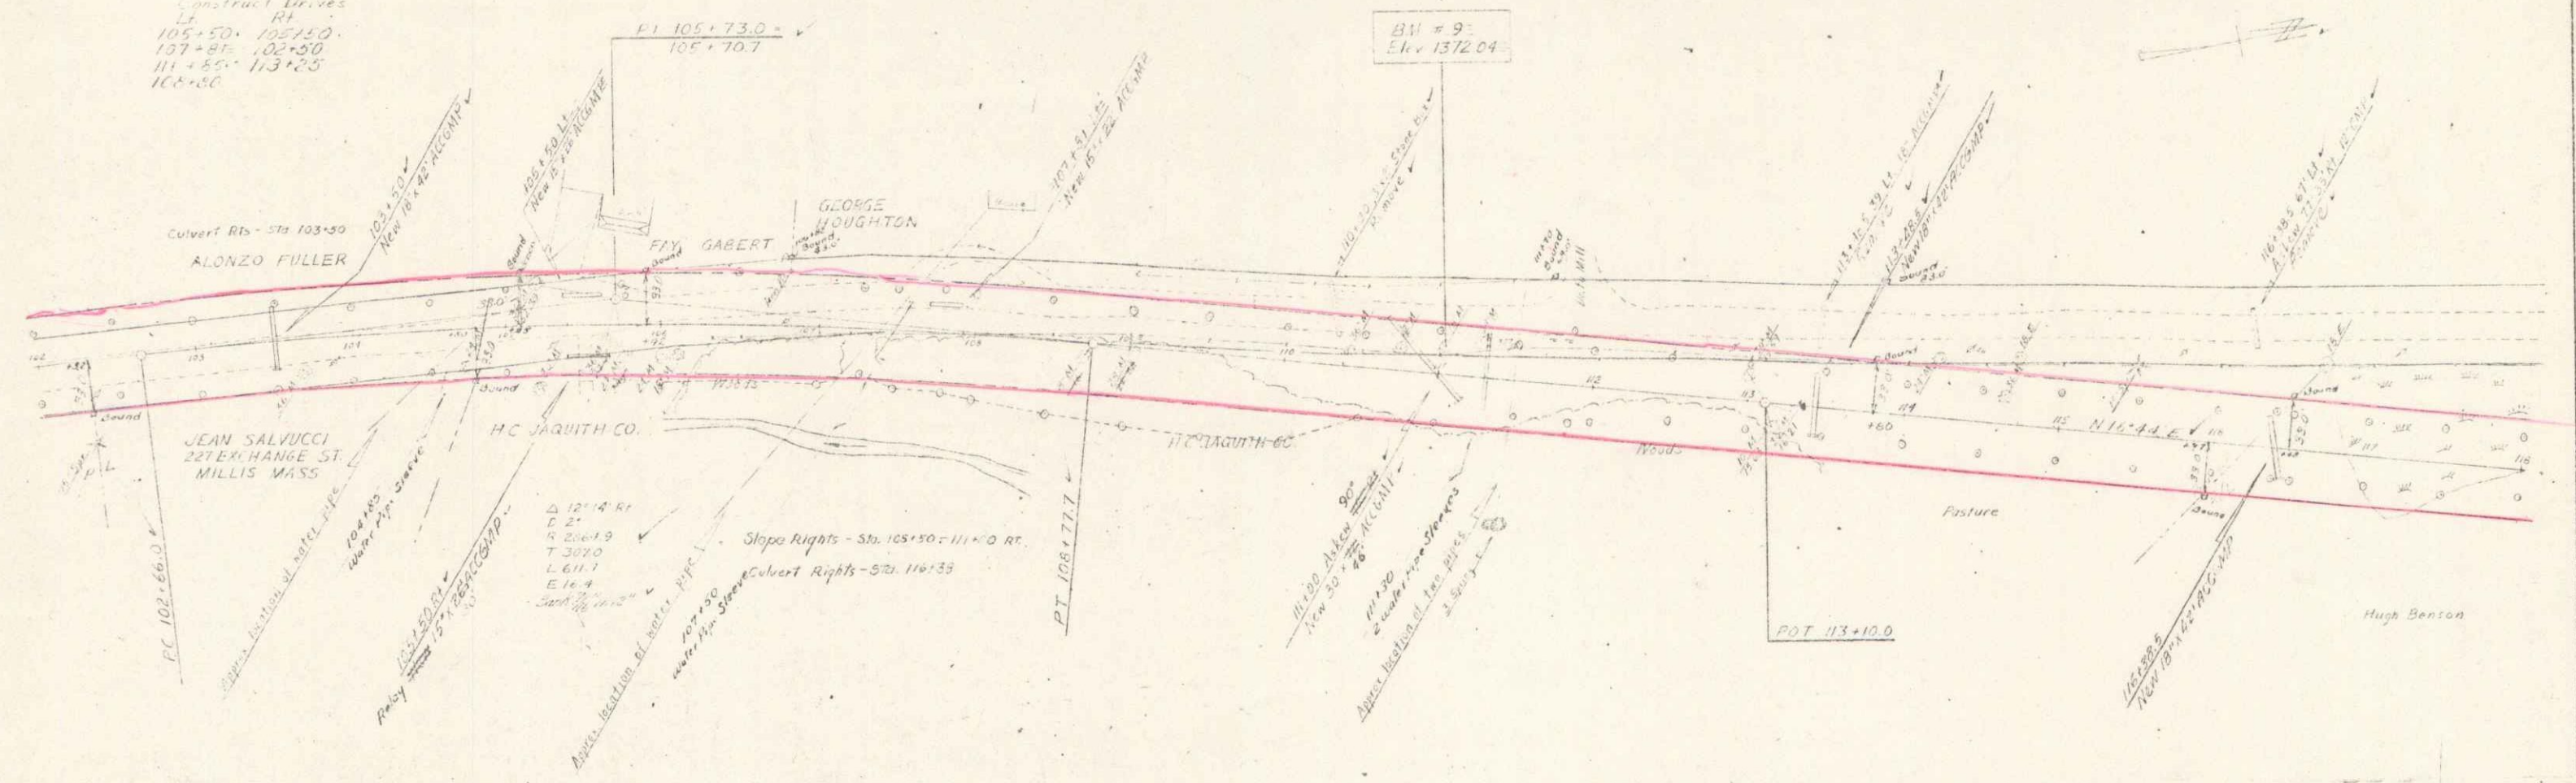

PLAN	105+50
SECTION	107+25
DETAIL	111+55
AS NOTED	
BY	
CHECKED	
DATE	
SCALE	

Construct Drives Wood Guide Posts @ 16' C/C  
 LI RT  
 113+00-113+00  
 118+25-118+25  
 125+33-125+33  
 126+00-126+00  
 127+15-127+15  
 130+00-130+00  
 131+25-131+25  
 132+40-132+40

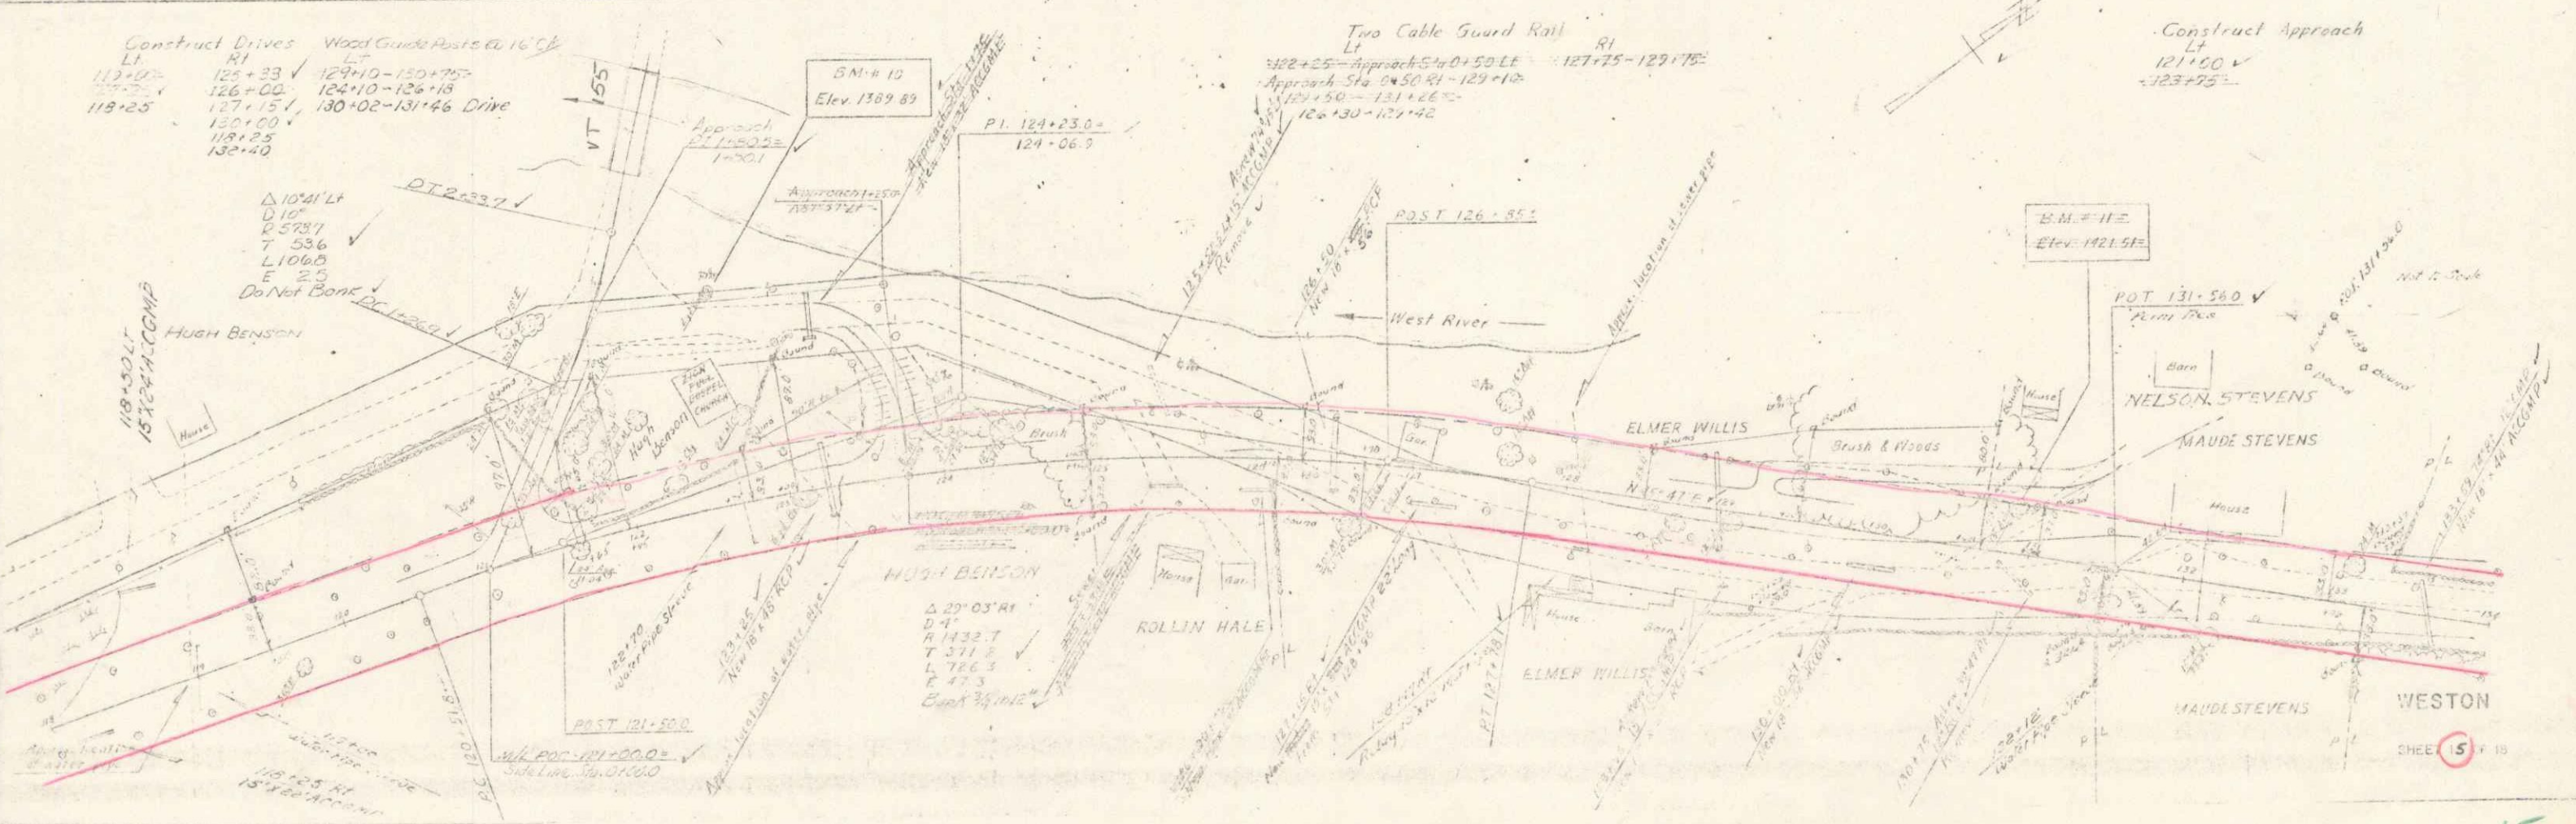

PLAN	113+00
SECTION	118+25
DETAIL	125+33
AS NOTED	
BY	
CHECKED	
DATE	
SCALE	

WESTON  
 SHEET 5 of 19