


Drilling and Blasting of Solid Rock Subgrade
 LI RT
 135+50 - 136+50
 133+00 - 136+99

Two Cable Guard Rail
 RT
 137+75 - 139+75
 137+75 - 139+75
 141+25 - 142+25

Construct Drive
 LI RT
 145+71 - 147+10
 135+70


Wood Guide Posts @ 16' 9"
 LI RT
 138+50 - Approach Sta. 0+90.00

Construct Approach
 RT
 143+651

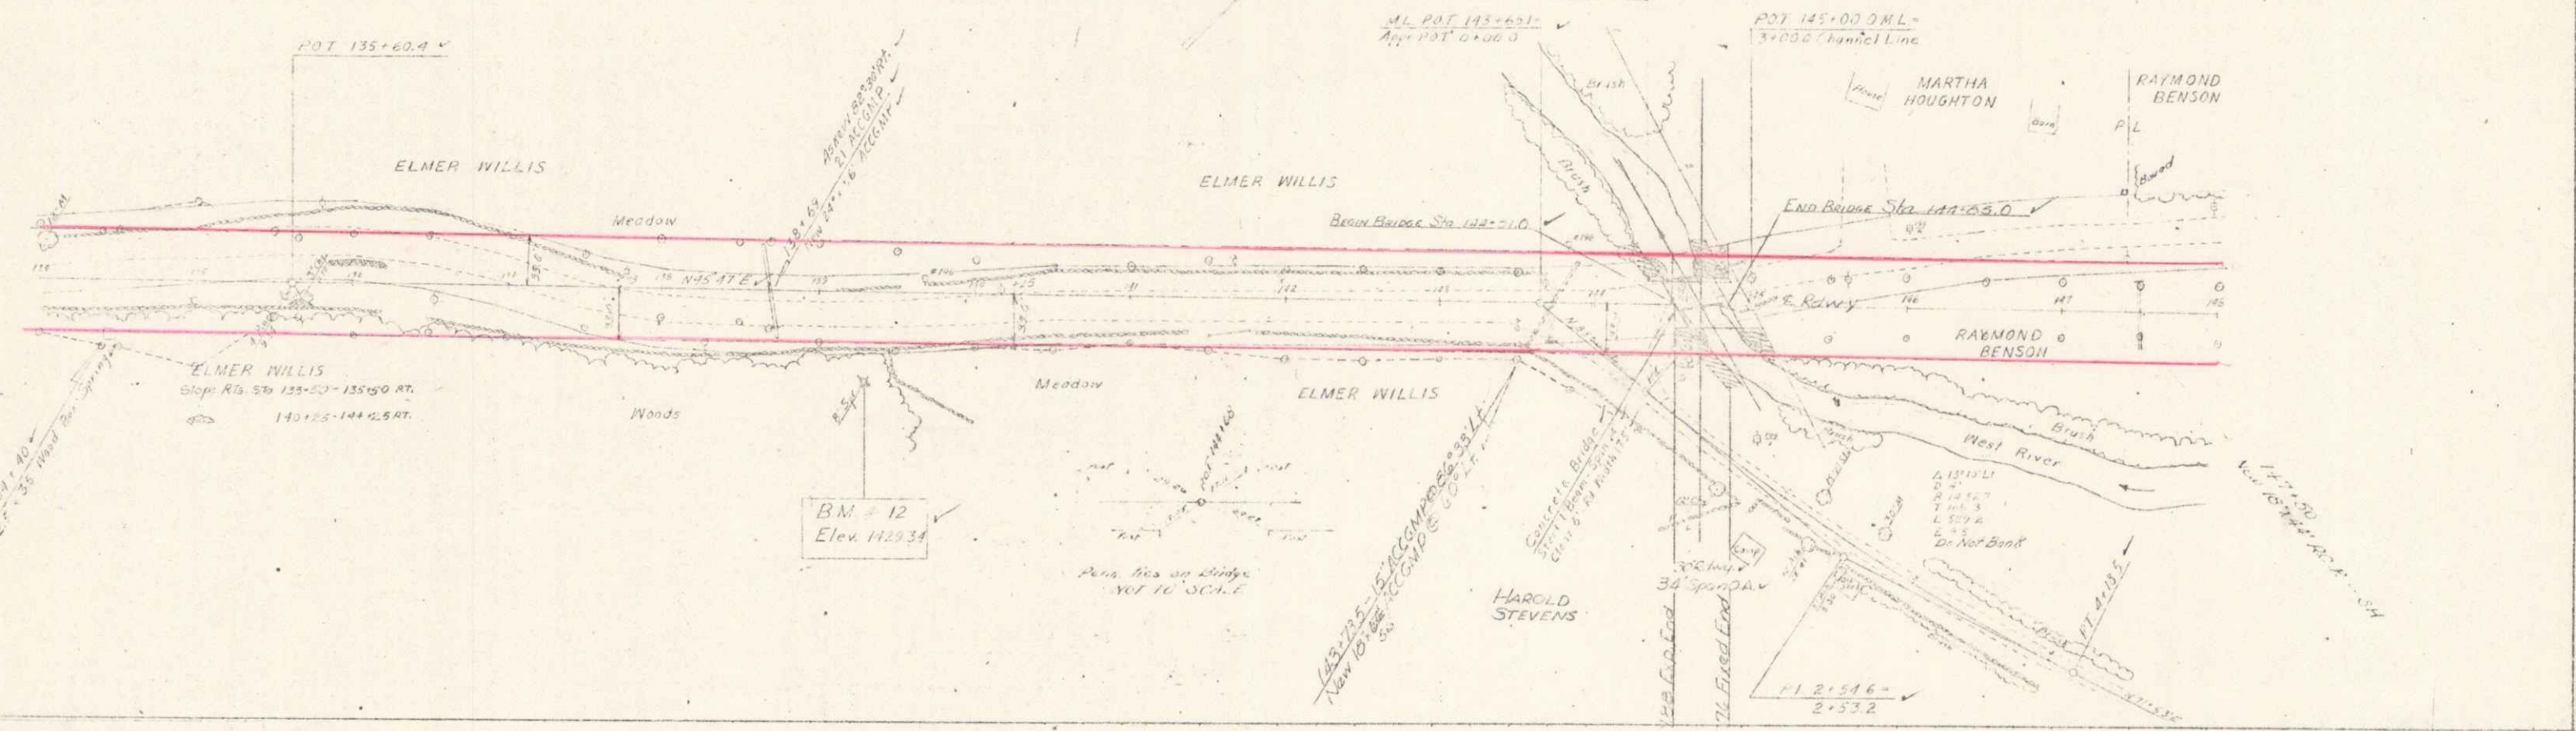

Wood Guide Posts
 LI RT
 154+50 - 161+00 RT
 163+70 - 164+00 RT

Construct Drives
 LI RT
 153+00 - 154+25

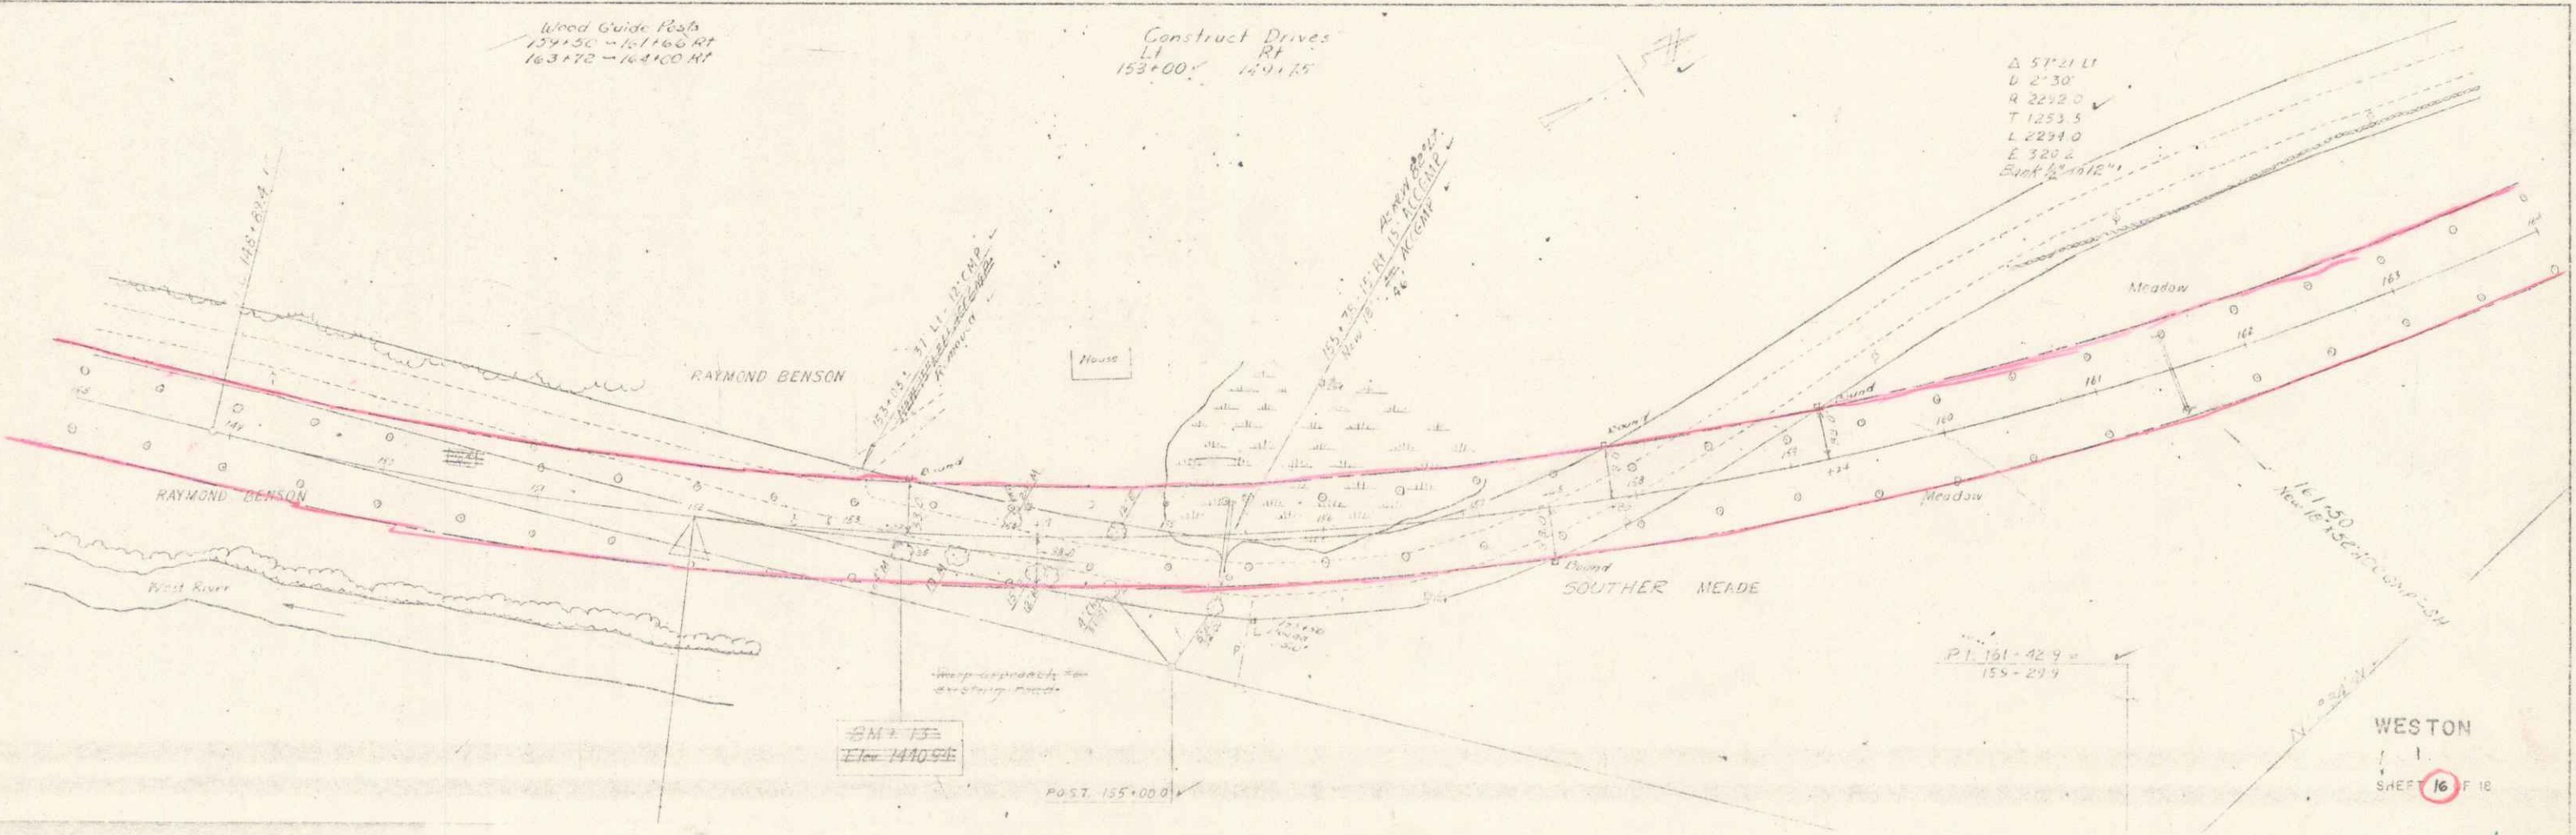

WESTON
 SHEET 16 OF 16